


#14070

036-A

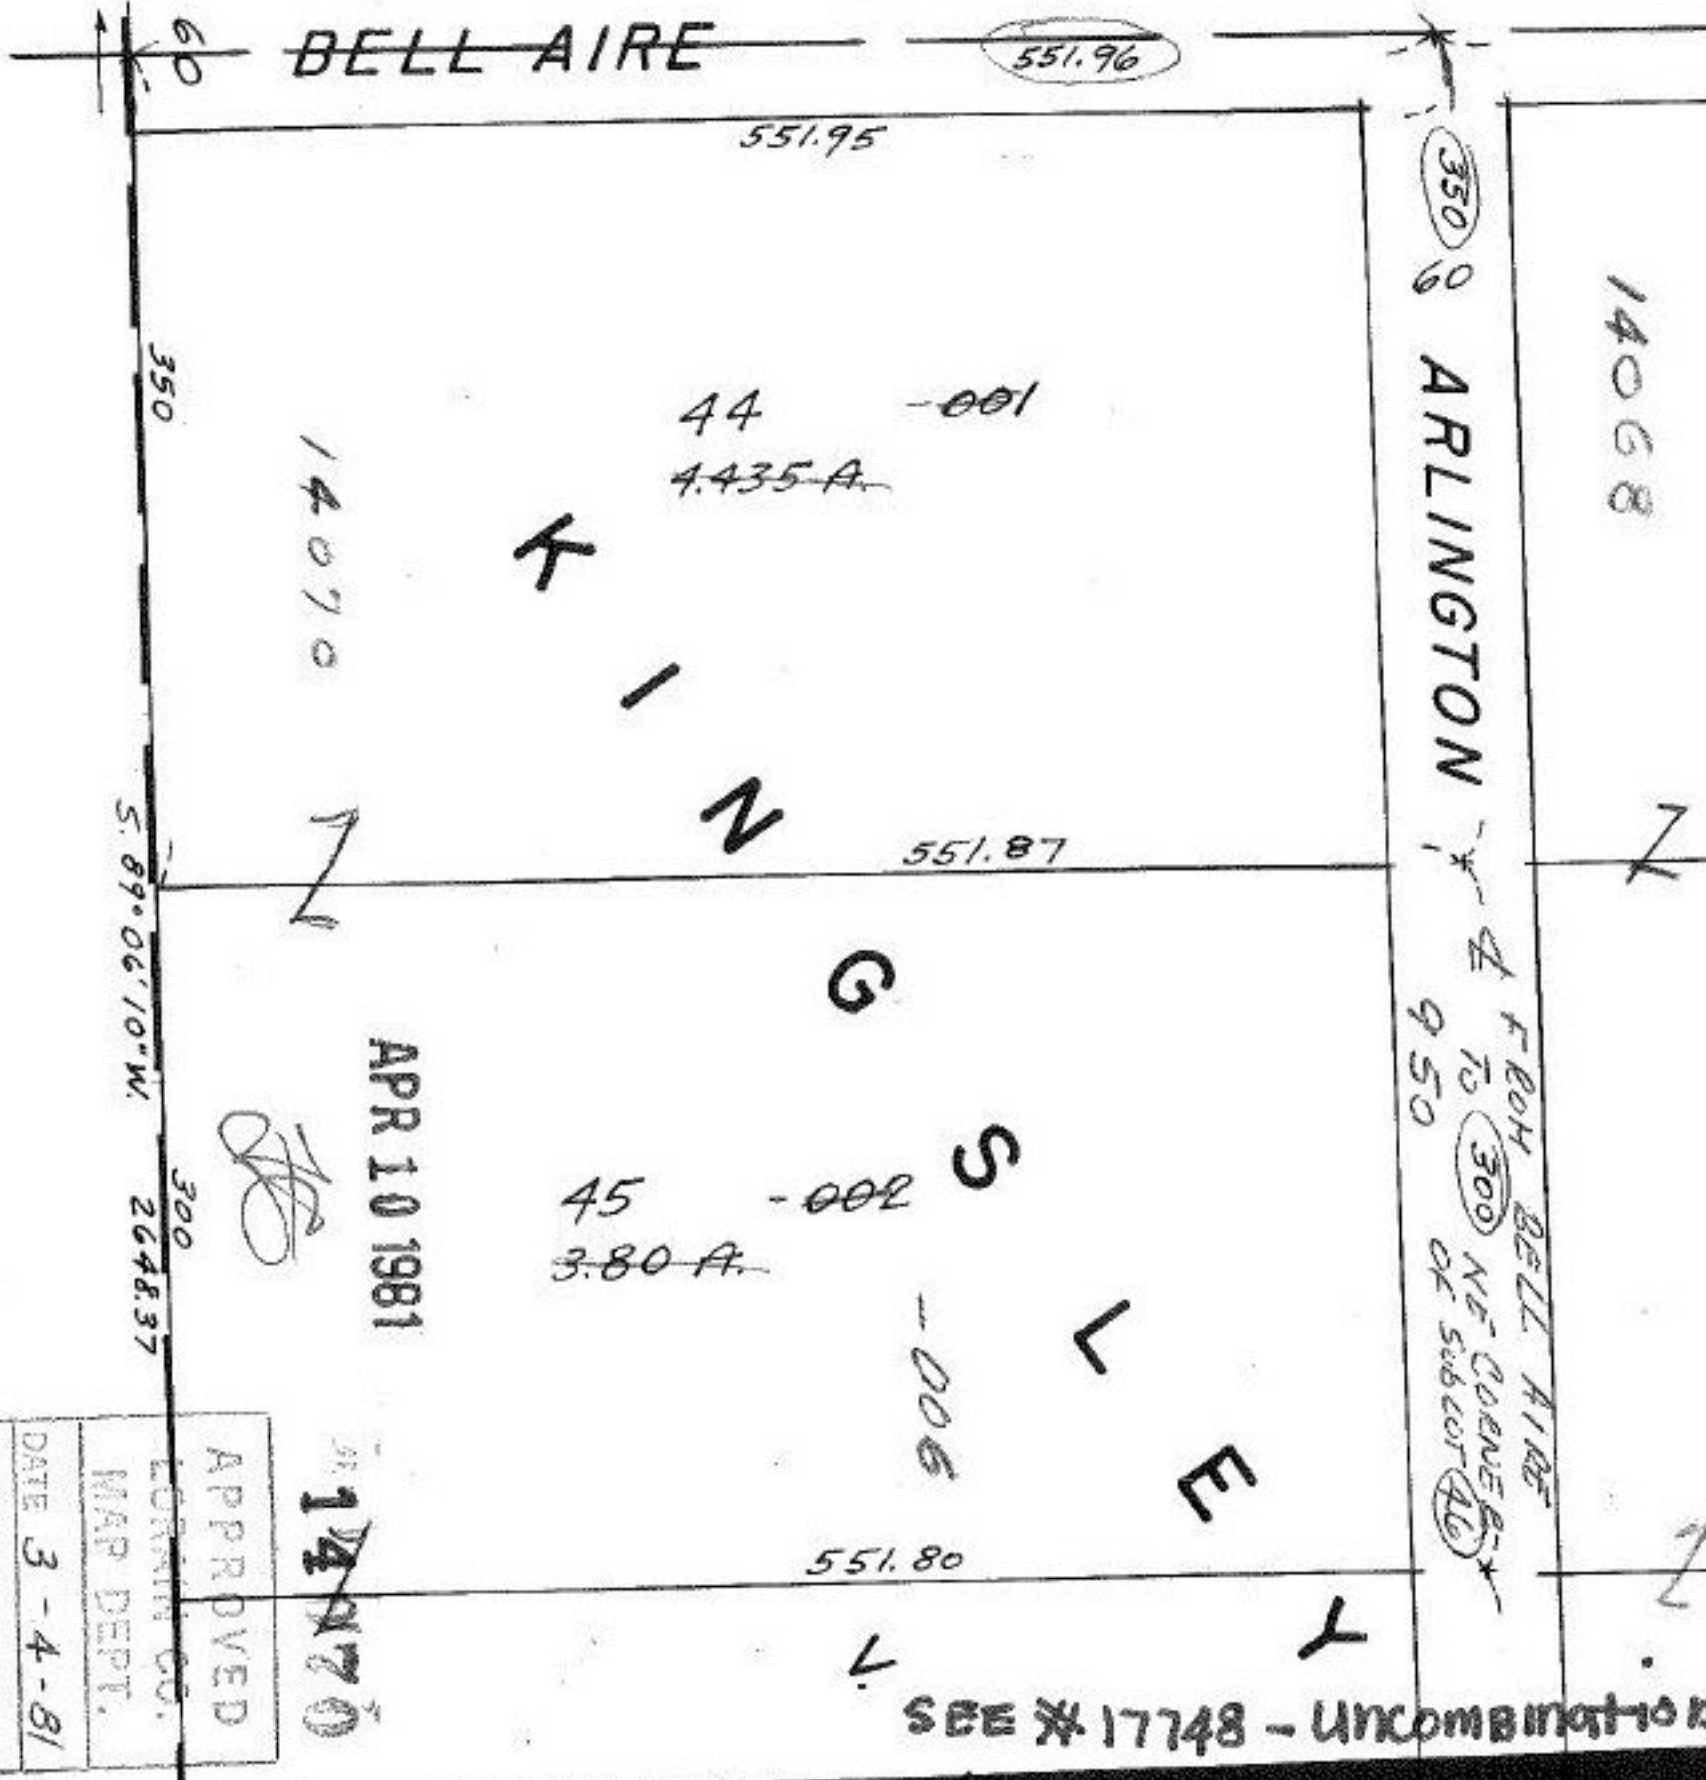

APPROVED	
LOAN CO.	
MAP DEPT.	
DATE	3 - 4 - 81
PAGE	16-00 - 036-B
BY	<i>[Signature]</i>
VOID AFTER	14070