


SEE

SEE

#14082

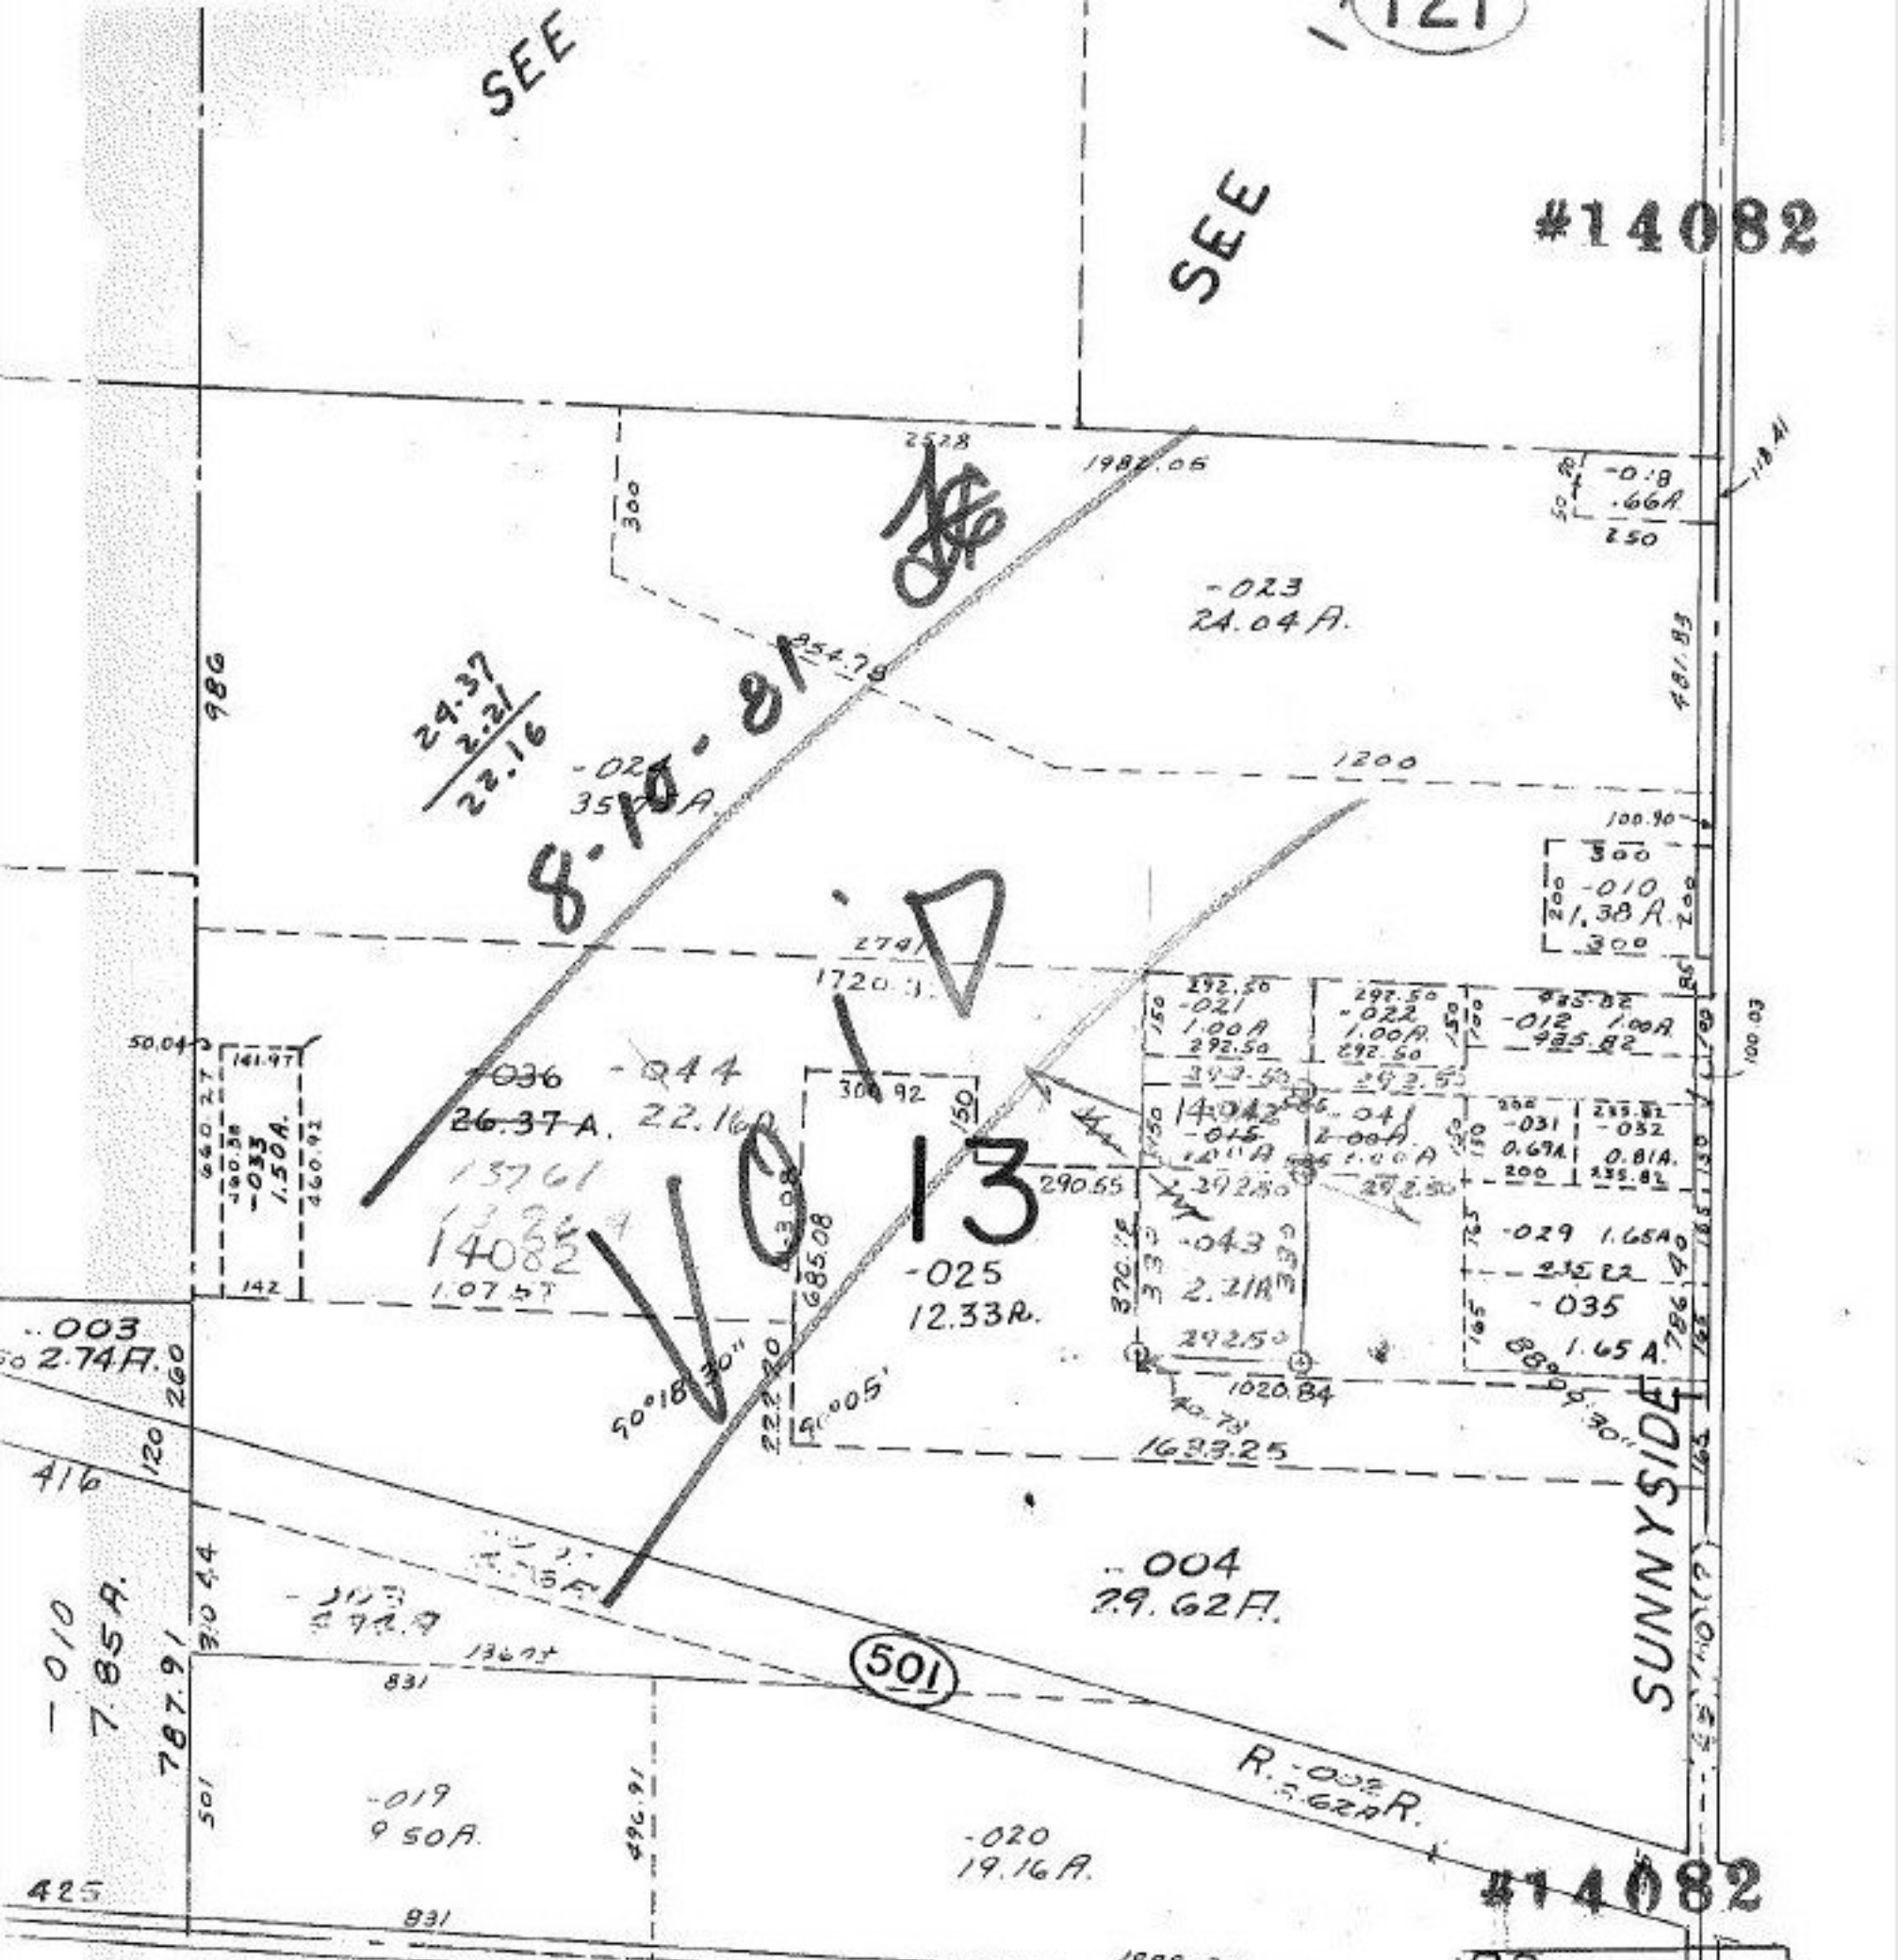

RD APPROVED	
LORAIN CO. MAP DEPT.	
DATE 3-11-81	
PAGE 1-B	
BY <i>Carolyn J</i>	
VOID AFTER	14082

ND