


#14090

CORRECTION

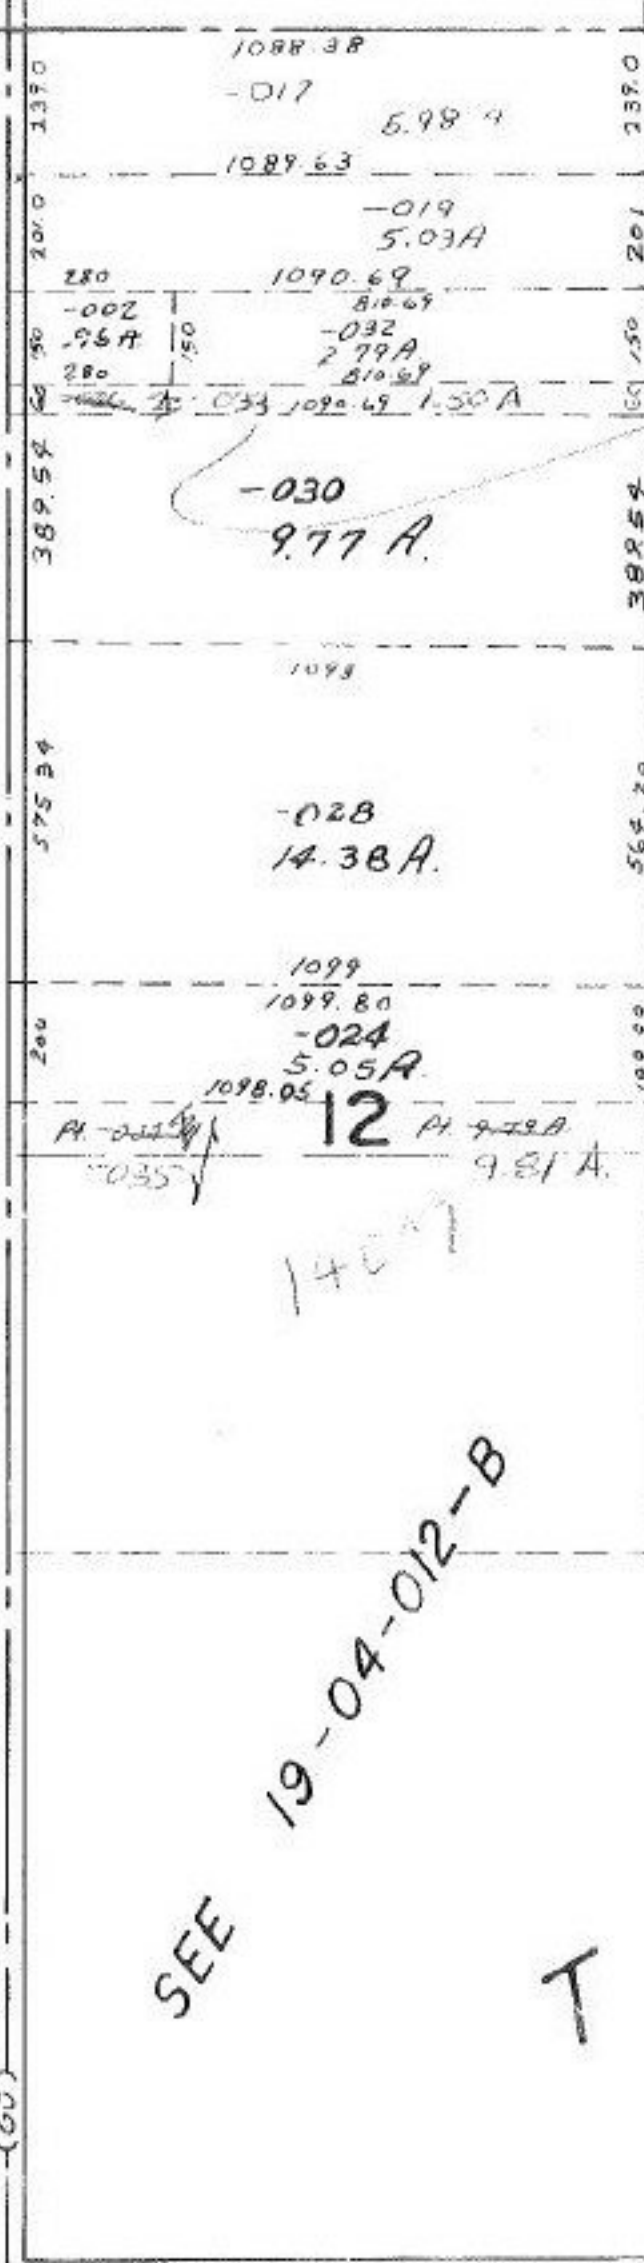

-011  
53.04A

THIS -035 WAS CREATED BY SPLIT #8793 BUT WAS NEVER PUT ON MAP. -036 IS ~~STILL~~ WAS ASSIGNED BUT IS NOW BEING DROPPED FROM DUPLICATE & -033 IS

BEING RESTORED. THE LAND FOR -036 NEVER EXISTED.

#14090

APPROVED  
LORAIN CO.  
MAP DEPT.  
DATE 3-17-81  
PAGE 19-C  
BY T. McNamee  
VOID AFTER

APR 24 1981

T.M. 58.57A

9

10

C

INDIAN

(X)

LATTASBURG - ELYRIA

MEDINA - NORWALK

DENFIELD TWP

18

301