


Acreages Correction

#14121

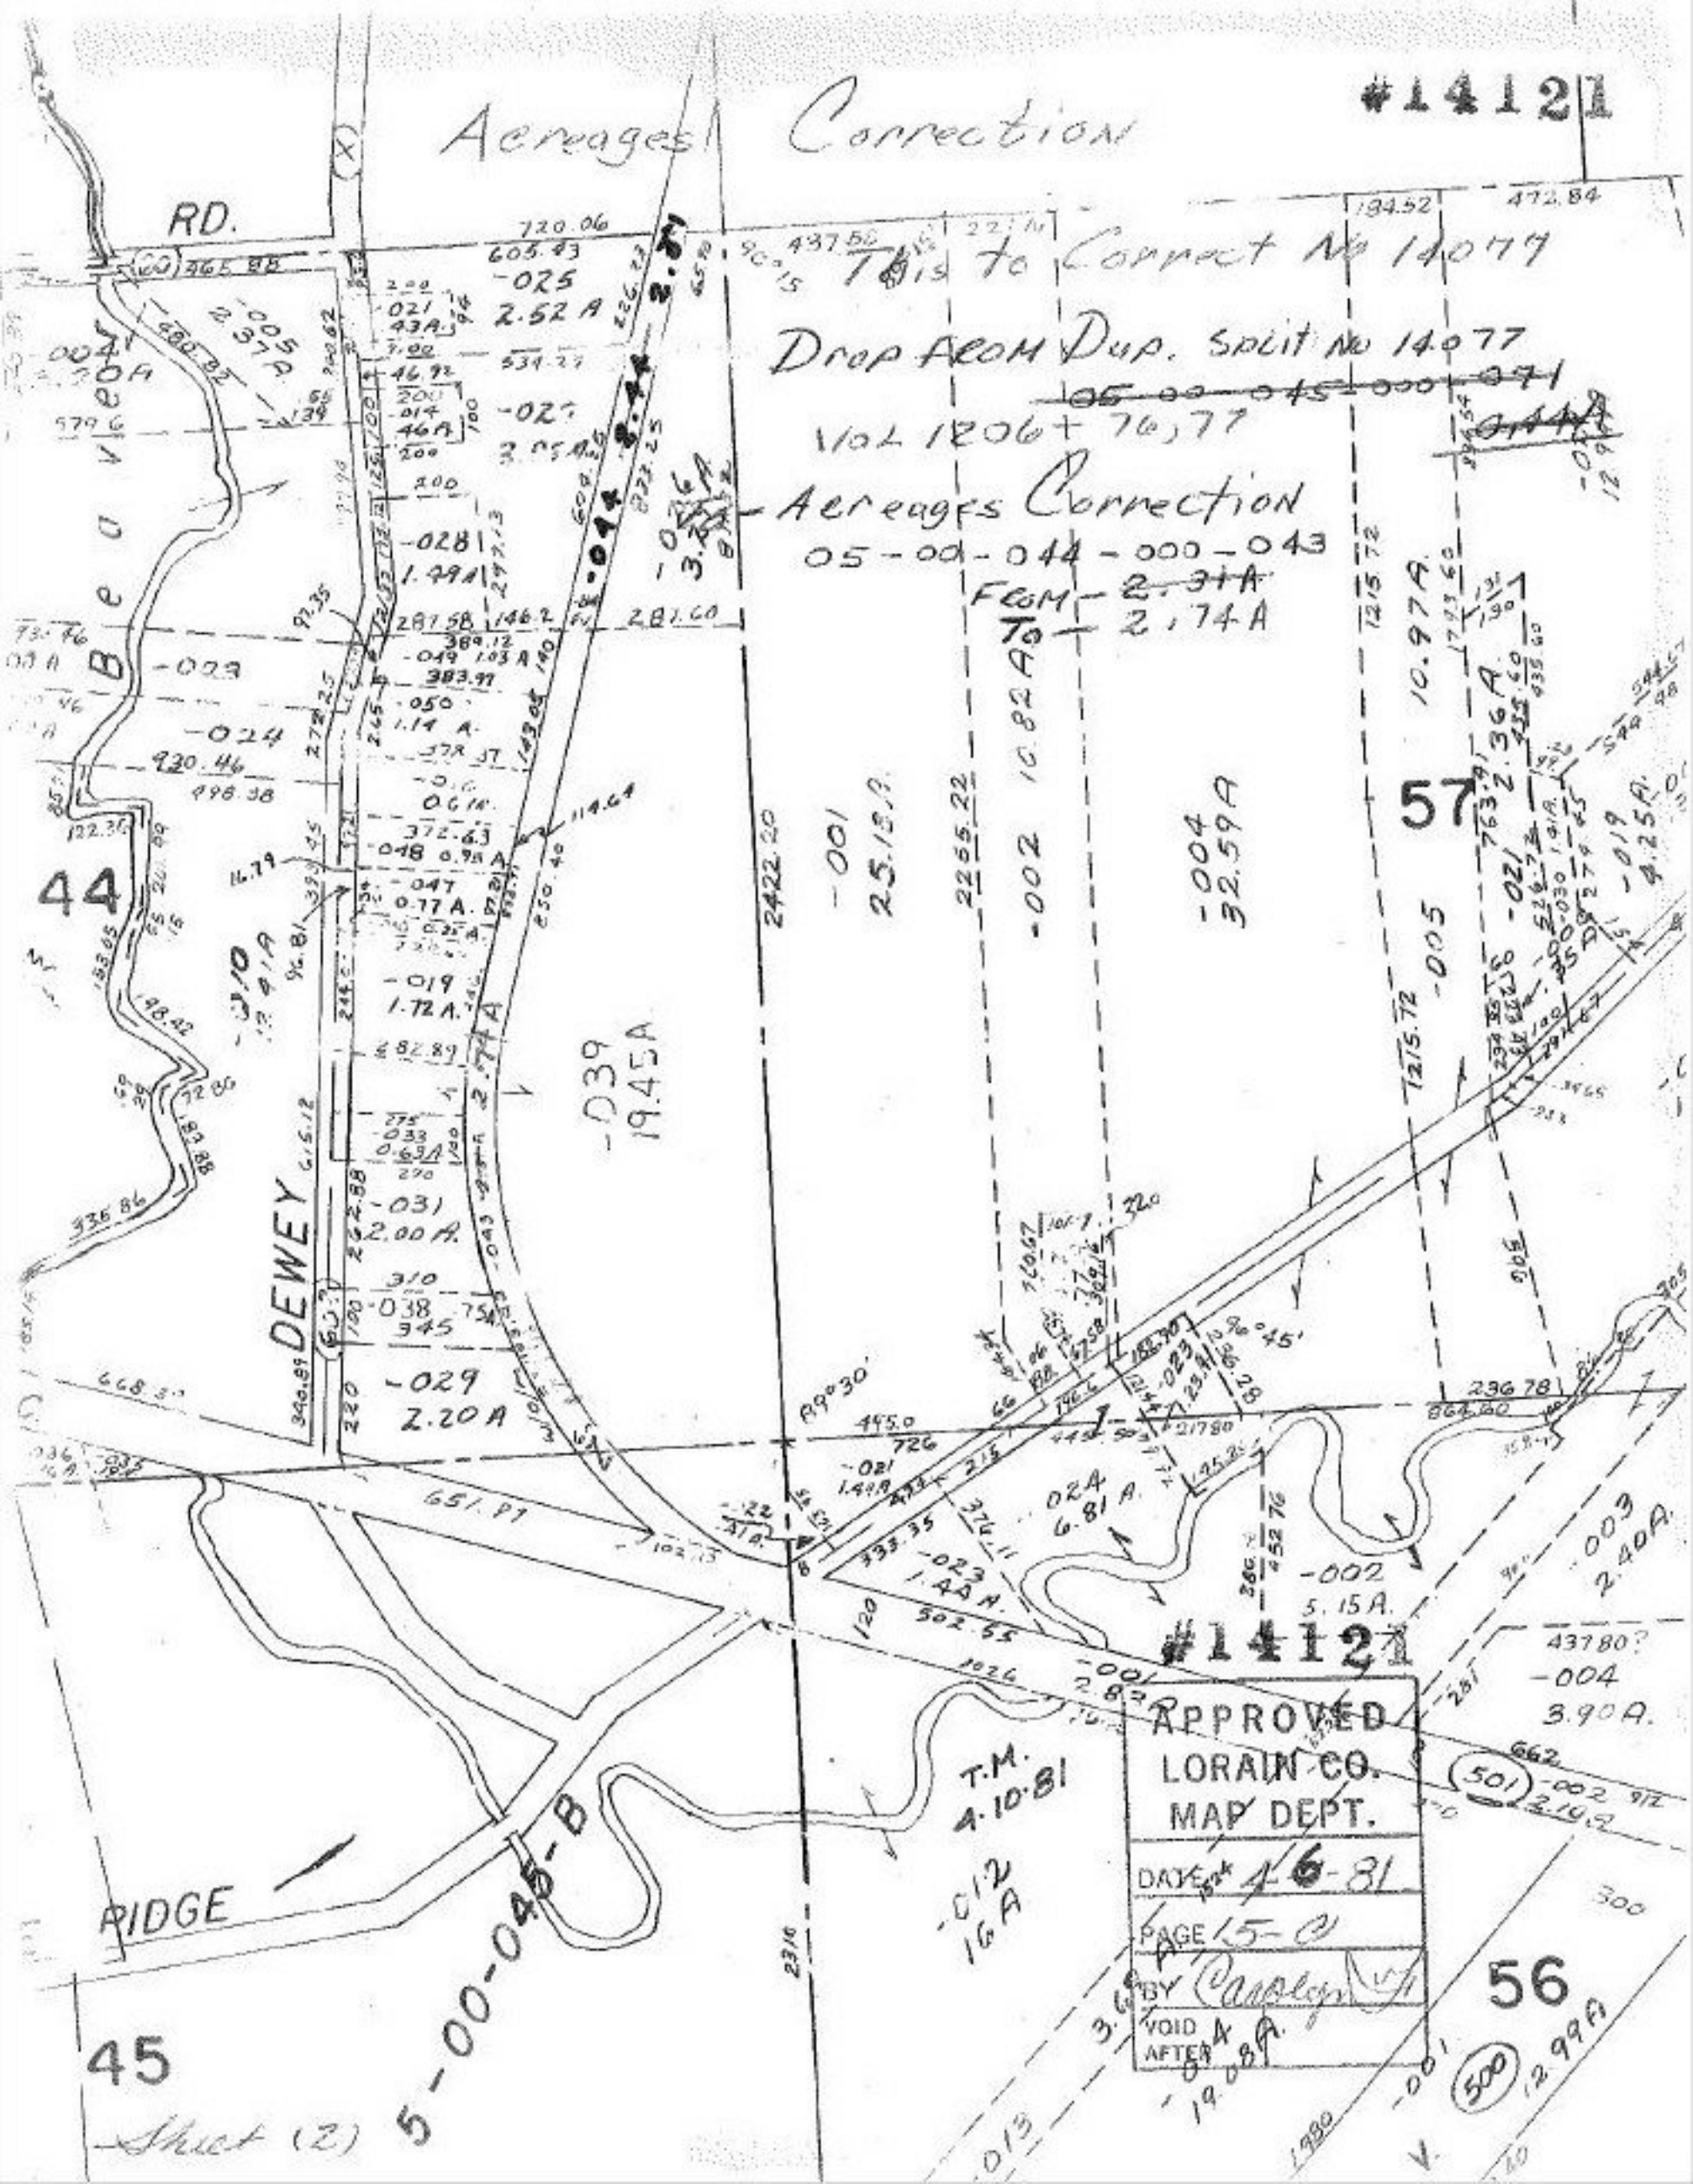

This to correct No 14077

Drop from Dup. Split No 14077

Vol 1206 + 76,77

Acreages Correction

05-00-044-000-043

FROM 2.31 A

TO 2.74 A

DEWEY

BEDVIEW

RIDGE

T.M. 4-10-81

APPROVED LORAIN CO. MAP DEPT.

DATE 4-6-81

PAGE 15-2

BY [Signature]

VOID AFTER 1908

45

5-00-045-B

56

500

Sheet (2)