



#14121  
#13340

SEE

SEE

Acres

Error Made in Split 11563  
This is to Correct Acres in Split  
11563 - 043 FROM 2.74A TO 2.74A  
13340 - 053 FROM 1.32A TO 0.87A  
Acres Correction  
ACKERMAN ONLY RD.

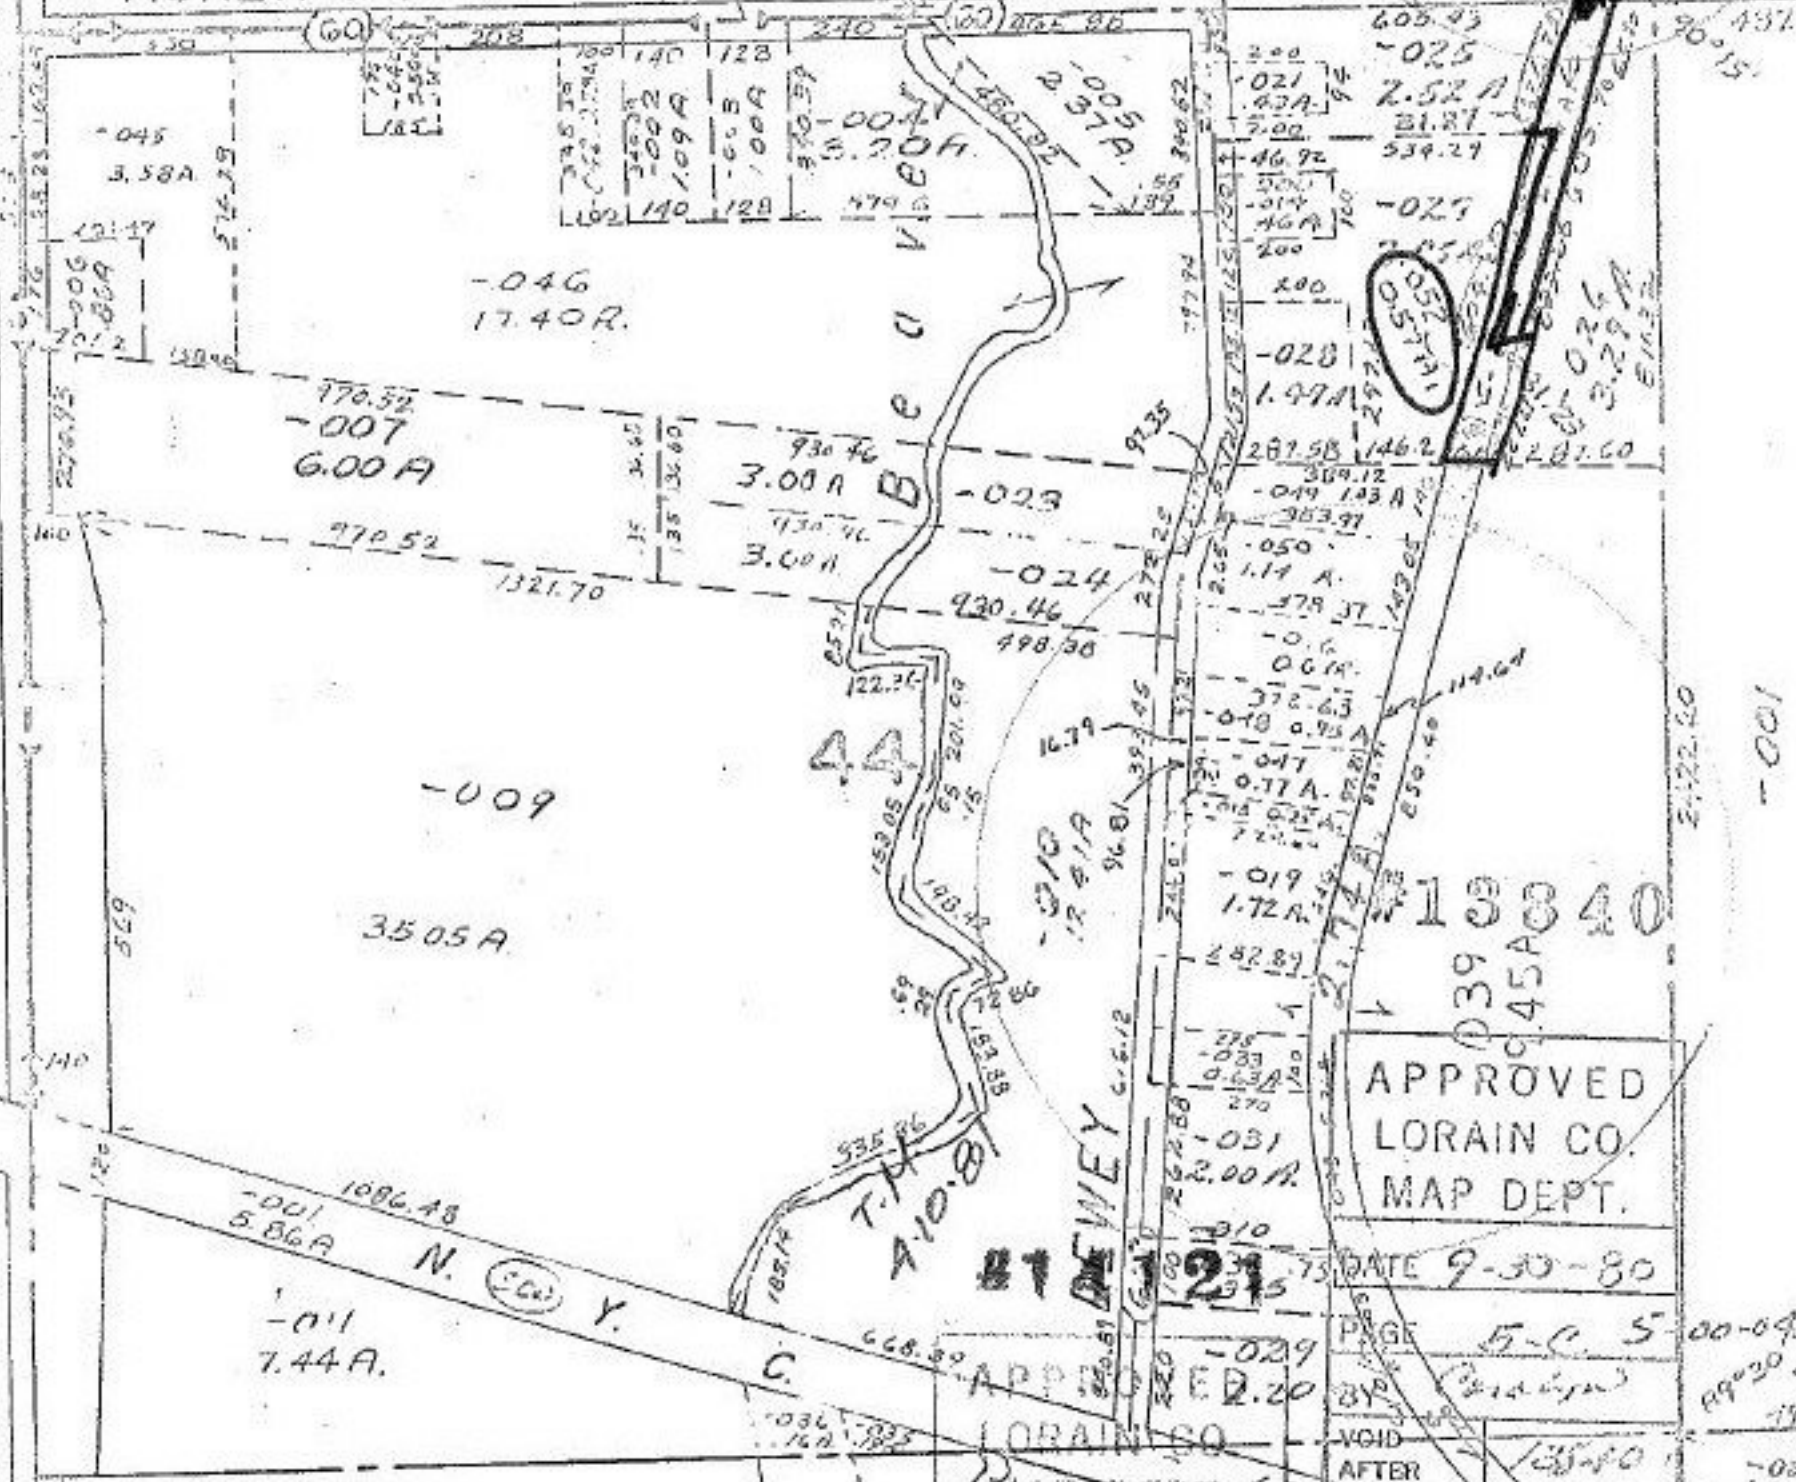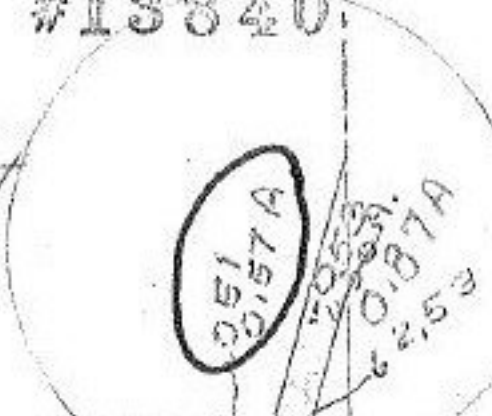

Transfer  
Sheet 3 & 4

APPROVED	DATE 9-30-80
LORAIN CO. MAP DEPT.	PAGE 5-C 5
BY Carolyn	VOID AFTER
DATE 4-6-31	VOID AFTER
PAGE 5-C 5-B	
BY Carolyn	
VOID AFTER	

45-A