


408.27

80

125  
OSBORNE

10.56

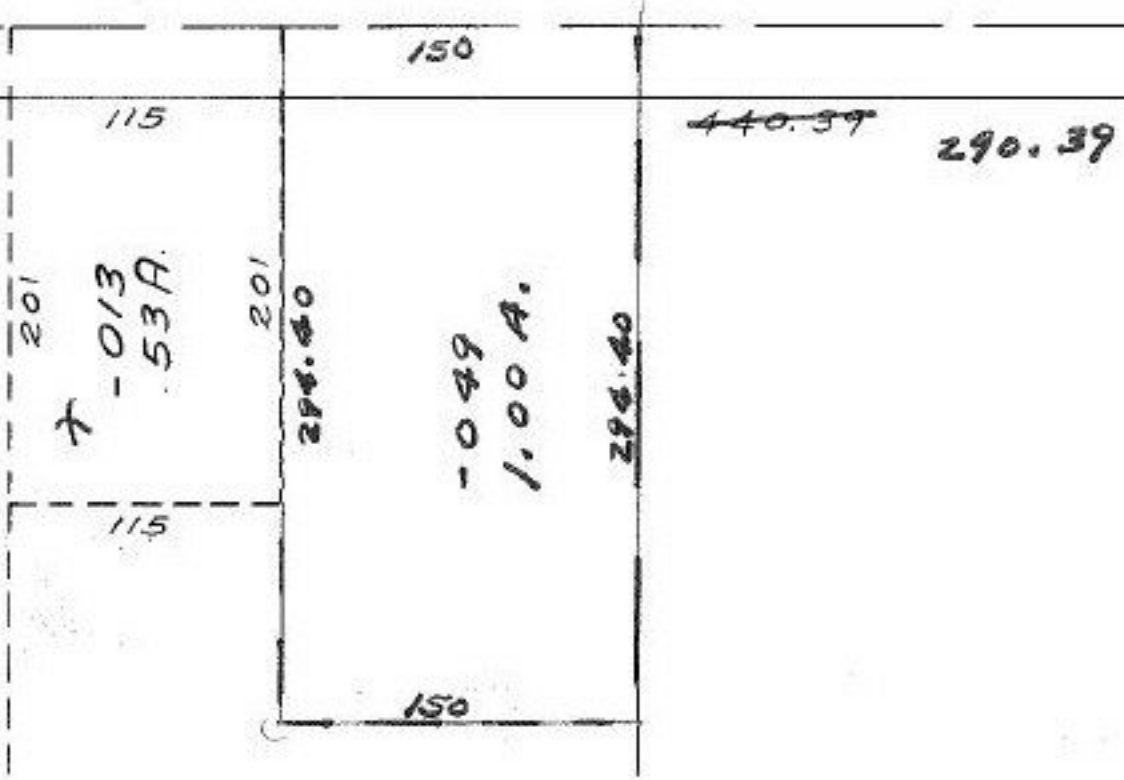

#14125

APPROVED
LORAIN CO.
MAP DEPT.
DATE 4-6-81
PAGE 12-00-042A
BY <i>Flourey</i>
VOID AFTER

T.M.  
4.23.81

-012  
7.23A

1405.14

$$\begin{array}{r} 440.39 \\ 150 \\ \hline 290.39 \end{array}$$

-050

14125

-014

-1740A

16.40 Ac.

1403.16  
1405.25