

SE

57

#14132 384.69

216
0.63


364.70

-2.20
1.03A

233.12
207.79

HYANIS
201.79

233.12

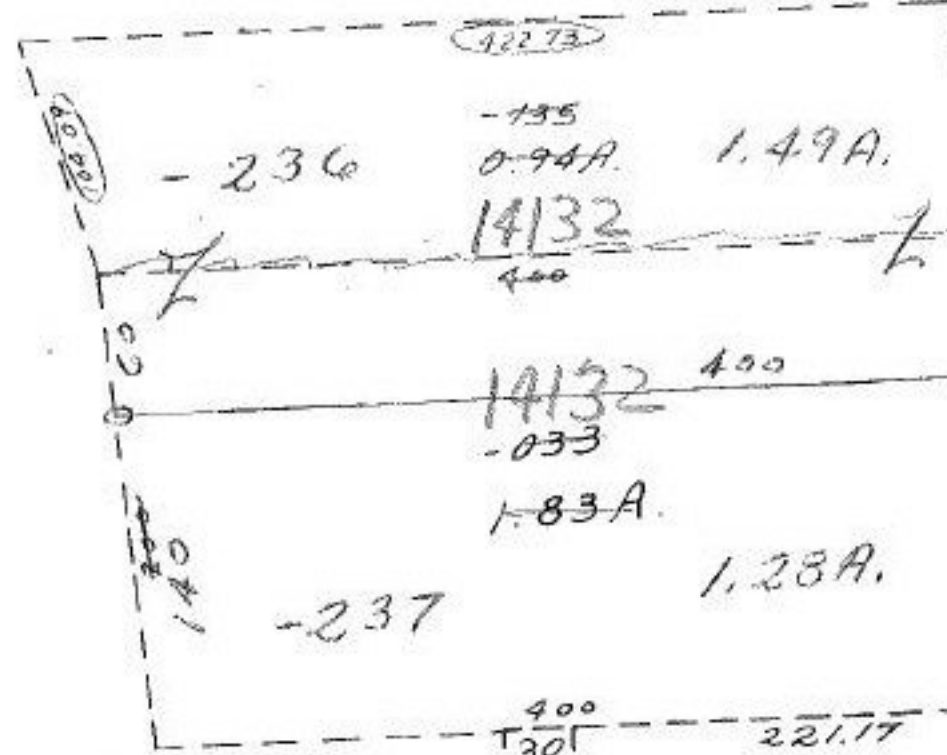

#14132

-006
T.M.
4-25-81

APPROVED
LORAIN CO.
MAP DEPT.

DATE 4-6-81

PLAN H-00-099-1

BY [Signature]
FOR
RECORD

Surveyed by
Leinveder-Schmidt & Assoc.

400
30
337.77
22A
218.35
249.47
50
30
242.38
-228
0.37A
247.91