


SEE 7-00-011-B

- 038  
5.14 A.

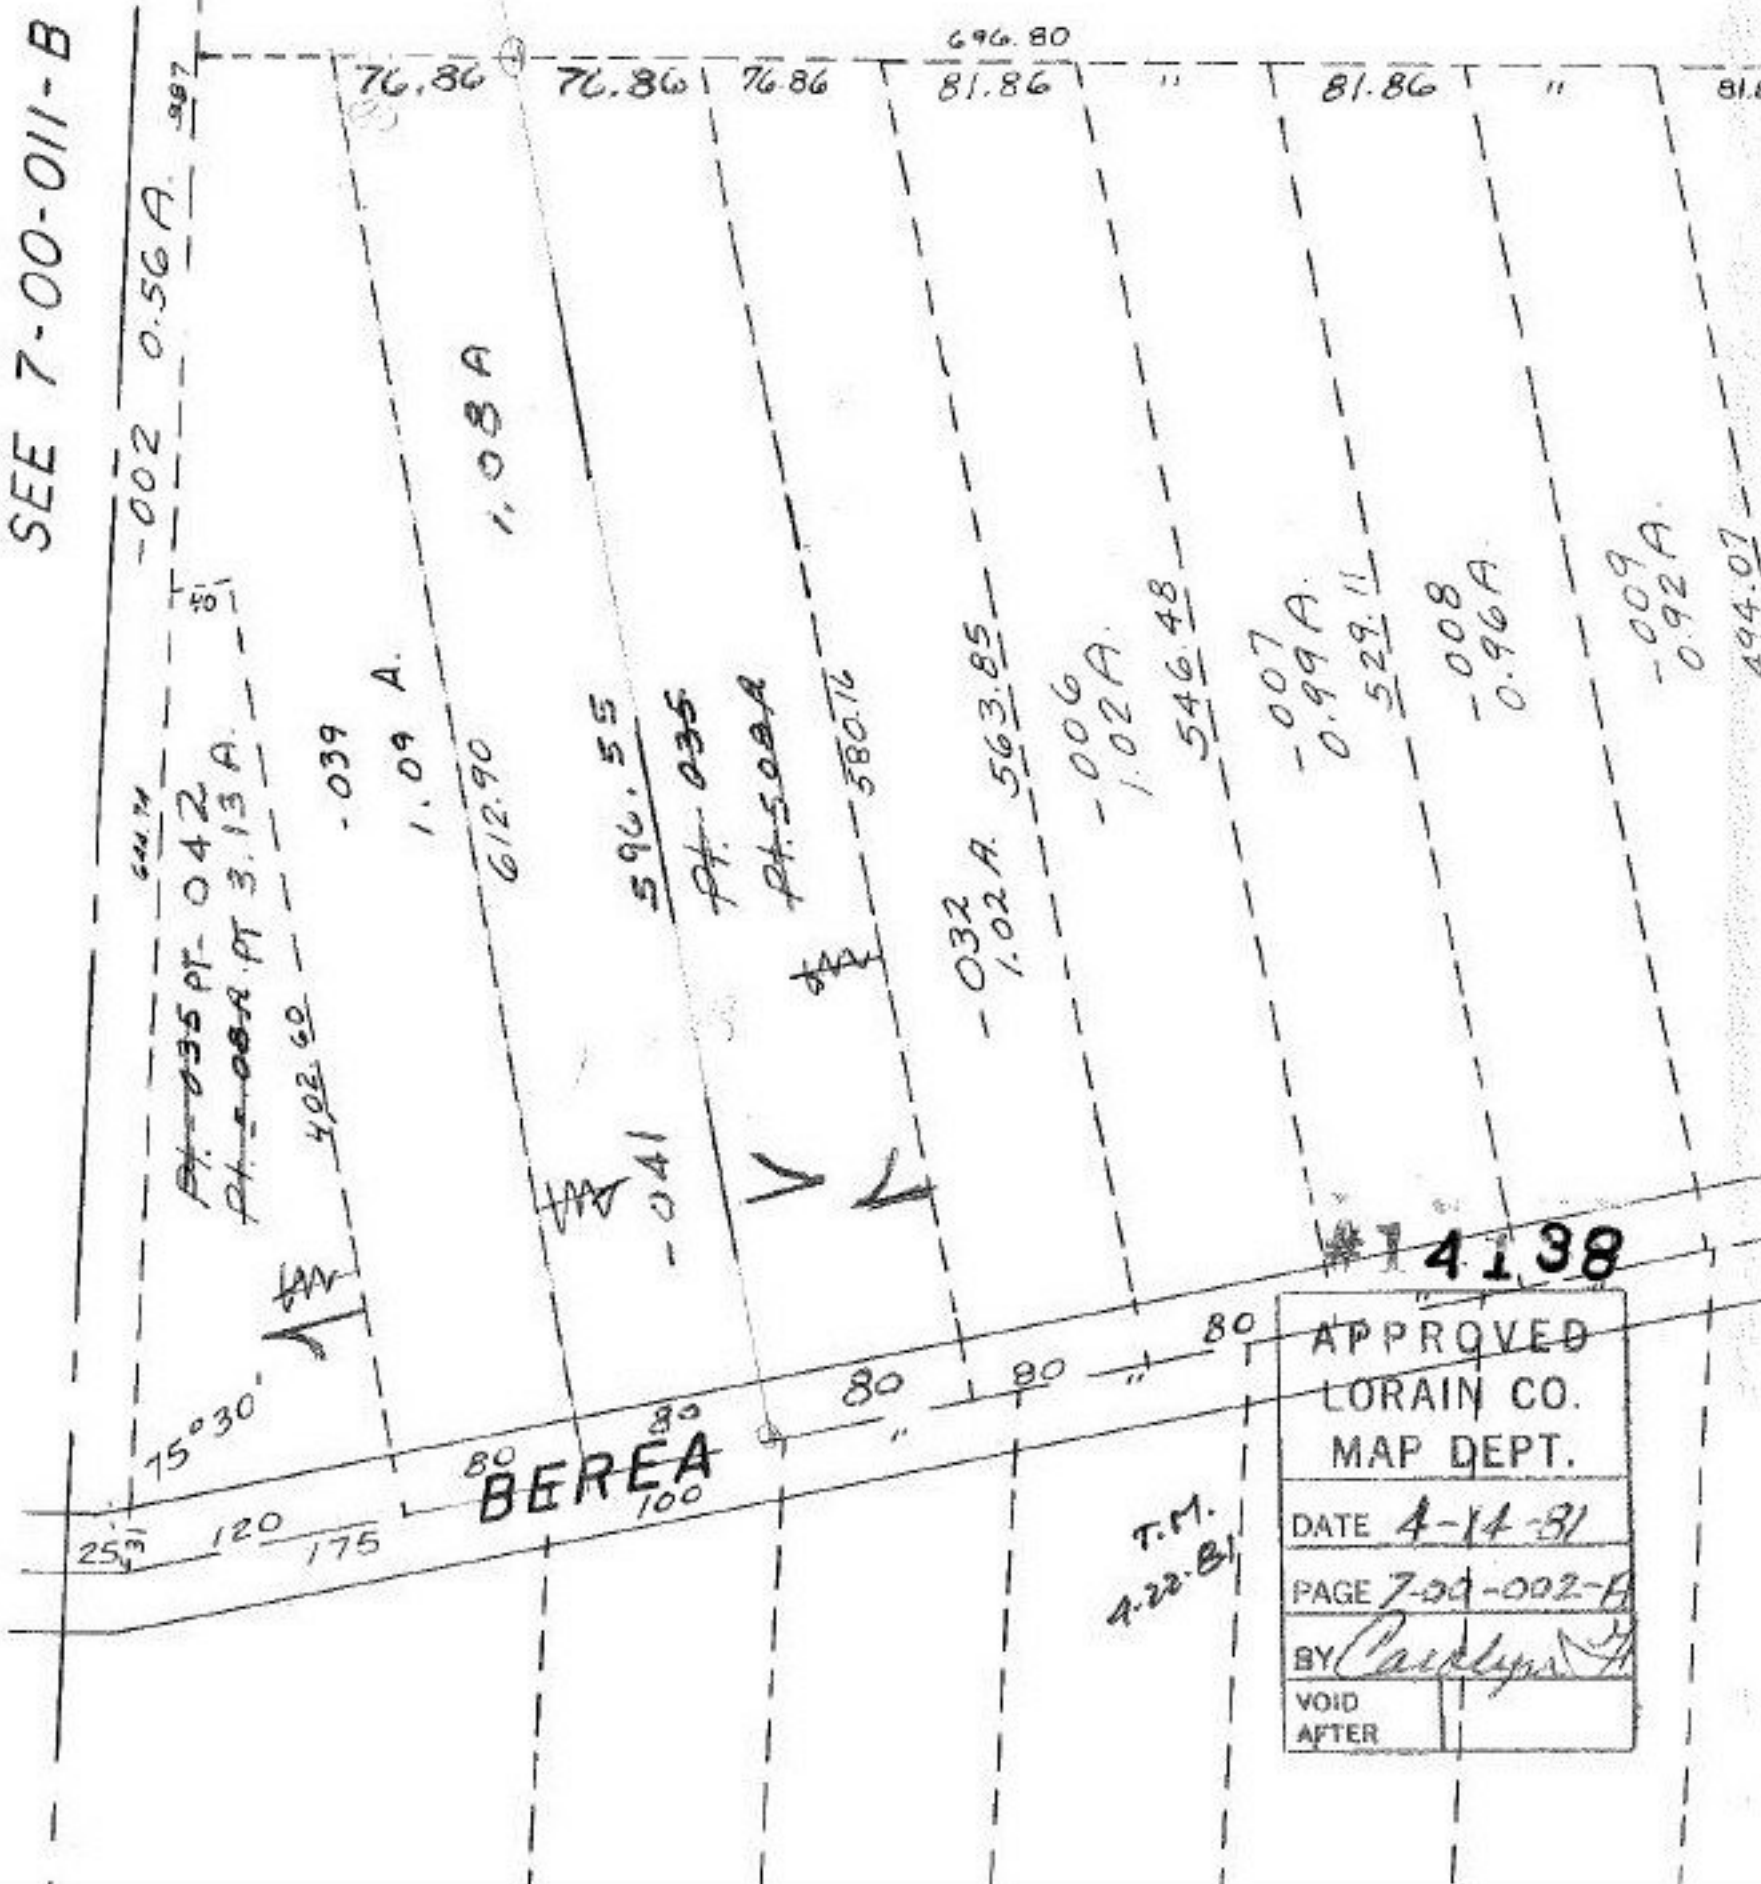

APPROVED	
LORAIN CO.	
MAP DEPT.	
DATE 4-14-31	
PAGE 7-00-002-A	
BY <i>Carlynn</i>	
VOID	
AFTER	

T.M.  
4-22-31

350

494.07

81.86

81.86

