


1089

~~-060~~
17.61 A.
-066
17.20 A.

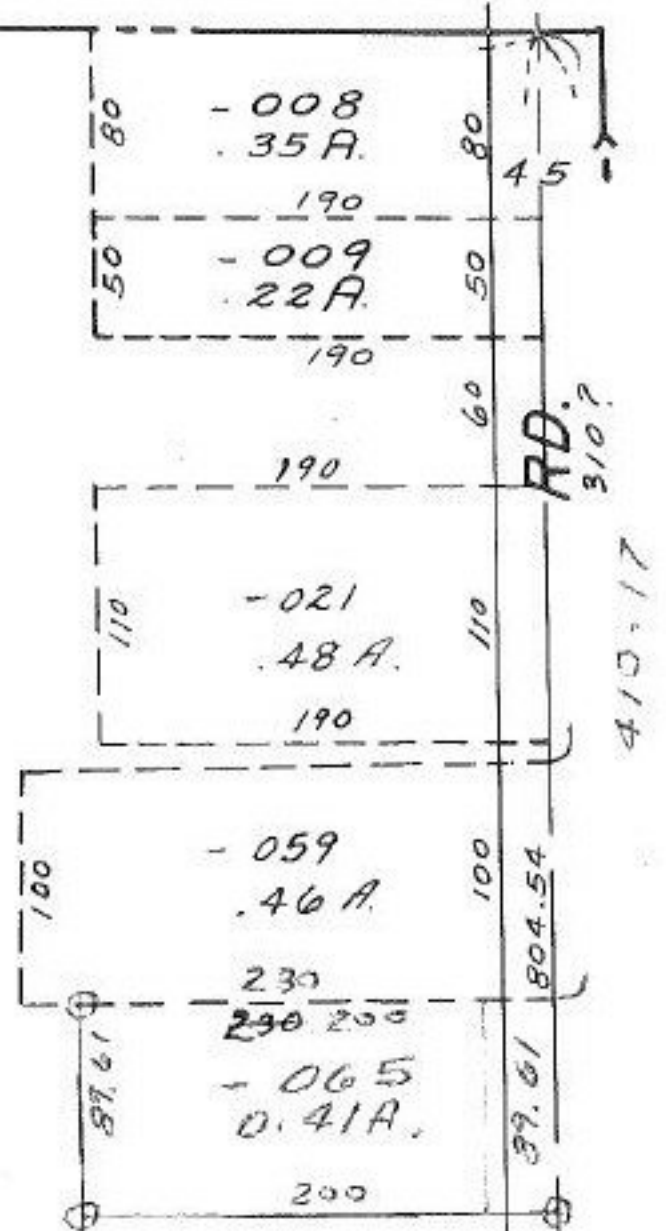

T.M.
A. 23-81

1 -023	APPROVED
	LORAIN CO. MAP DEPT.
2 -024	DATE 4-13-81
	PAGE 10-00-005-A
3 -025	BY <i>Carlynn H</i>
	VOID AFTER 14145

PG. 70 & 71

14145