


580
290
290

Pyle South Amherst
Russia Road

SEE :

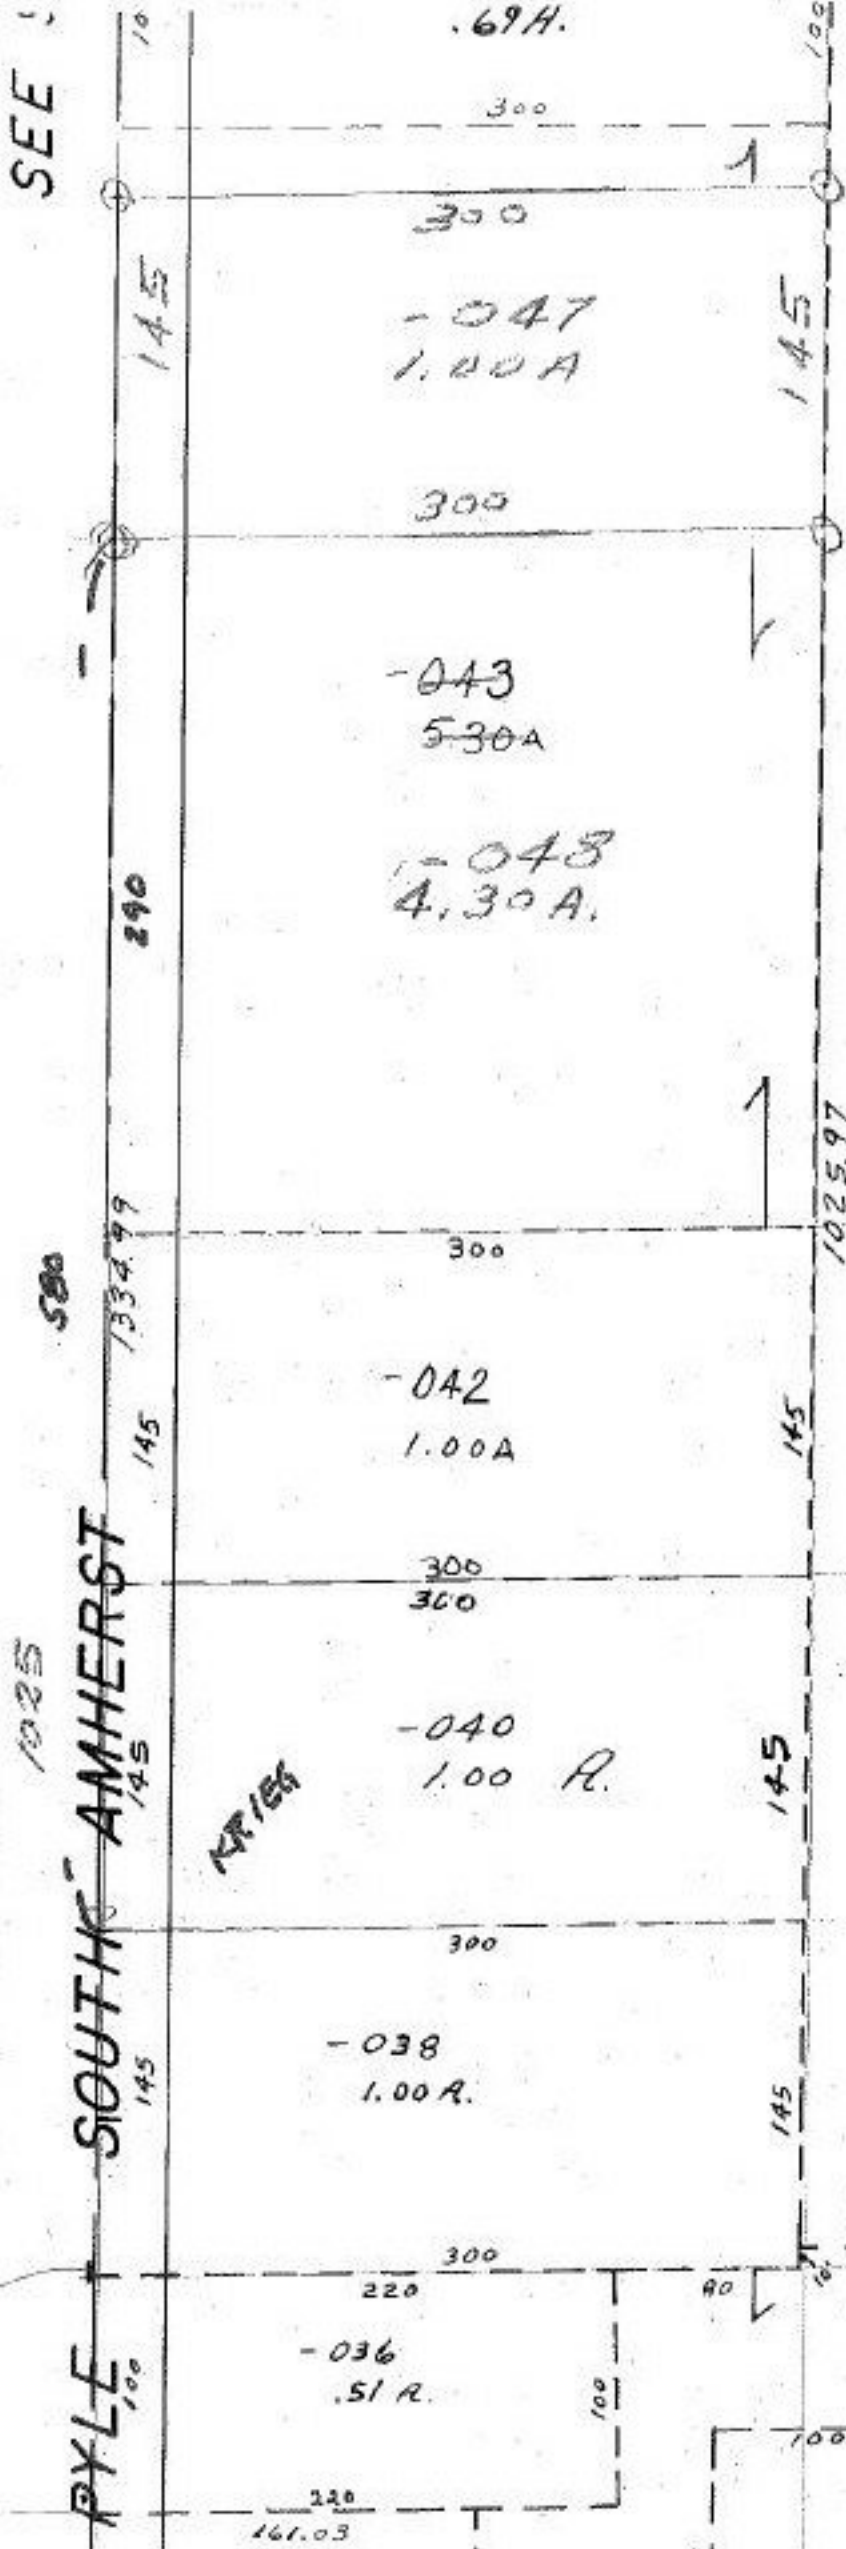

-019
799 A.

#14147

T.M.
4.22.81

APPROVED
LORAIN CO.
MAP DEPT.
DATE 4-14-81
PAGE 9-00-013-B
BY Carolyn S.
VOID AFTER

133414

85

A.

34