


Pt. - 001
Pt. 24.38 F.

48.63

40.84

101

LEAVE IF CONTACT

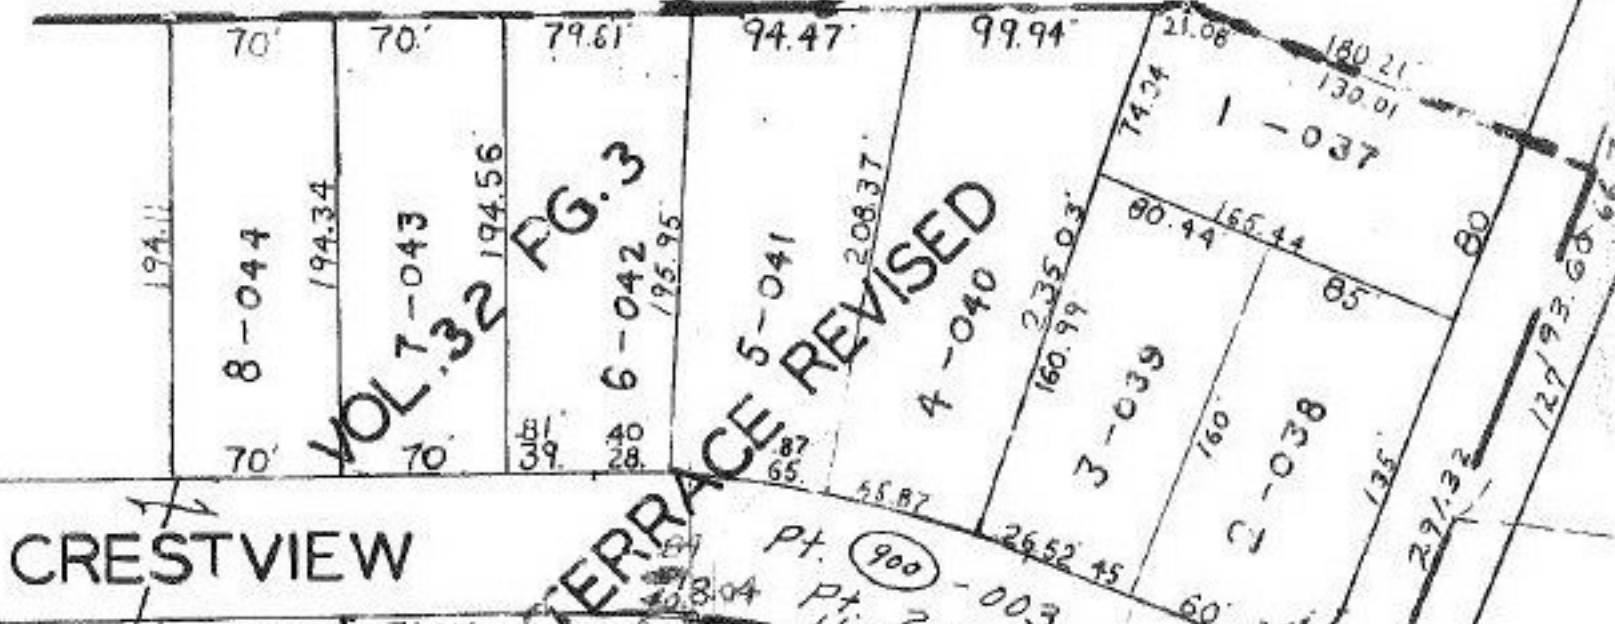


CRESTVIEW

VOL. 32 PG. 3
CHATHAM TERRACE REVISED


Pt. 900 - 003
Pt. 2 - 64A DR. 60'
-022 .30A.
-023 1.35A.

105

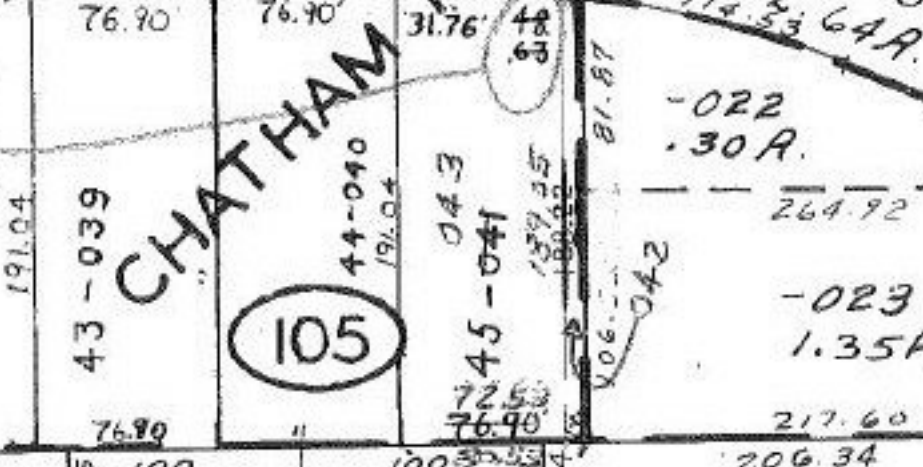

102

VALLEY ESTATES VOL 19 PG 2

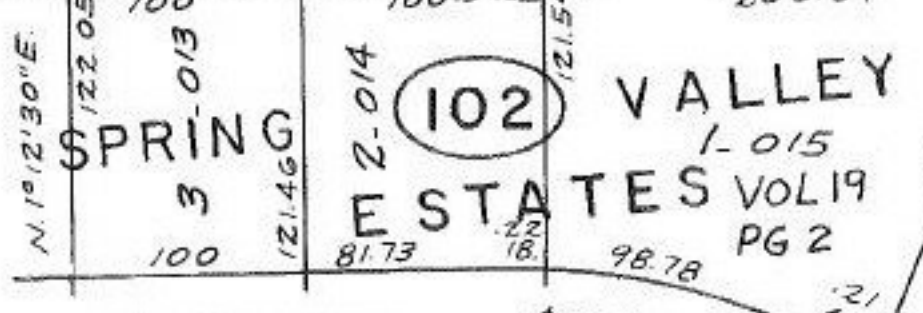


NOTTINGHAM

DR. 260

APPROVED
LORAIN CO.
MAP DEPT.
DATE 4-20-81
PAGE 6-33
BY Carolyn
VOID AFTER 007

104

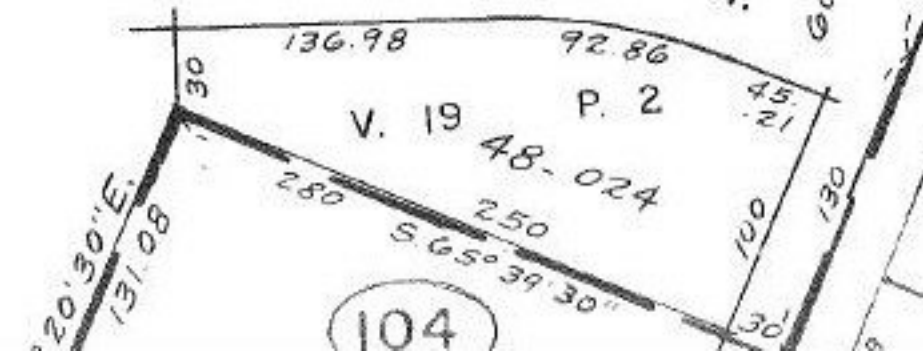

31.76
48.63
80.39
80.64
FRONTAGE

76.90 ?
BACK