


COMBINATION

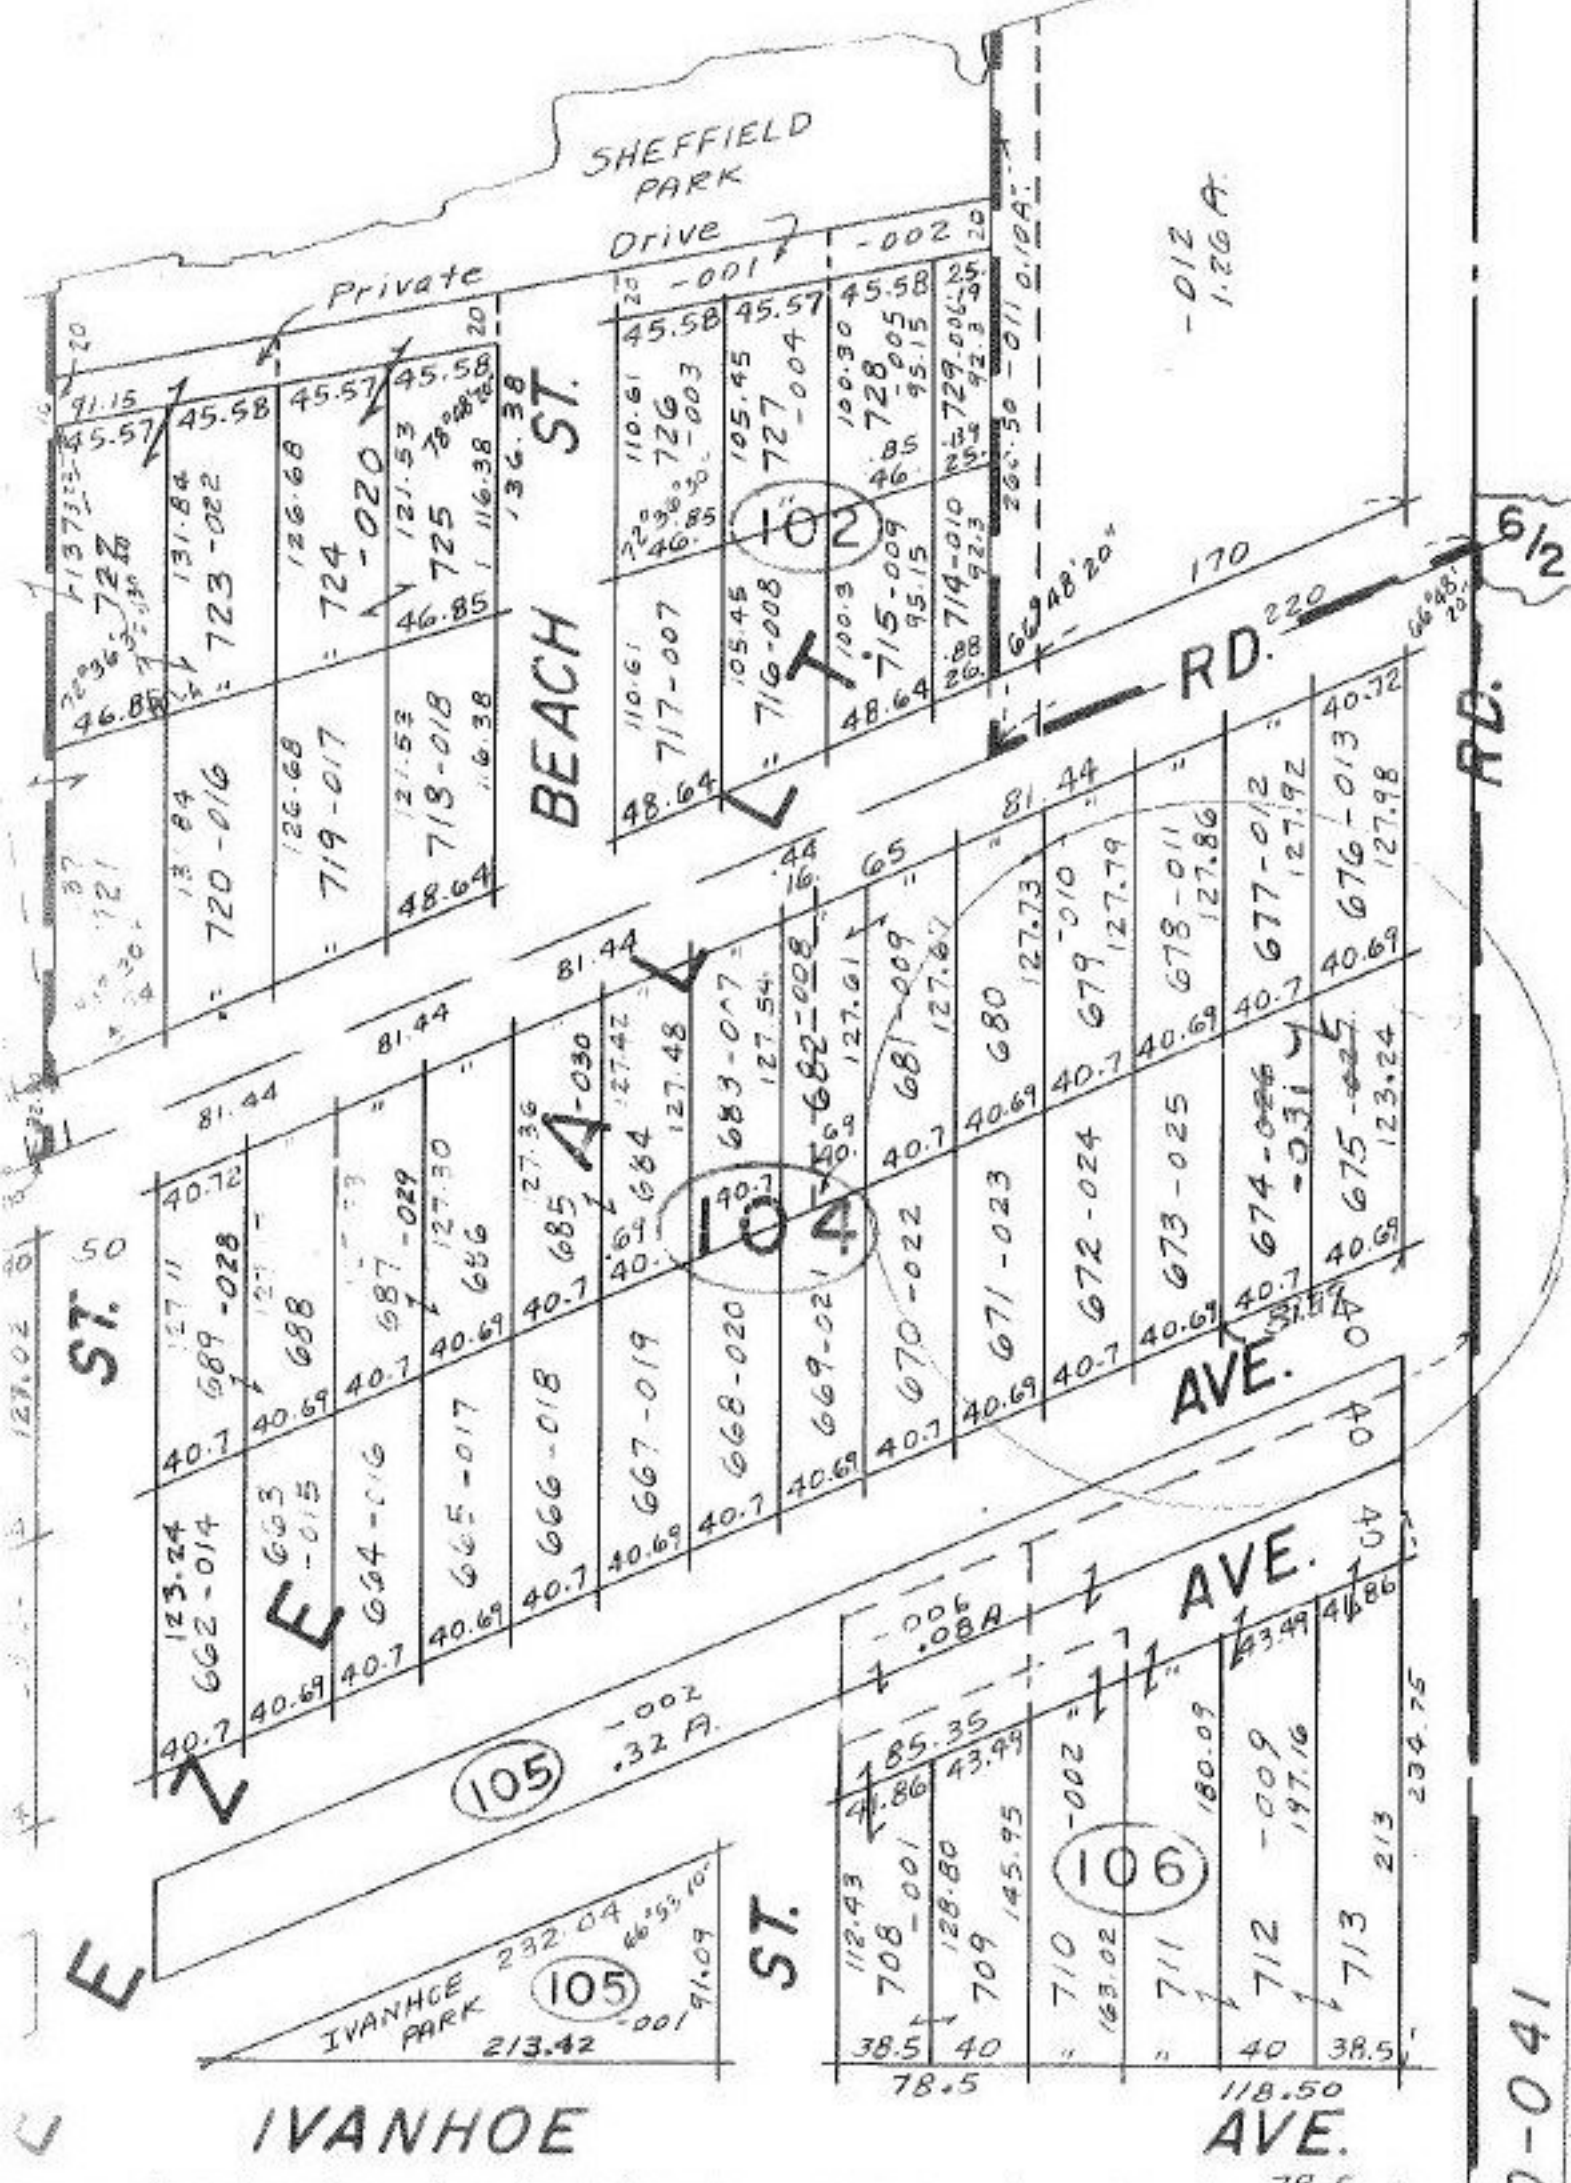

T.M.
1.6.82

#14161

APPROVED
LORAIN CO.
MAP DEPT.
DATE 4-21-81
PAGE 3-00-042-A
BY <i>C. C. ...</i>
VOID AFTER

-00-041