


#14168

APPROVED LORAIN CO. MAP DEPT.	
DATE	4-27-81
PAGE	4-00-018-B
BY	<i>[Signature]</i>
VOID AFTER	

APR 27 1981

[Signature]

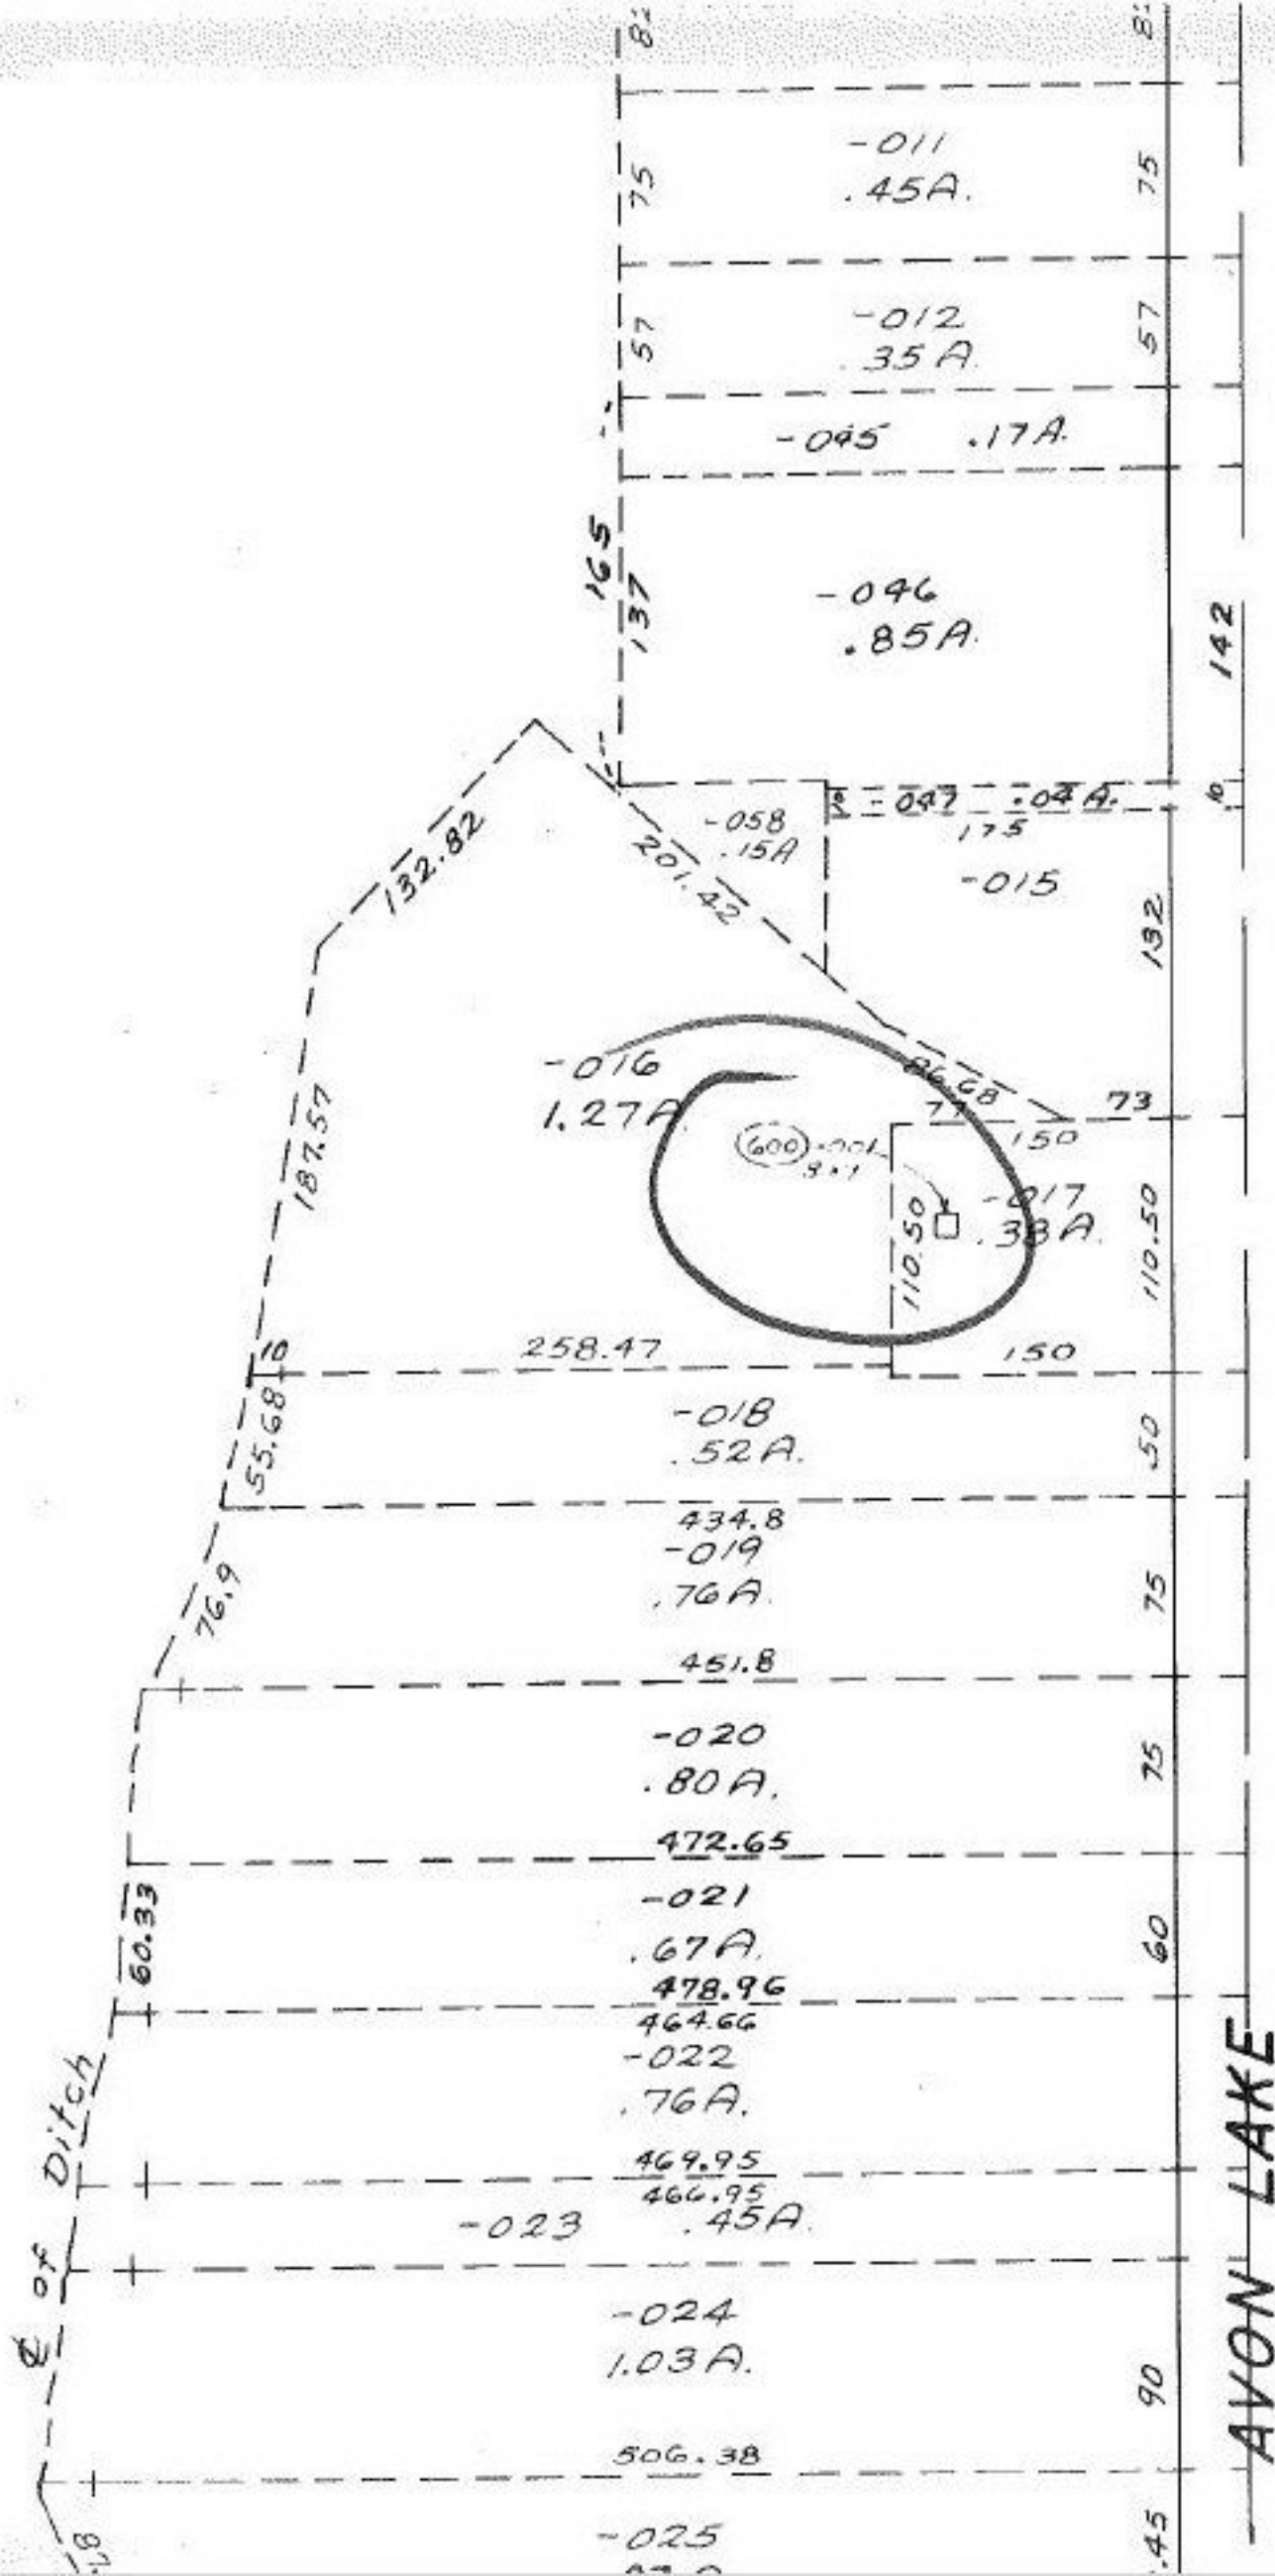

AVON LAKE

E of Ditch