

#14168

APPROVED  
LORAIN CO.  
MAP DEPT.

DATE: 4-27-81


PAGE 6-134

BY *[Signature]*

VOID  
AFTER

APR 27 1981

*[Handwritten initials]*

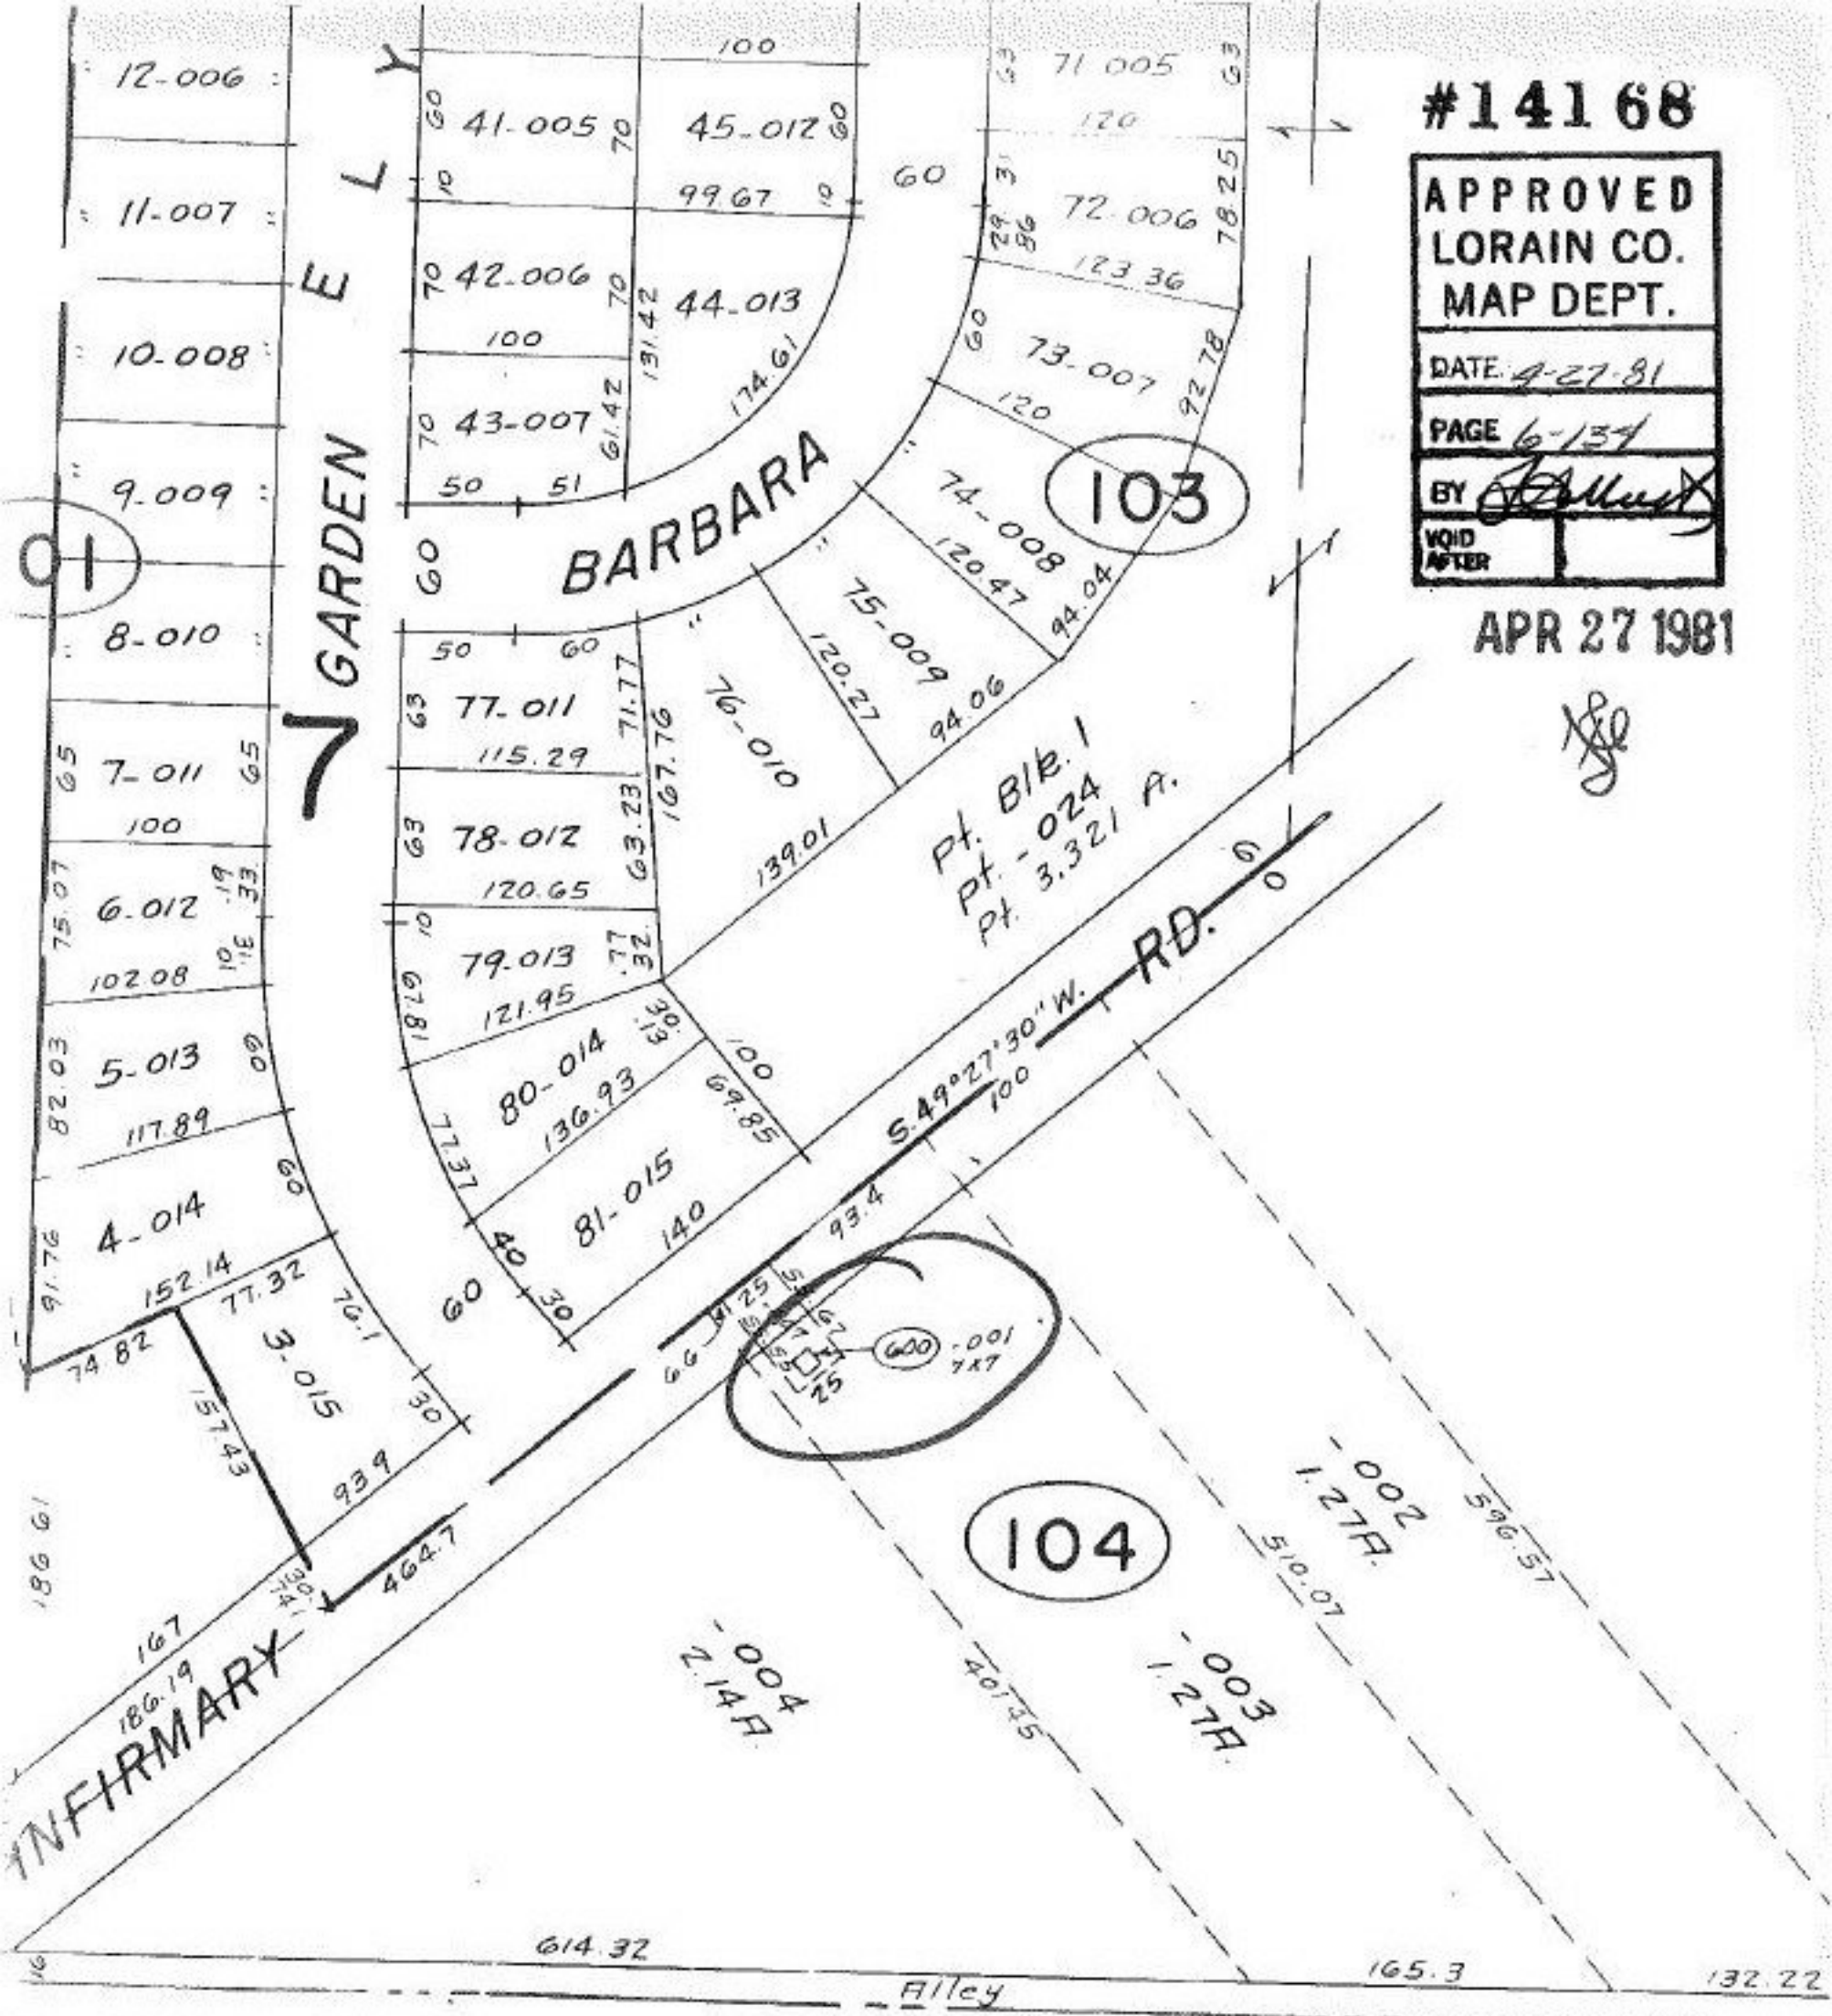

103

104

Alley

E 10-00-003-A

WEST OF RIVER