


#14168

APPROVED
LORAIN CO.
MAP DEPT.
DATE 4-27-81
PAGE 7-00-006-B
BY <i>[Signature]</i>
VOID AFTER

APR 27 1981

[Signature]

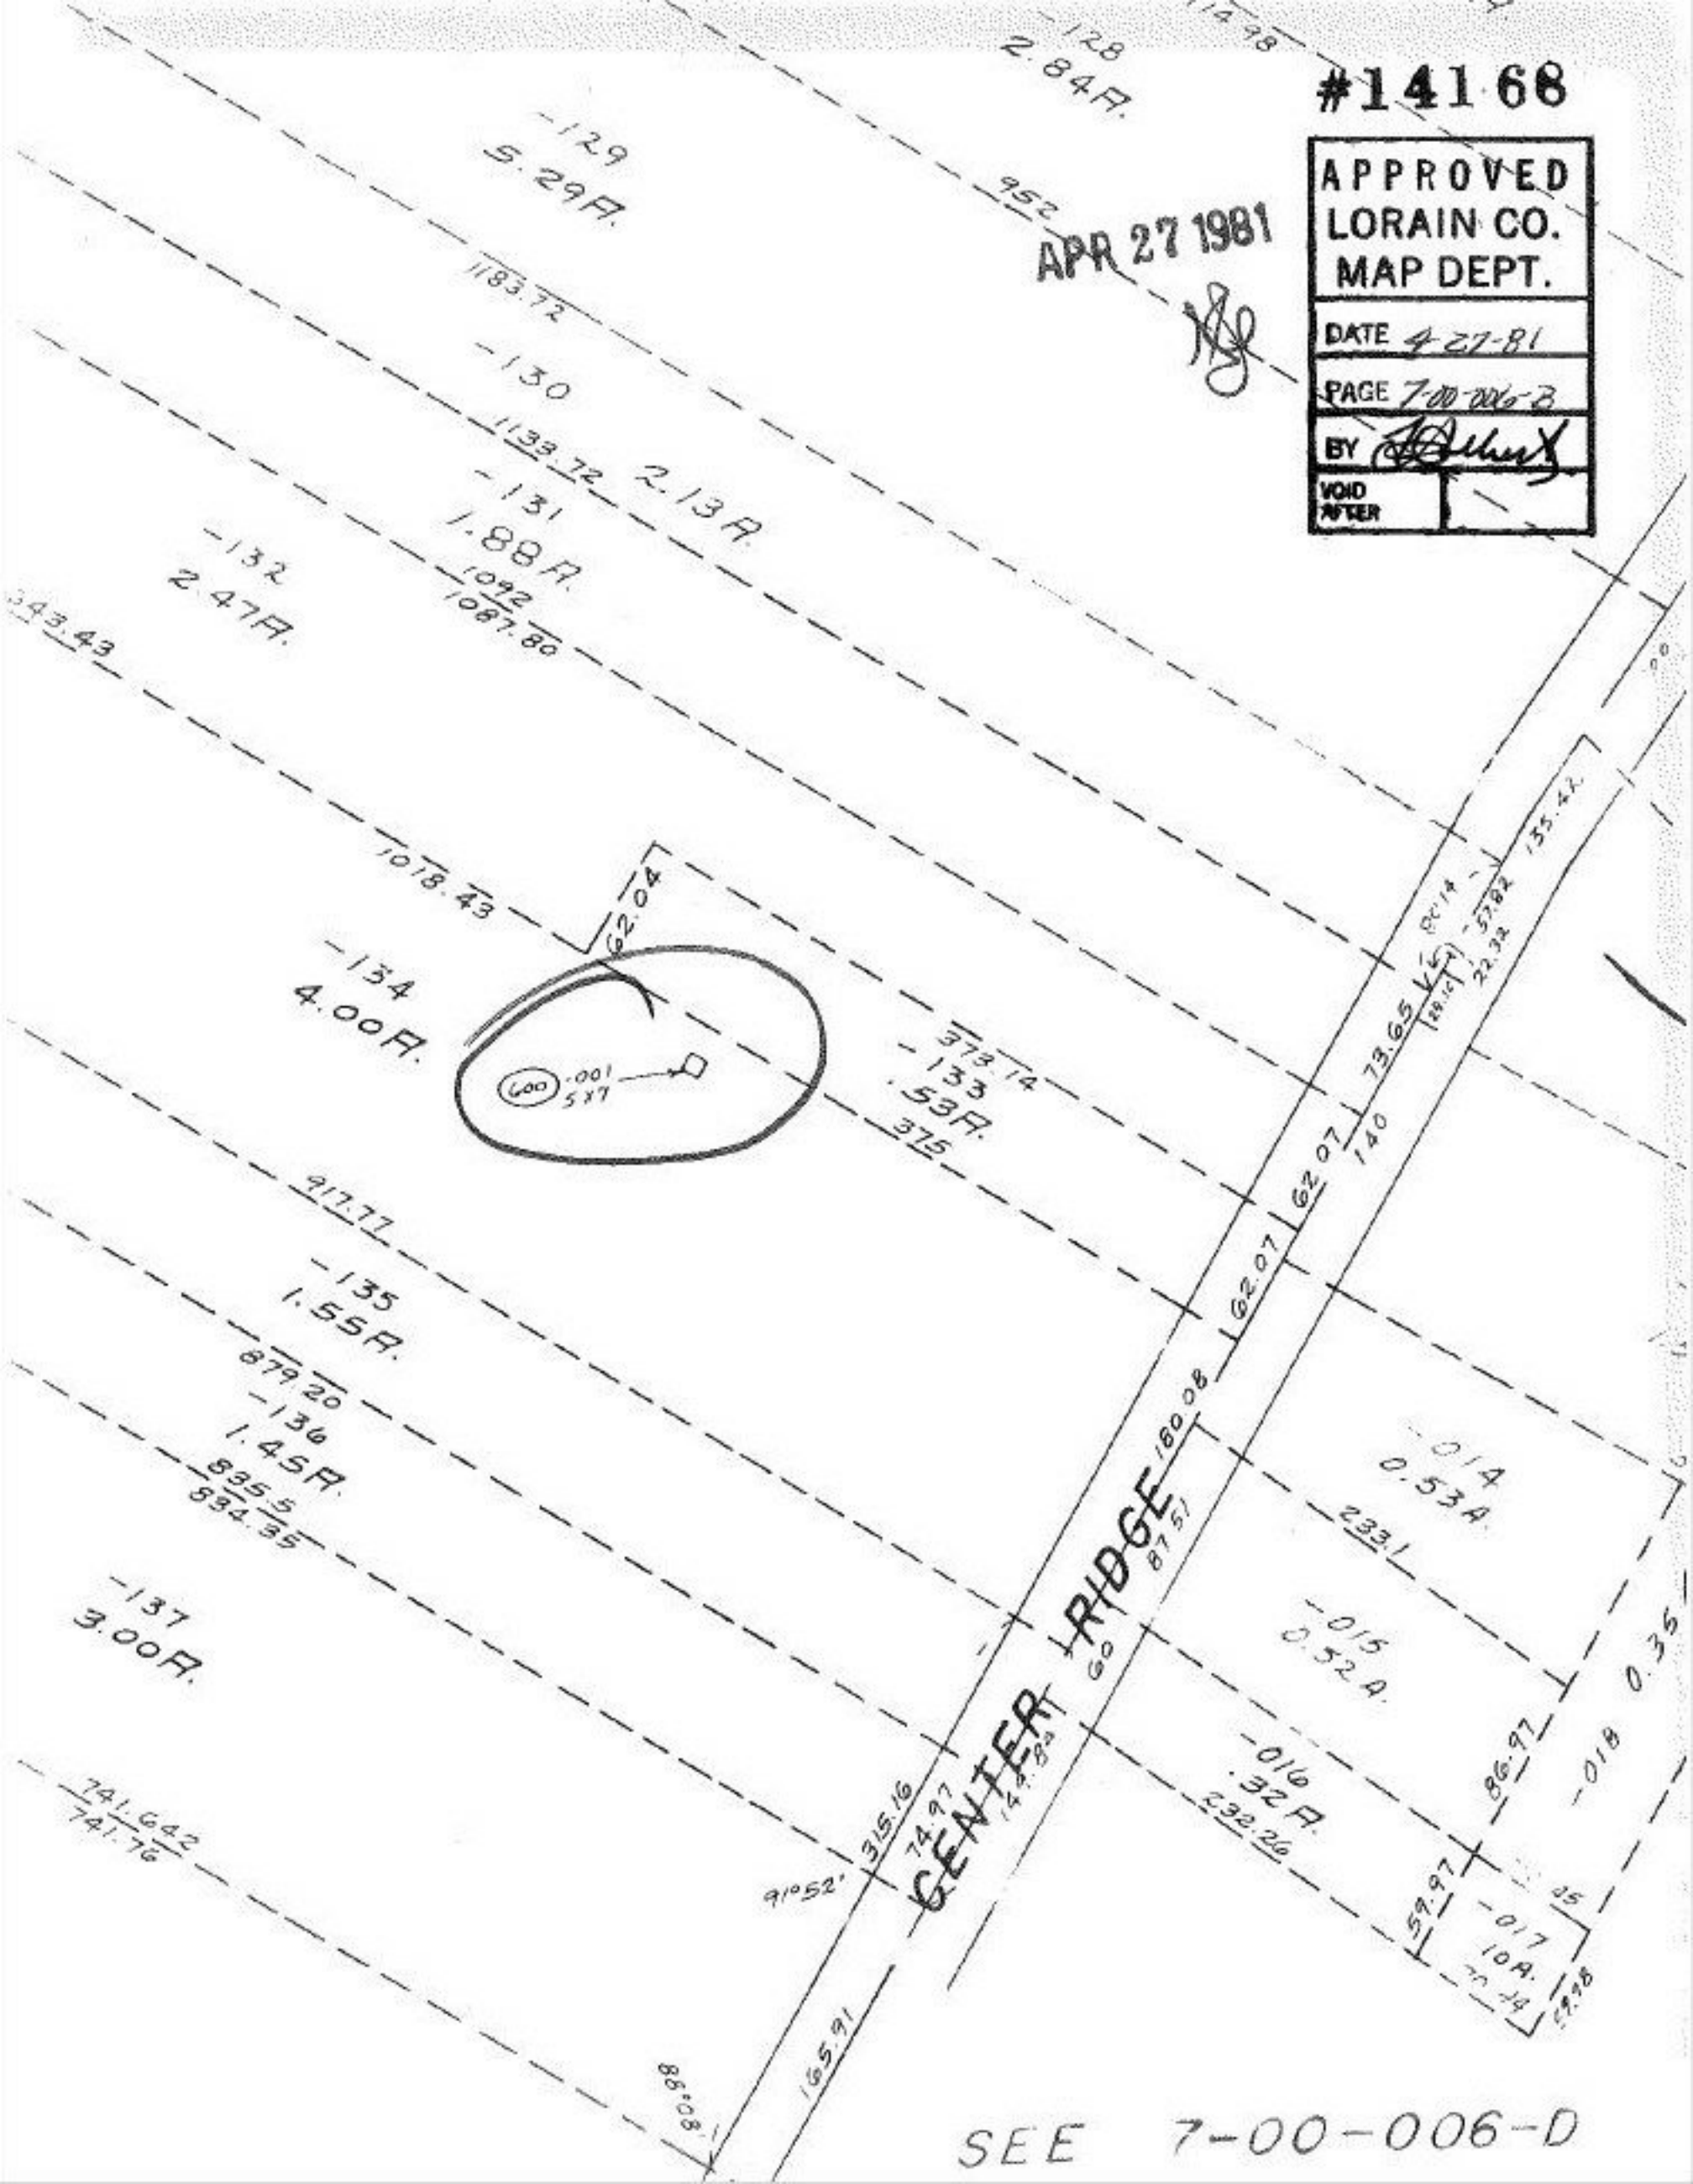

-128 2.84 F.
 -129 5.29 F.
 1183.72
 -130 2.13 F.
 1133.72
 -131 1.88 F.
 1092 / 1087.80
 -132 2.47 F.
 1018.43
 -134 4.00 F.
 917.77
 -135 1.55 F.
 879.20
 -136 1.45 F.
 835.5 / 834.35
 -137 3.00 F.
 741.642 / 741.76
 91°52'
 165.91
 315.16
 74.97
 144.84
 60
 CENTER RIDGE
 180.08
 87.57
 62.07
 62.07
 140
 73.65
 18.14
 22.32
 57.82
 155.42
 -014 0.53 A.
 233.1
 -015 0.52 A.
 86.97
 -016 .32 F.
 232.26
 -017 10 A.
 59.97
 35
 82.98

SEE 7-00-006-D