

APR 27 1981

JS

#14168

APPROVED LORAIN CO. MAP DEPT.
DATE 4-27-81
PAGE 15-00-045-A
BY <i>J. Ballin</i>
VOID AFTER

74.91 74.58

M E R R
8-044


370.5

369.9

7-045

369.2

-046
6.00 A.

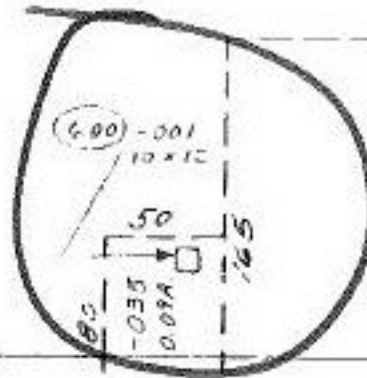

303

SEE 15-00-056-A

RANGE TWP.

W. 1/2 LOT 45