


#14168
 APPROVED
 LORAIN CO.
 MAP DEPT.
 DATE 4-27-81
 PAGE 18-00-021-C
 BY *Ballard*
 VOID AFTER

APR 27 1981
[Signature]

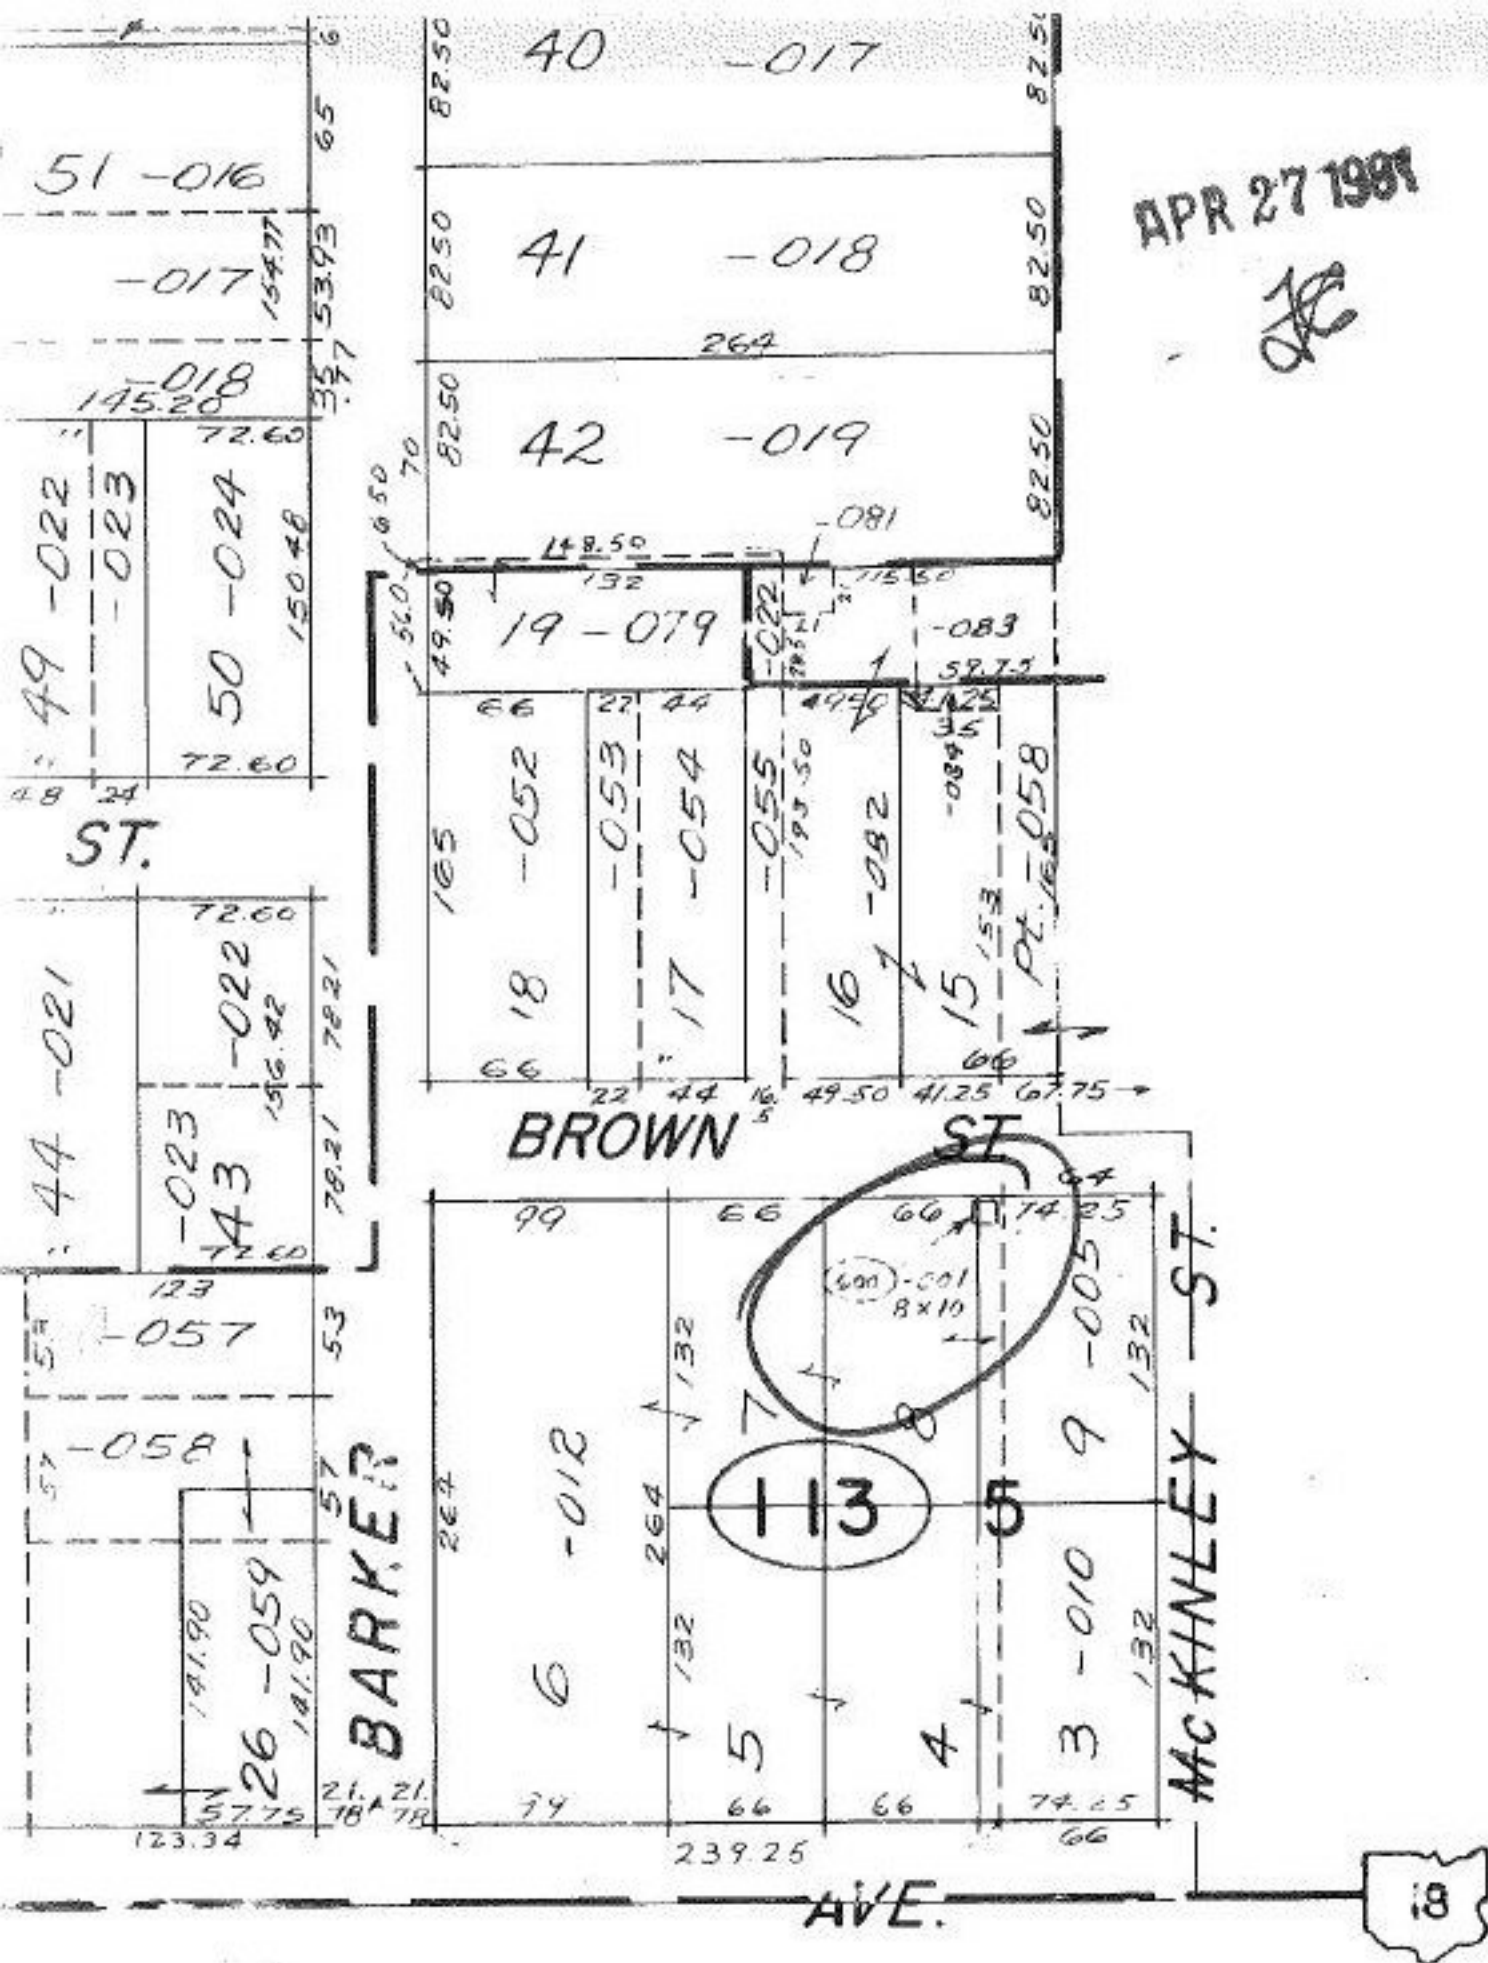

SW 1/4 LOT 21