


#14178

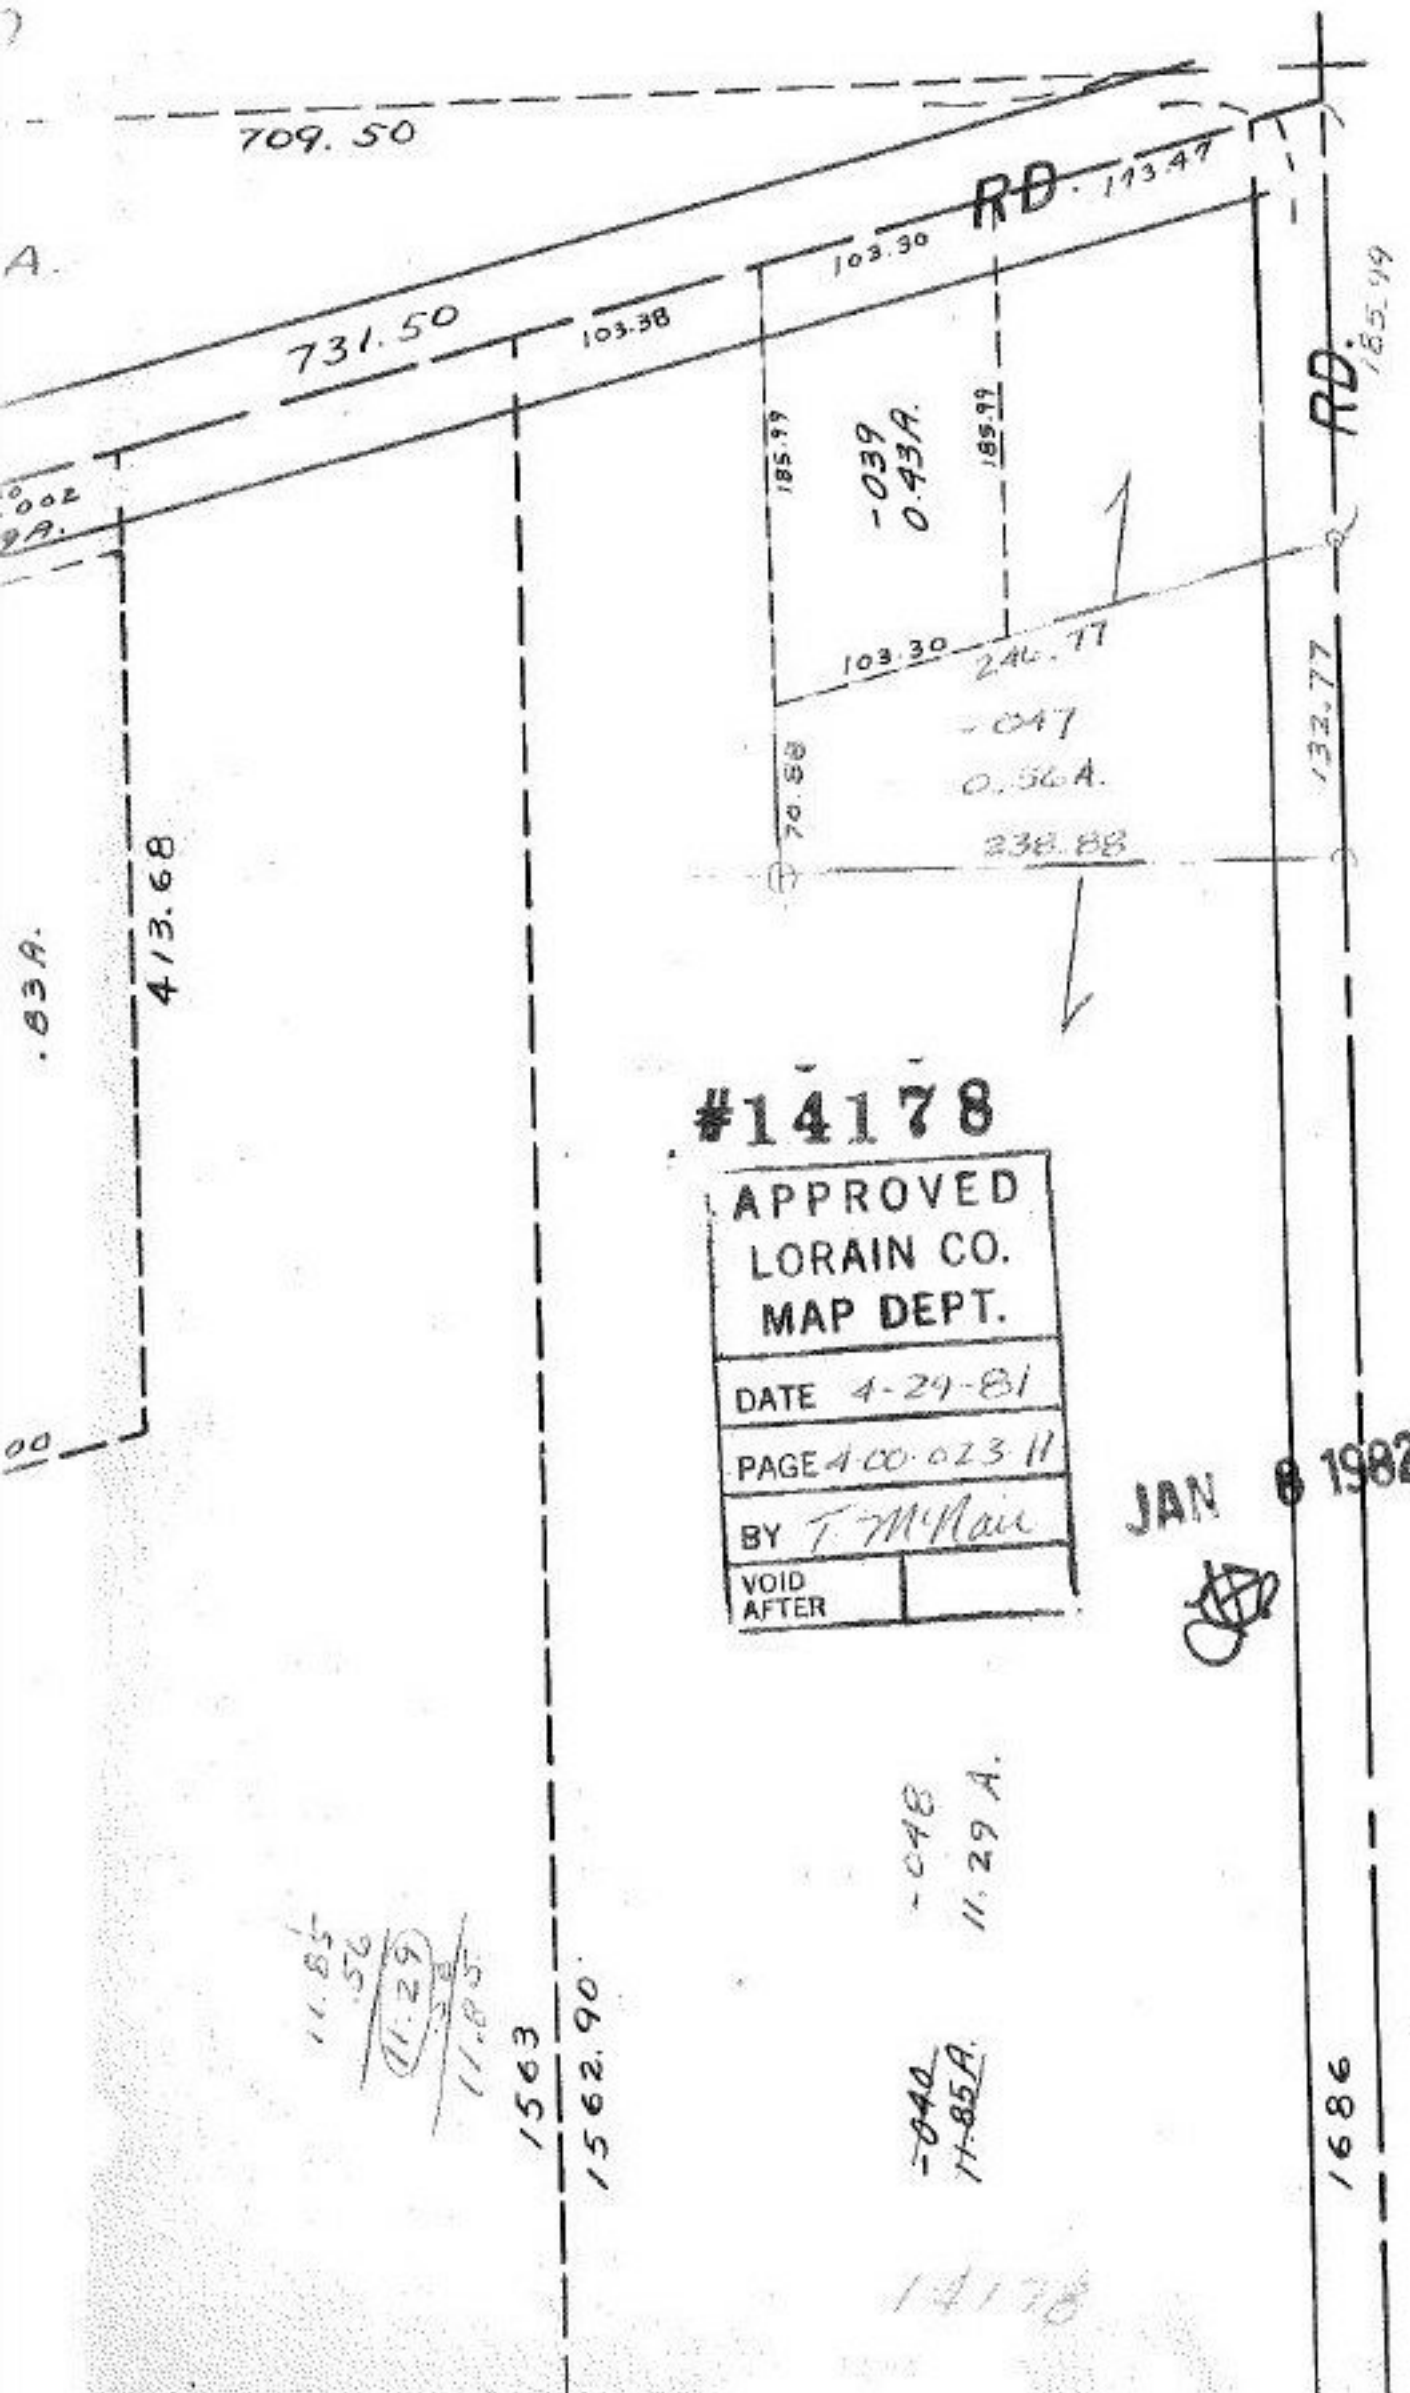

#14178

APPROVED
 LORAIN CO.
 MAP DEPT.
 DATE 4-29-81
 PAGE 4-00-023 II
 BY T. McMan
 VOID AFTER

JAN 8 1982

#14178