


#14185

SEE 18-00-021-C

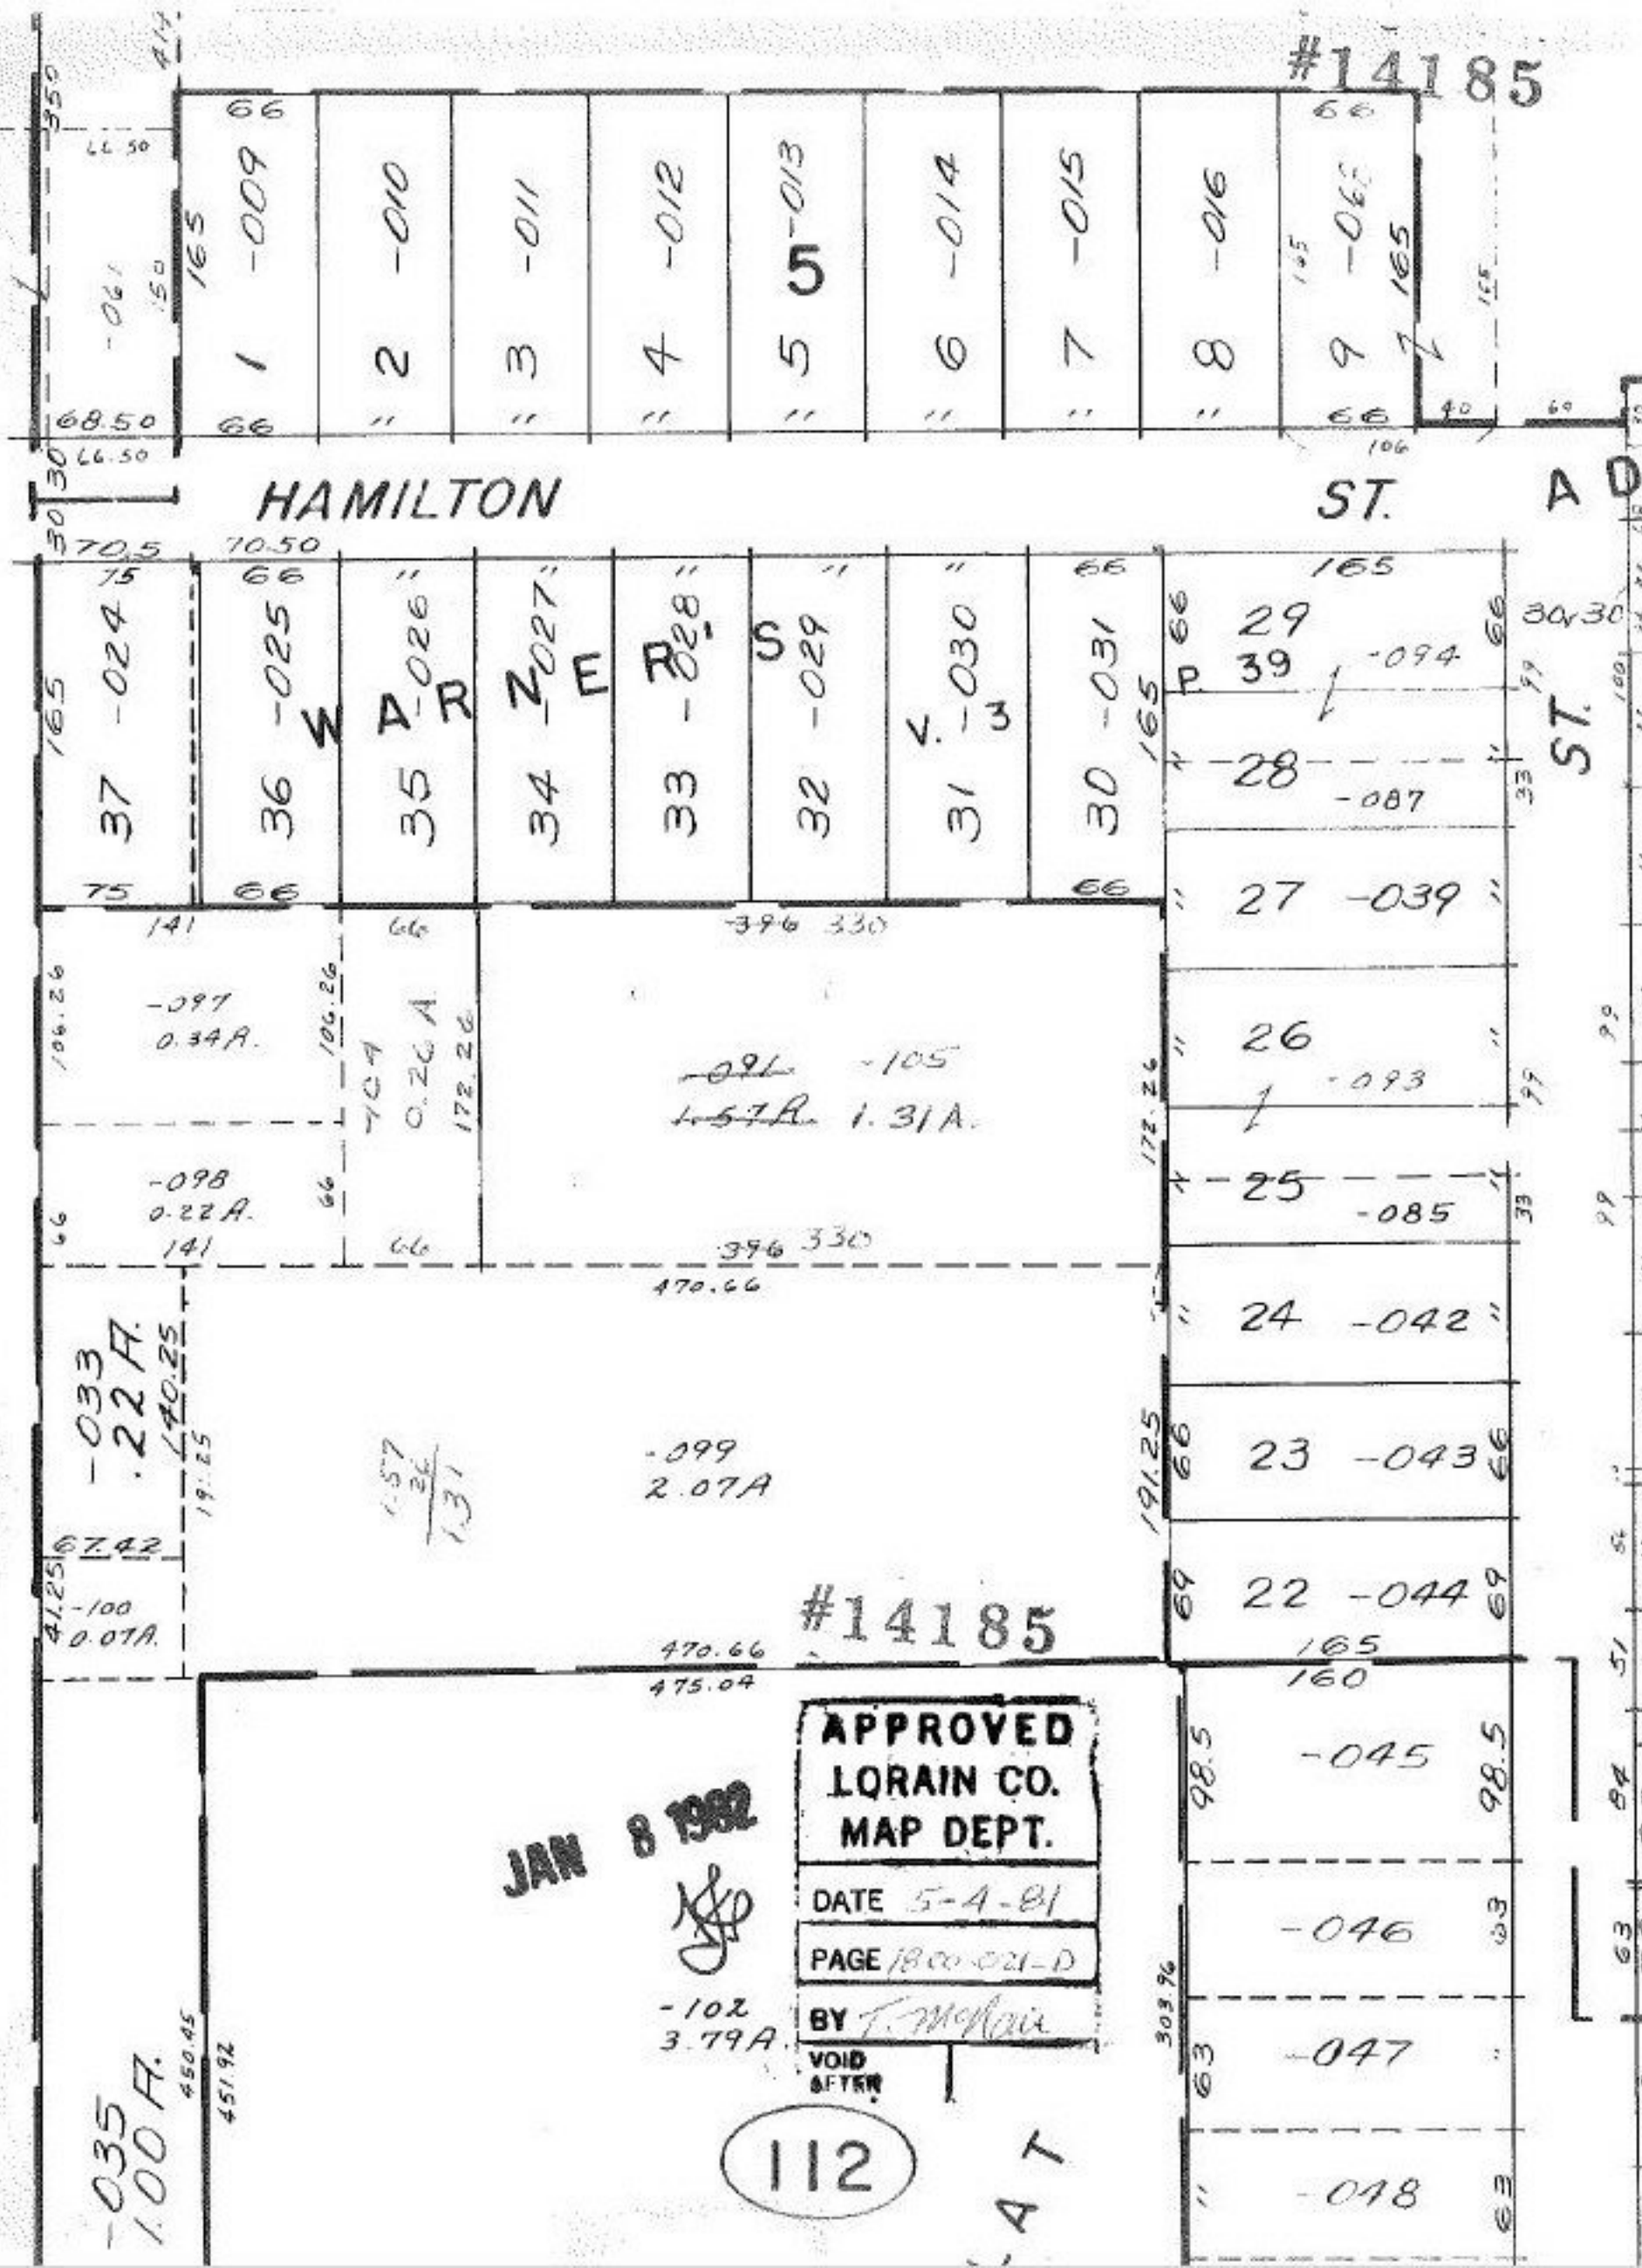

HAMILTON ST.

AD ST.

ST.

#14185

**APPROVED**  
**LORAIN CO.**  
**MAP DEPT.**

DATE 5-4-81

PAGE 1800-021-D

BY T. McNeil

VOID AFTER

JAN 8 1982

*[Signature]*

-102  
3.79A

112

PLAT

-035  
1.00 A.

98.5  
-045  
98.5  
-046  
98.5  
-047  
-048