


MAP CORRECTION

SALTS 10591 & 9969 DRAWN WRONG

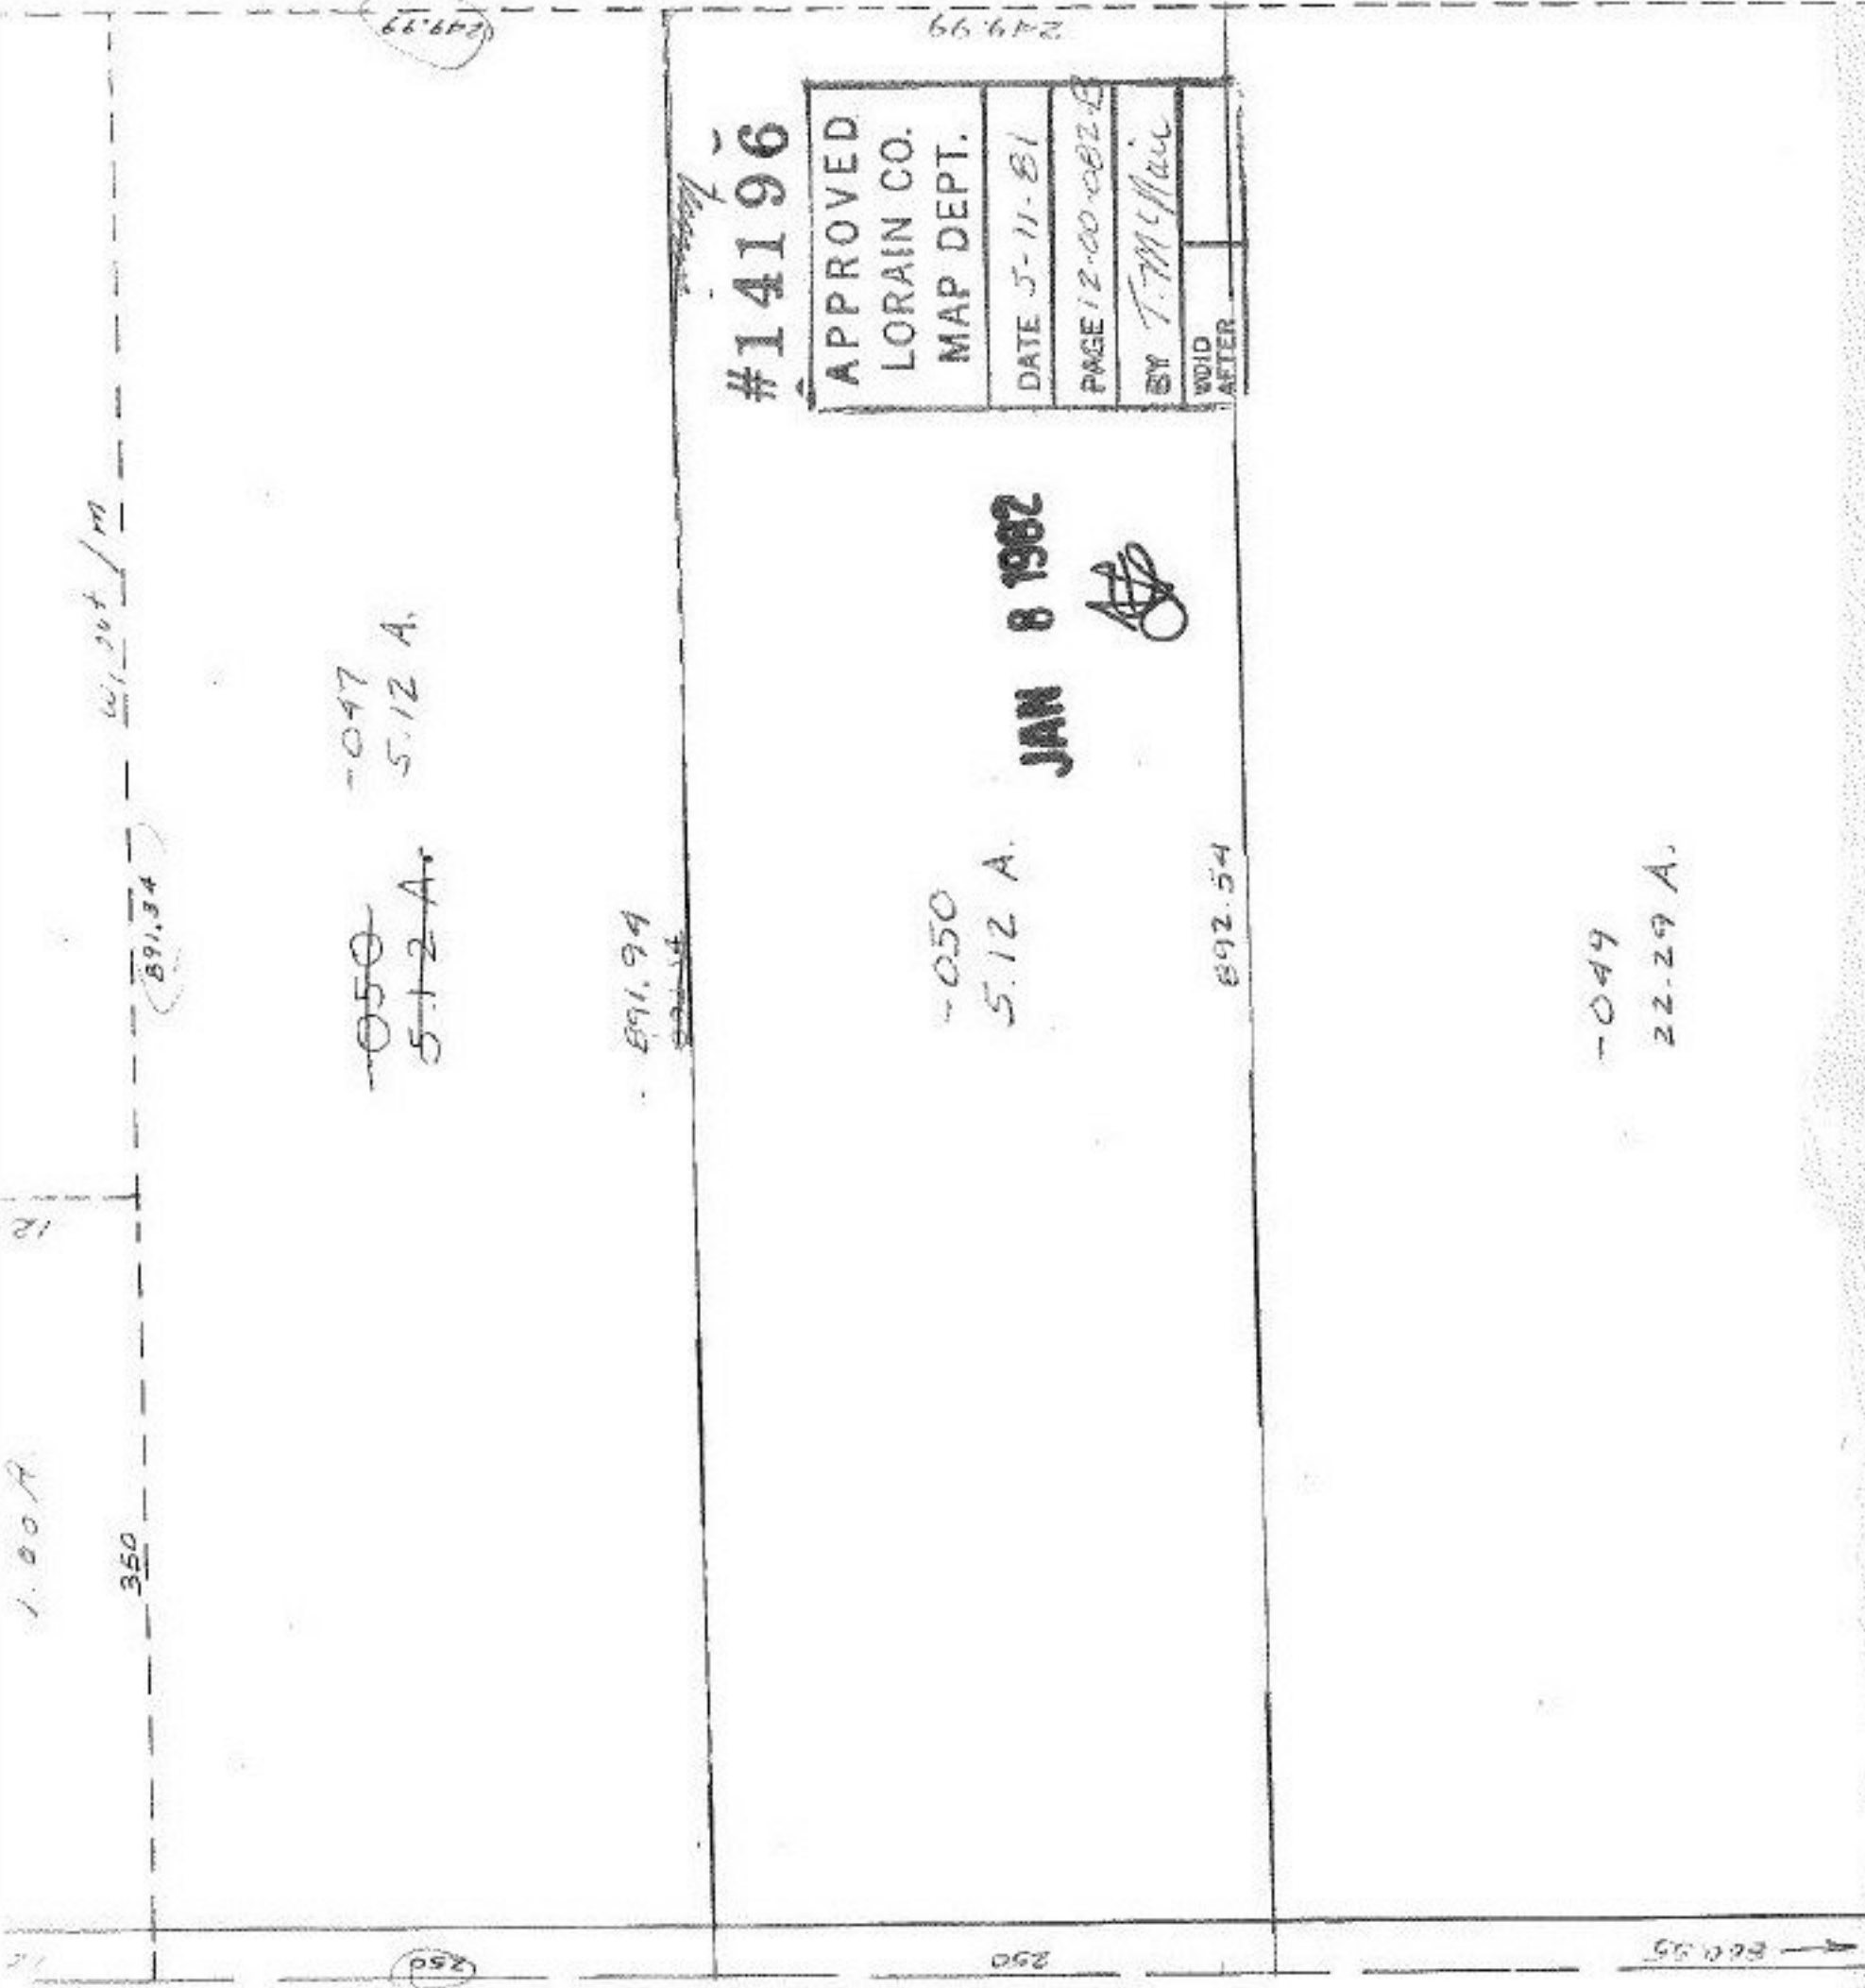

#14196

| |
|-------------------------------------|
| APPROVED LORAIN CO. MAP DEPT. |
| DATE 5-11-81 |
| PAGE 12-00-082-A |
| BY T. McNeil |
| VOID AFTER |

JAN 8 1982

SEE 12-00-082-A