


~~101~~
~~104~~
~~105~~

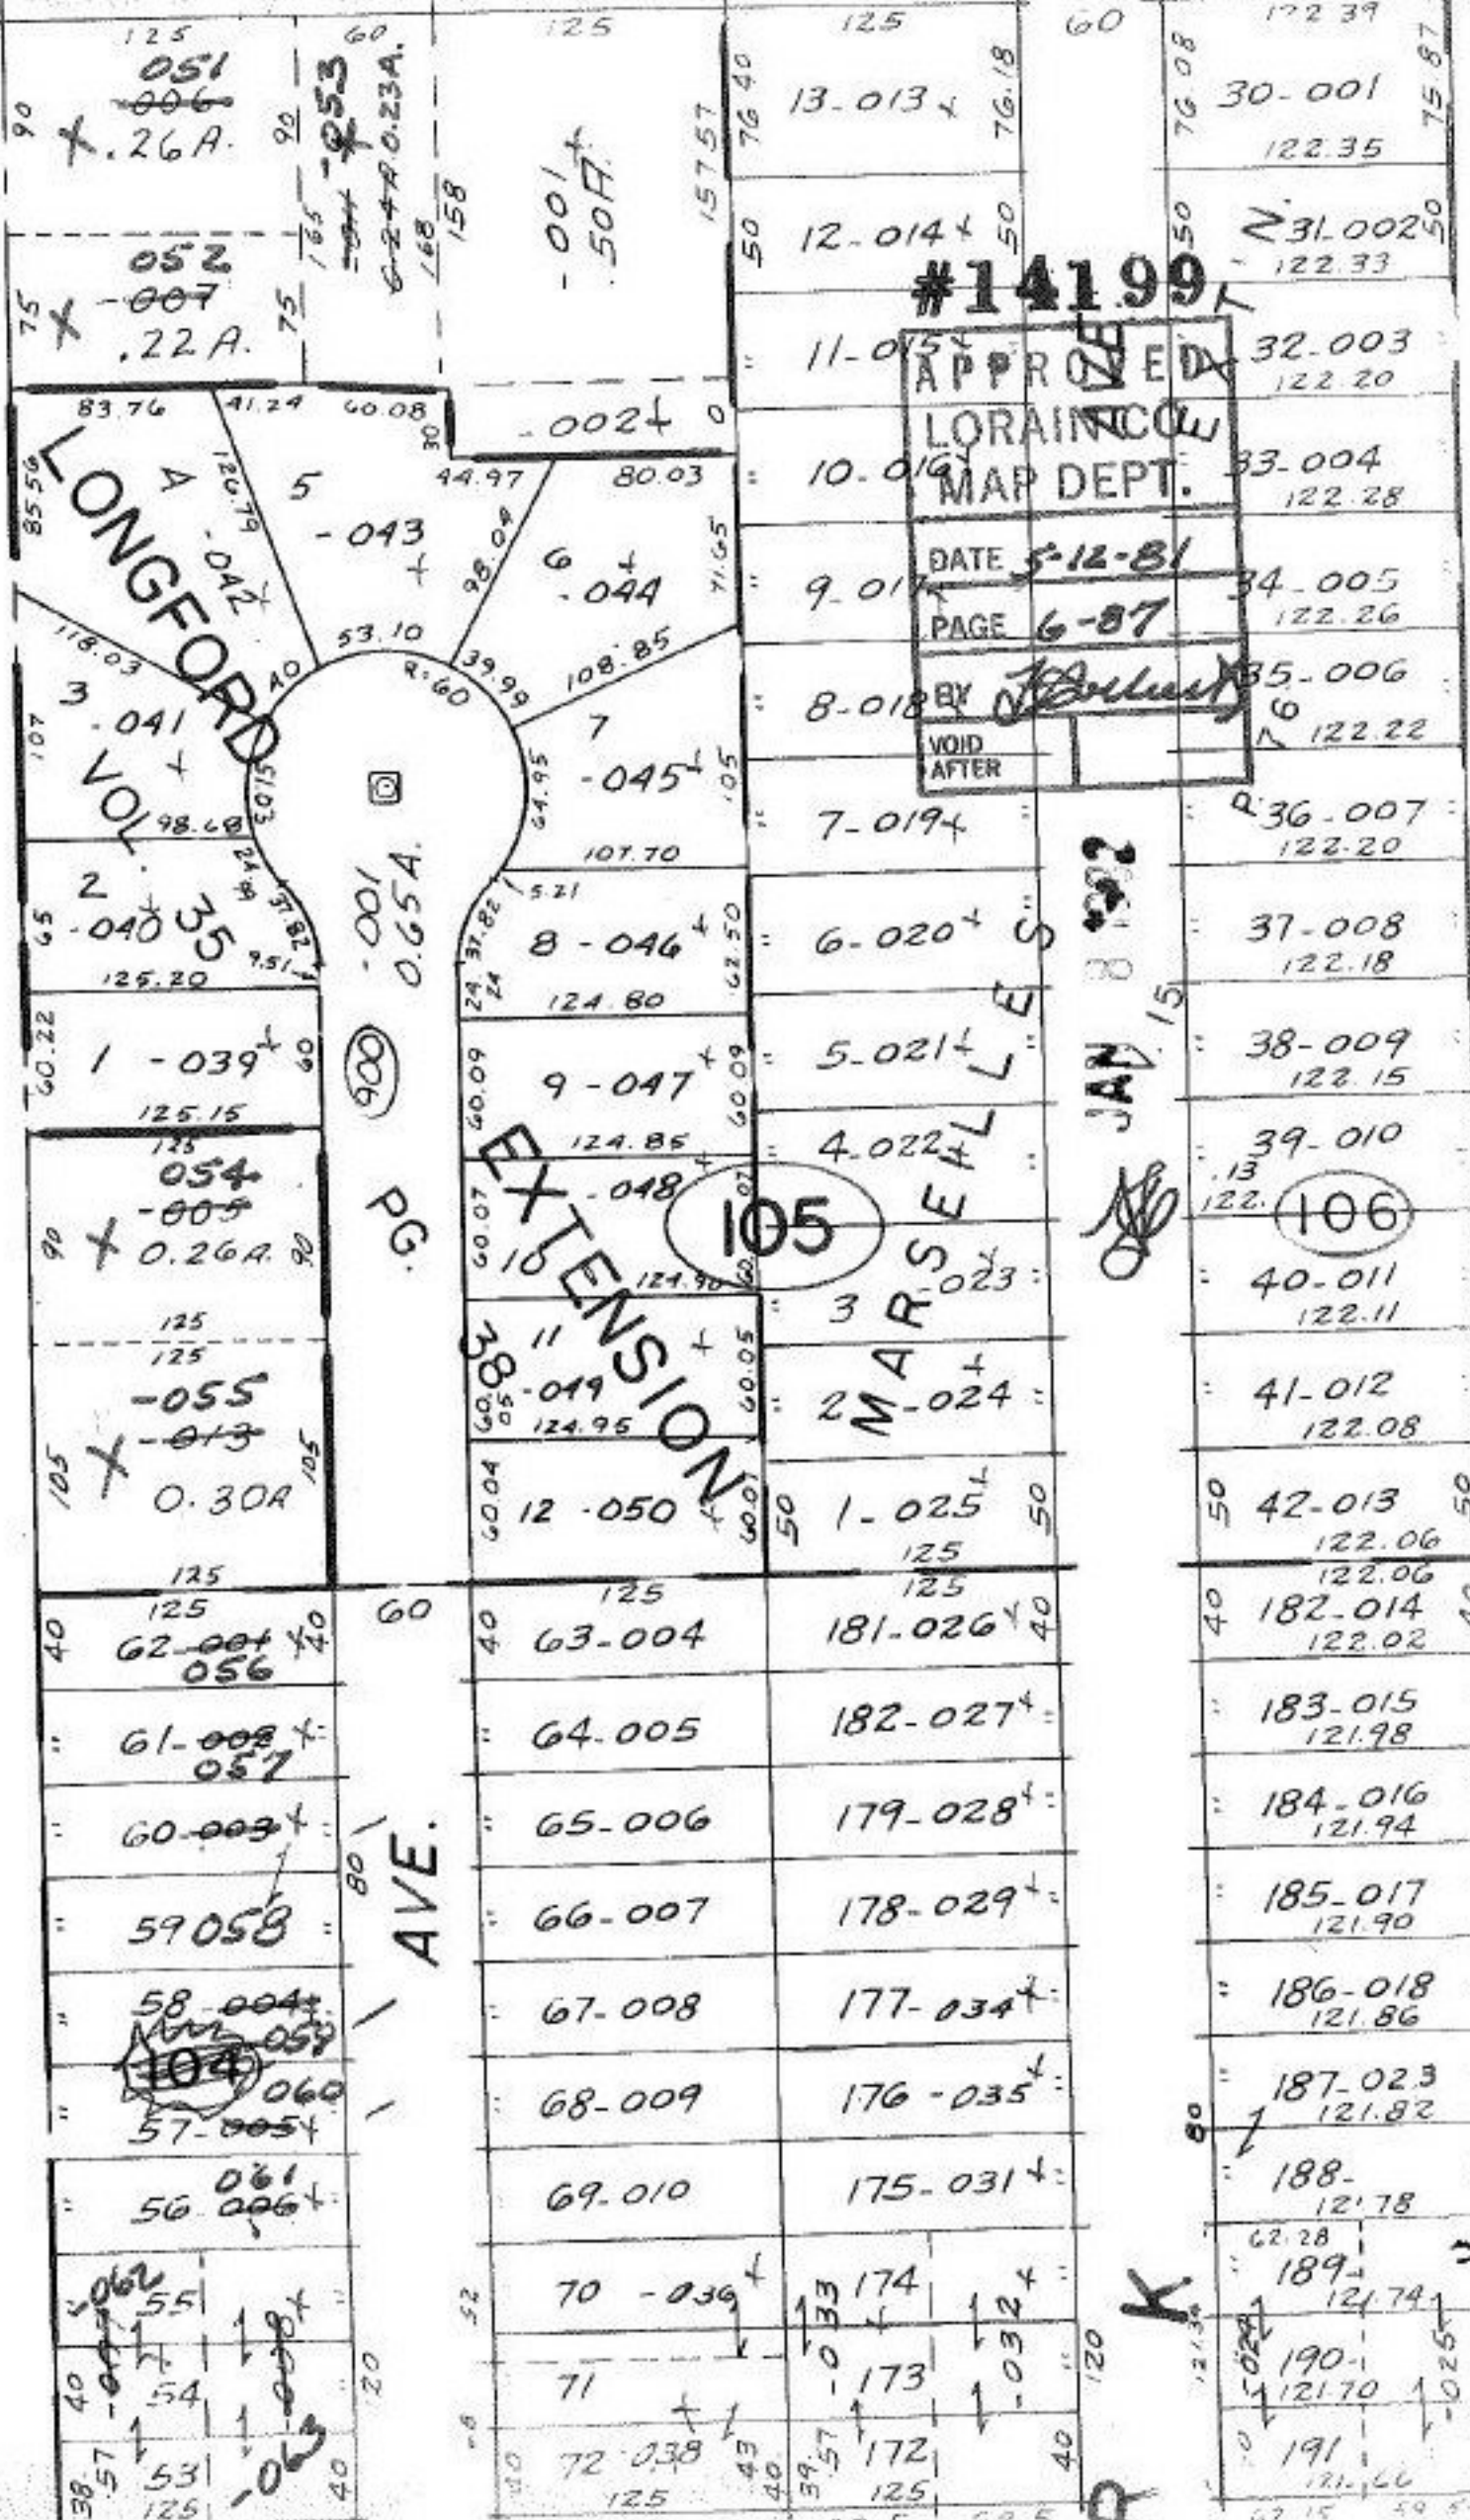

#14199

APPROVED
 LORAIN CO.
 MAP DEPT.

DATE 5-12-81
 PAGE 6-87

BY *[Signature]*
 VOID AFTER

JAN 15 1982

125	125	125	60	172.39
051	13.013	76.18	76.08	30-001
006	12.014	50	50	122.35
26A	11-015	50	50	31.002
052	10-016	50	50	122.33
007	9-017	50	50	32-003
22A	8-018	50	50	122.20
053	7-019	50	50	33-004
024R.23A.	6-020	50	50	122.28
001	5-021	50	50	34-005
054	4-022	50	50	122.26
005	3-023	50	50	35-006
026A	2-024	50	50	122.22
055	1-025	50	50	36-007
013	181-026	40	40	122.20
030A	182-027	40	40	37-008
056	182-028	40	40	122.18
057	183-015	40	40	38-009
058	184-016	40	40	122.15
059	185-017	40	40	39-010
060	186-018	40	40	122.13
061	187-023	40	40	106
062	188-	40	40	40-011
063	189-	40	40	122.11
064	190-	40	40	41-012
065	191-	40	40	122.08
066	192-	40	40	42-013
067	193-	40	40	122.06
068	194-	40	40	122.06
069	195-	40	40	182-014
070	196-	40	40	122.02
071	197-	40	40	183-015
072	198-	40	40	121.98
073	199-	40	40	184-016
074	200-	40	40	121.94
075	201-	40	40	185-017
076	202-	40	40	121.90
077	203-	40	40	186-018
078	204-	40	40	121.86
079	205-	40	40	187-023
080	206-	40	40	121.82
081	207-	40	40	188-
082	208-	40	40	121.78
083	209-	40	40	189-
084	210-	40	40	121.74
085	211-	40	40	190-
086	212-	40	40	121.70
087	213-	40	40	191-
088	214-	40	40	121.66
089	215-	40	40	192-
090	216-	40	40	121.62
091	217-	40	40	193-
092	218-	40	40	121.58
093	219-	40	40	194-
094	220-	40	40	121.54
095	221-	40	40	195-
096	222-	40	40	121.50
097	223-	40	40	196-
098	224-	40	40	121.46
099	225-	40	40	197-
100	226-	40	40	121.42