


1423.00  
BOONE

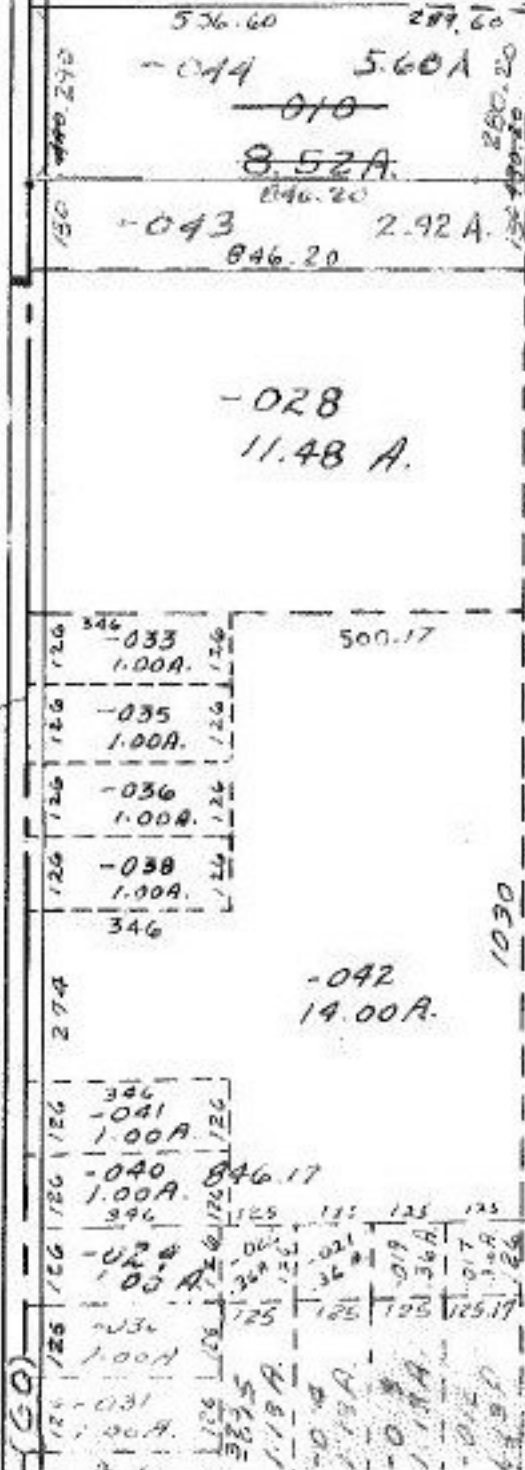

SEE 12-00-012-A

SEE 12-00-012-B

12

490  
120  
290  
  
80  
20  
5.60

605.22

430.20  
150.00  
280.20

-028  
11.48 A.

#14204  
003  
83A

-002  
31.66A.  
JAN 8 1982

APPROVED  
LORAIN CO.  
MAP DEPT.

DATE 5-14-81

PAGE 12-H

BY T. McNeil

VOID  
AFTER

1366.96

-001  
6.50A.

790.25

500.35

-001  
37.50A.