

COMBINATION

#14223

APPROVED
LORAIN CO.
MAP DEPT.


DATE 6-2-81

PAGE 15-00-046-A

BY T. McRae

VOID
AFTER

JAN 8 1982

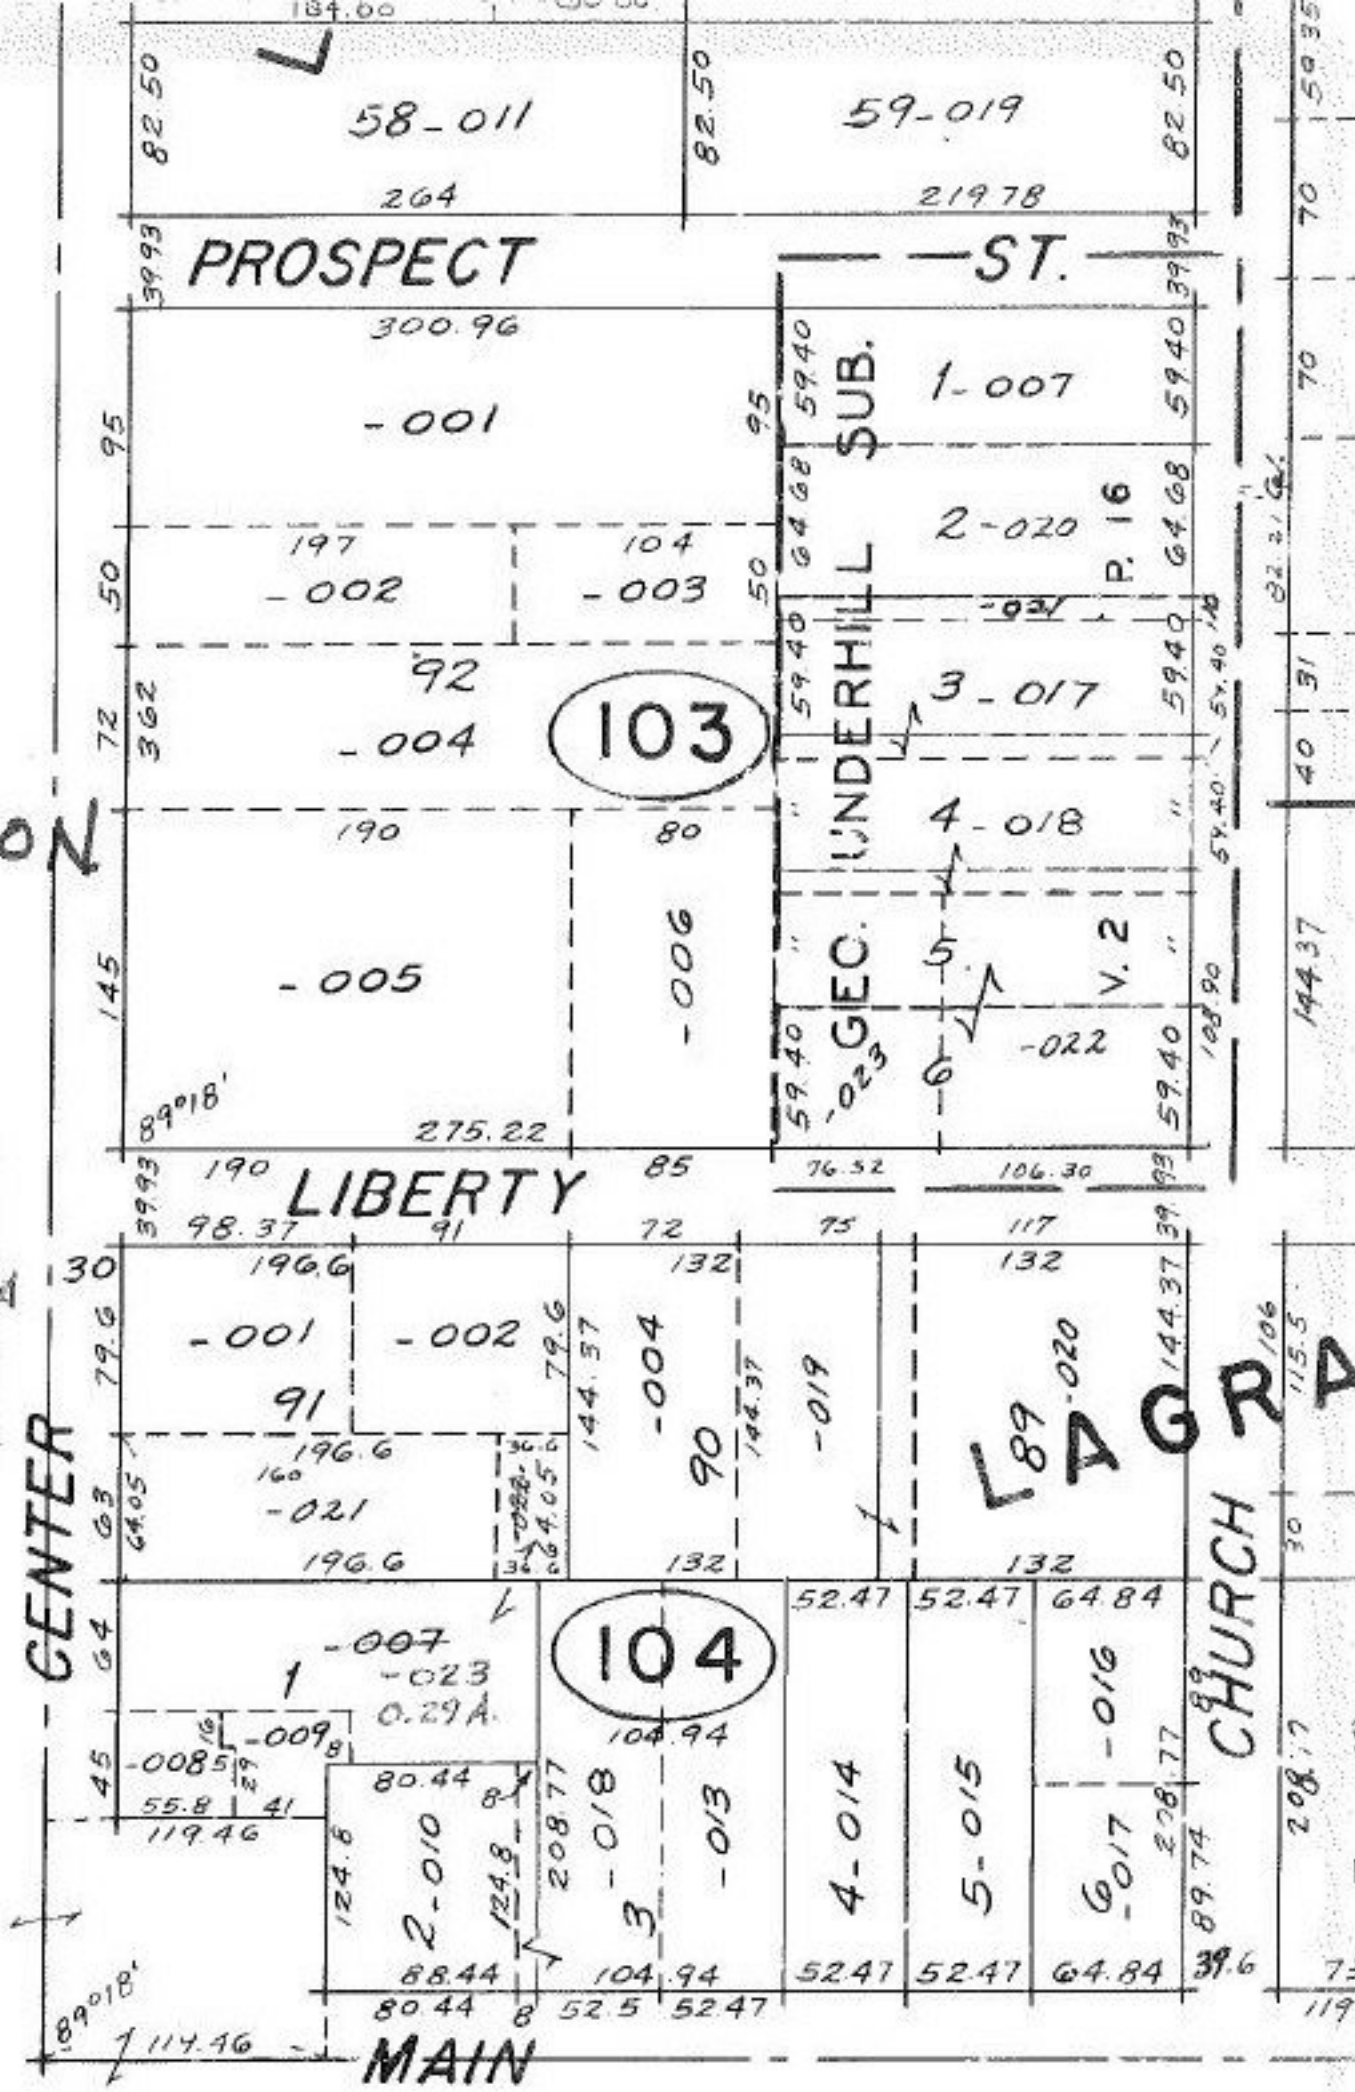

LAGRANGE TWP.

SCALE 1" = 100'

3-A