

Pt. - 010
Pt. 6.23 A.

10 INTERSTATE 90

103

Pt. - 016
Pt. 2.33 A.

06-23-010-103-031

MAP CORRECTION ONLY #14234

R. - 032
Pt. 3.81 A.

T.M.
1.13.82

APPROVED
LORAIN CO.
MAP DEPT.
DATE 6.4.81
PAGE 6.26
BY T.M.M
VOID AFTER

Pt. 15 - 013

AJO
CASSELL

Pt. 14 - 031
- 045

- 012 ✓
161.16
201.23
260.16

- 030
0.67 A.

- 029


AAA

1047.92
153.40
47.60
200.28

1014.53
999.10

943.27

1020.78

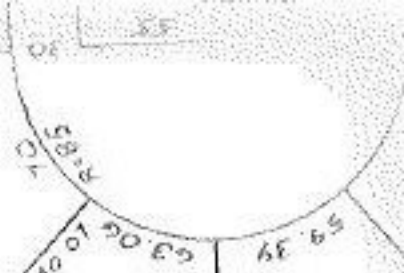

1
N