


ELYRIA - TWINSBURG

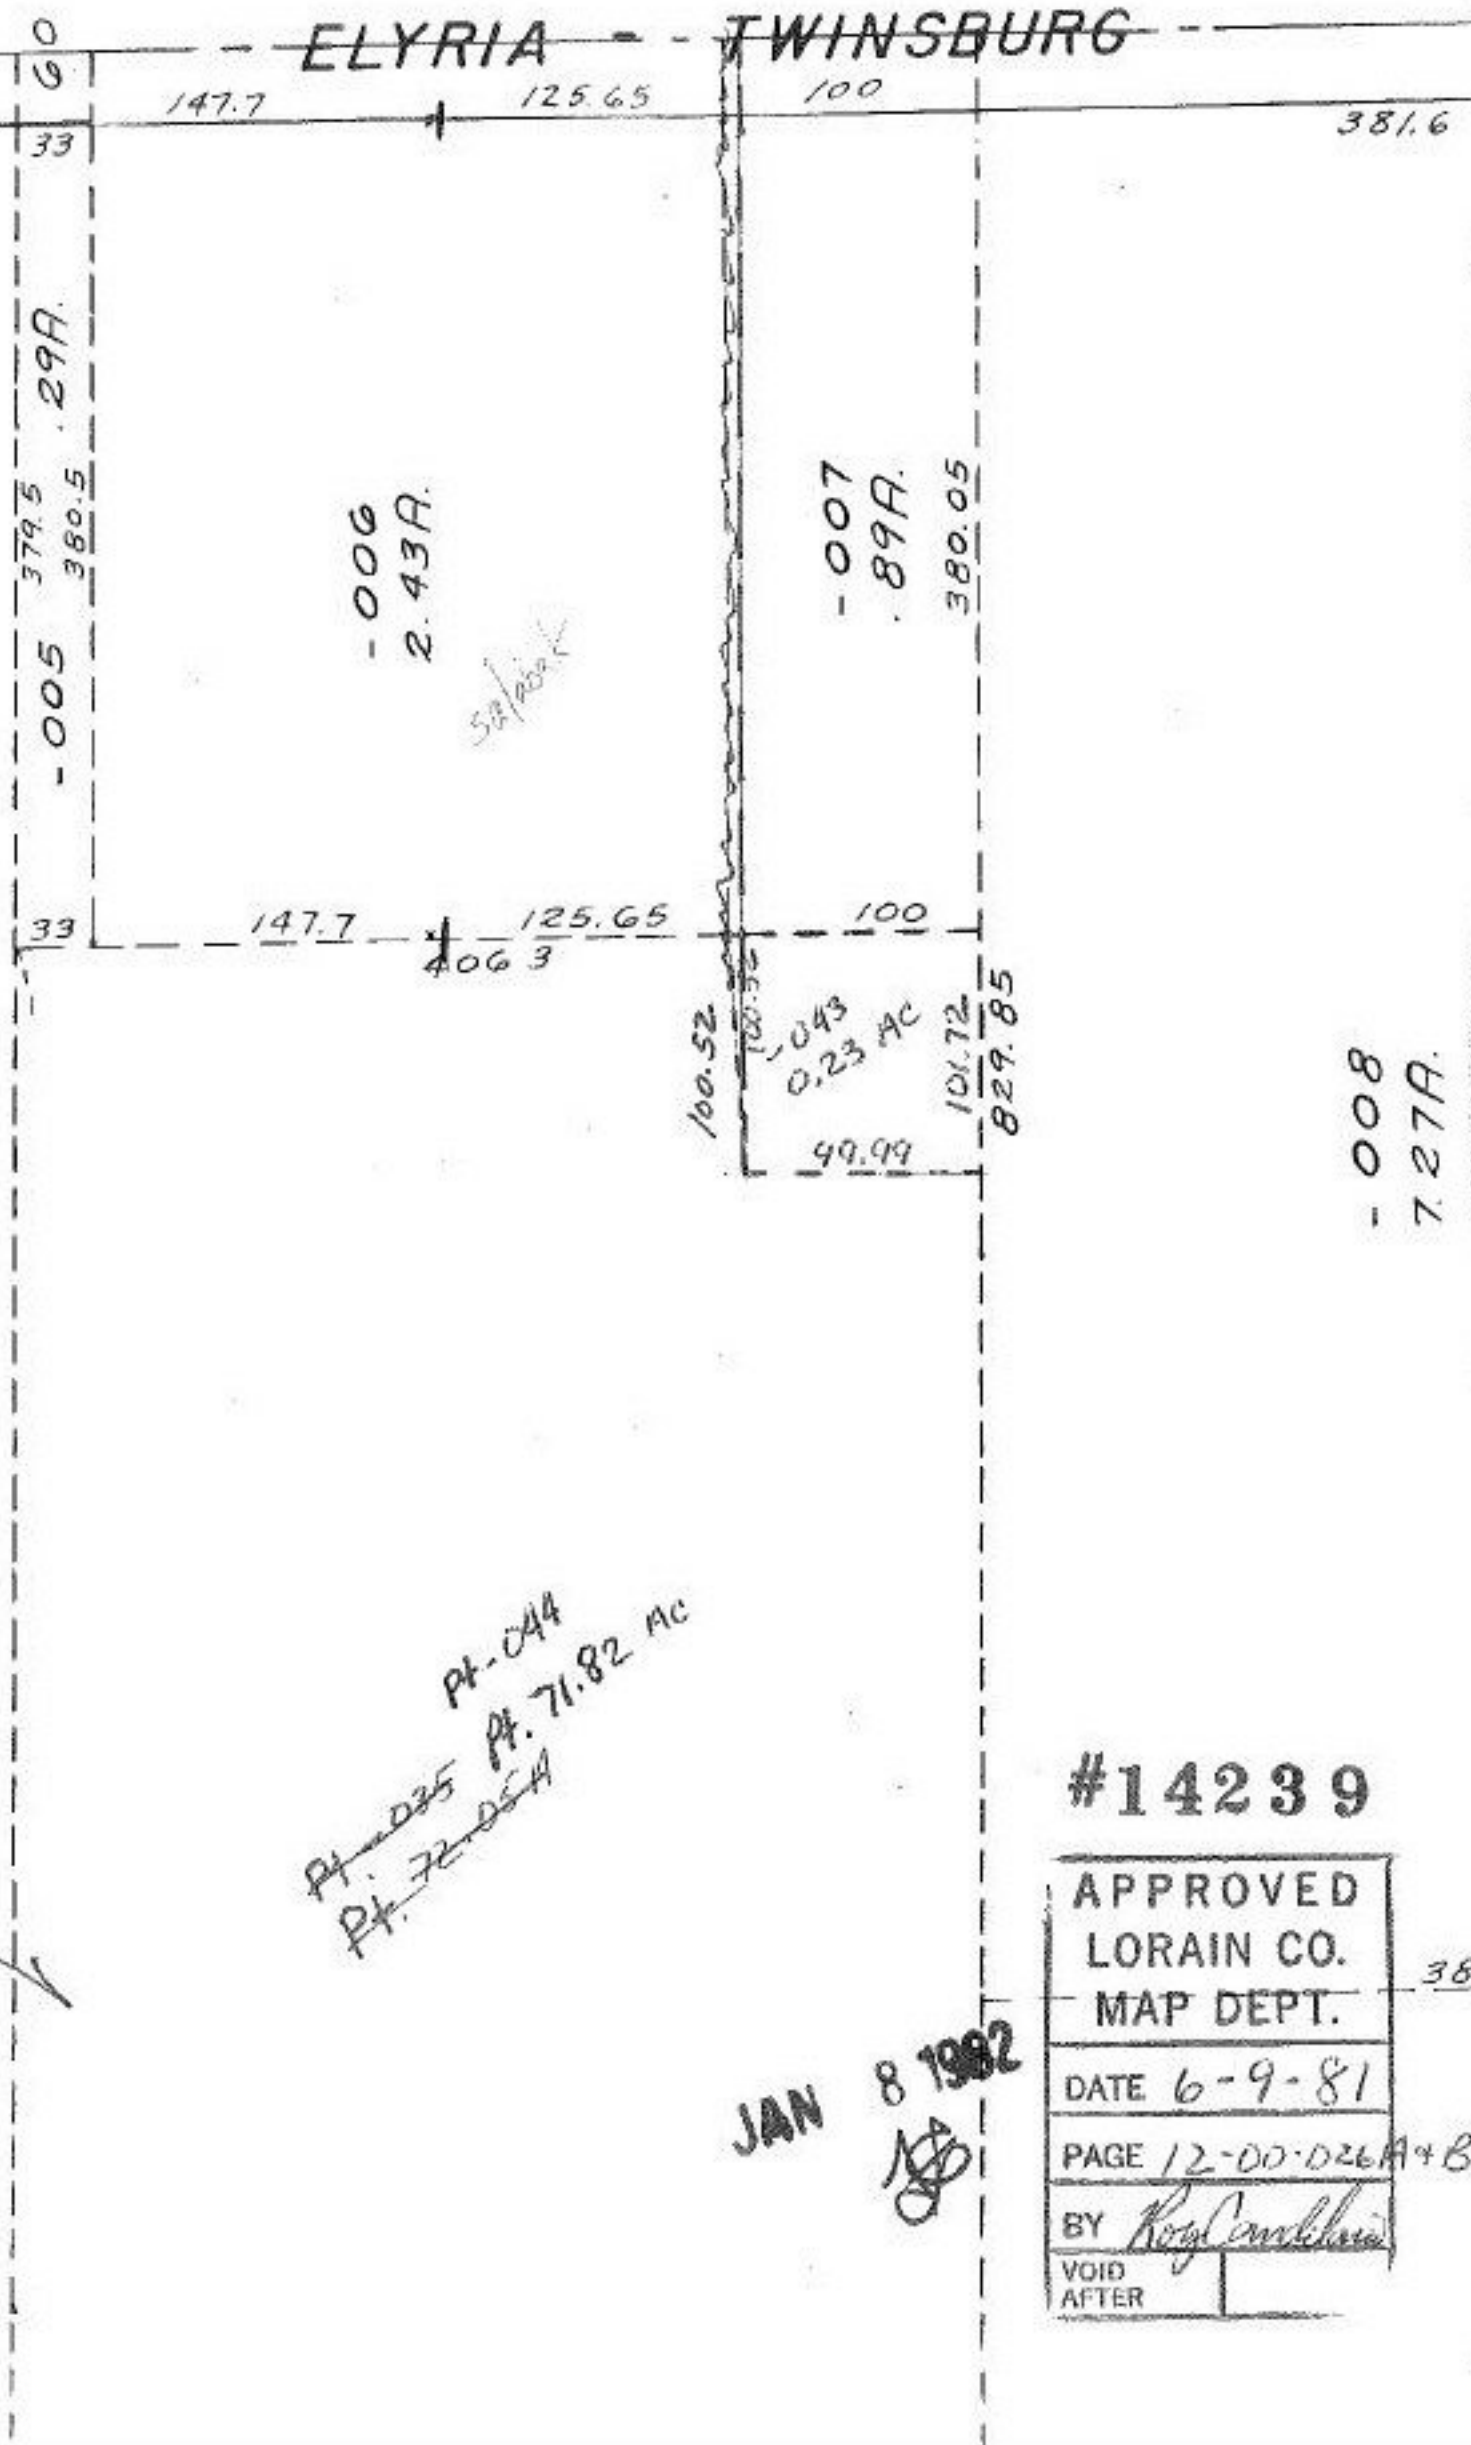

CHANGE 12-00-026-A

PT. 035      PT. 044  
PT. 72      PT. 71.82 AC  
05A

#14239

APPROVED
LORAIN CO.
MAP DEPT.
DATE 6-9-81
PAGE 12-00-026A+B
BY <i>Roy Conklin</i>
VOID AFTER

JAN 8 1982