

A

ACREAGE  
CORRECTION  
#14246

689

APPROVED  
LORAIN CO.  
MAP DEPT.

DATE 6.10.81

PAGE 12.00.062-B


BY T. M. Main

VOID  
AFTER

JAN 8 1982

*[Signature]*

-035  
4.73 A.

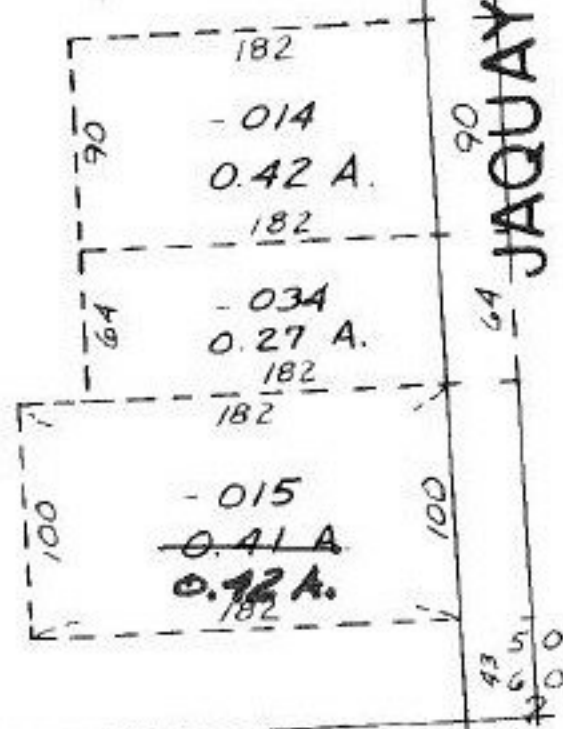

684

-033-B