

-B

SHEFFIELD TWP  
ELYRIA CITY CORP. (LINE)

89.30

401

R.D.

.72 A.

779.11

777.94

-014

T.M.  
1.12.82

#14248

APPROVED  
LORAIN CO.  
MAP DEPT.

DATE 6-23-81

PAGE 16

BY (Signature)

VOID AFTER

~~Pl. 099~~

~~Pl. 150~~

~~Pl. 25.58A~~

~~Pl. 40.17A~~

14248

~~Pl. 152~~



24.76 A

40.17  
80  
39.35  
82  
40.17

ALSO CHANGE  
PAGE 6-16  
6-15

24.76  
0.82  
25.58

LOYOLA  
DRIVE

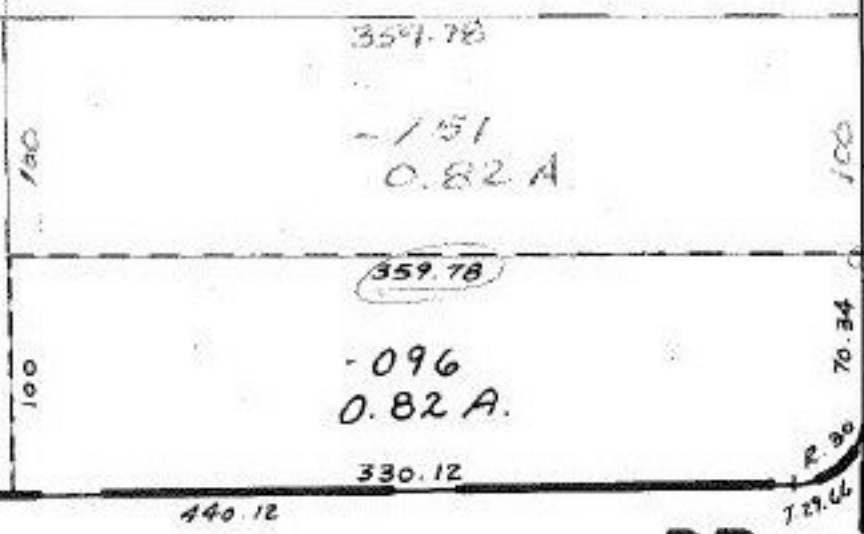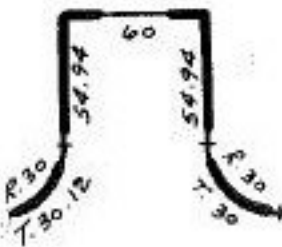

DR.

729.66

R. 30

70.34

84.01

100

10 0.08 A  
89.95

120

R. 30

20

City Eng. Dept

29 A.

120

557.27

329.65

55.30

76