


POWDERMAKER

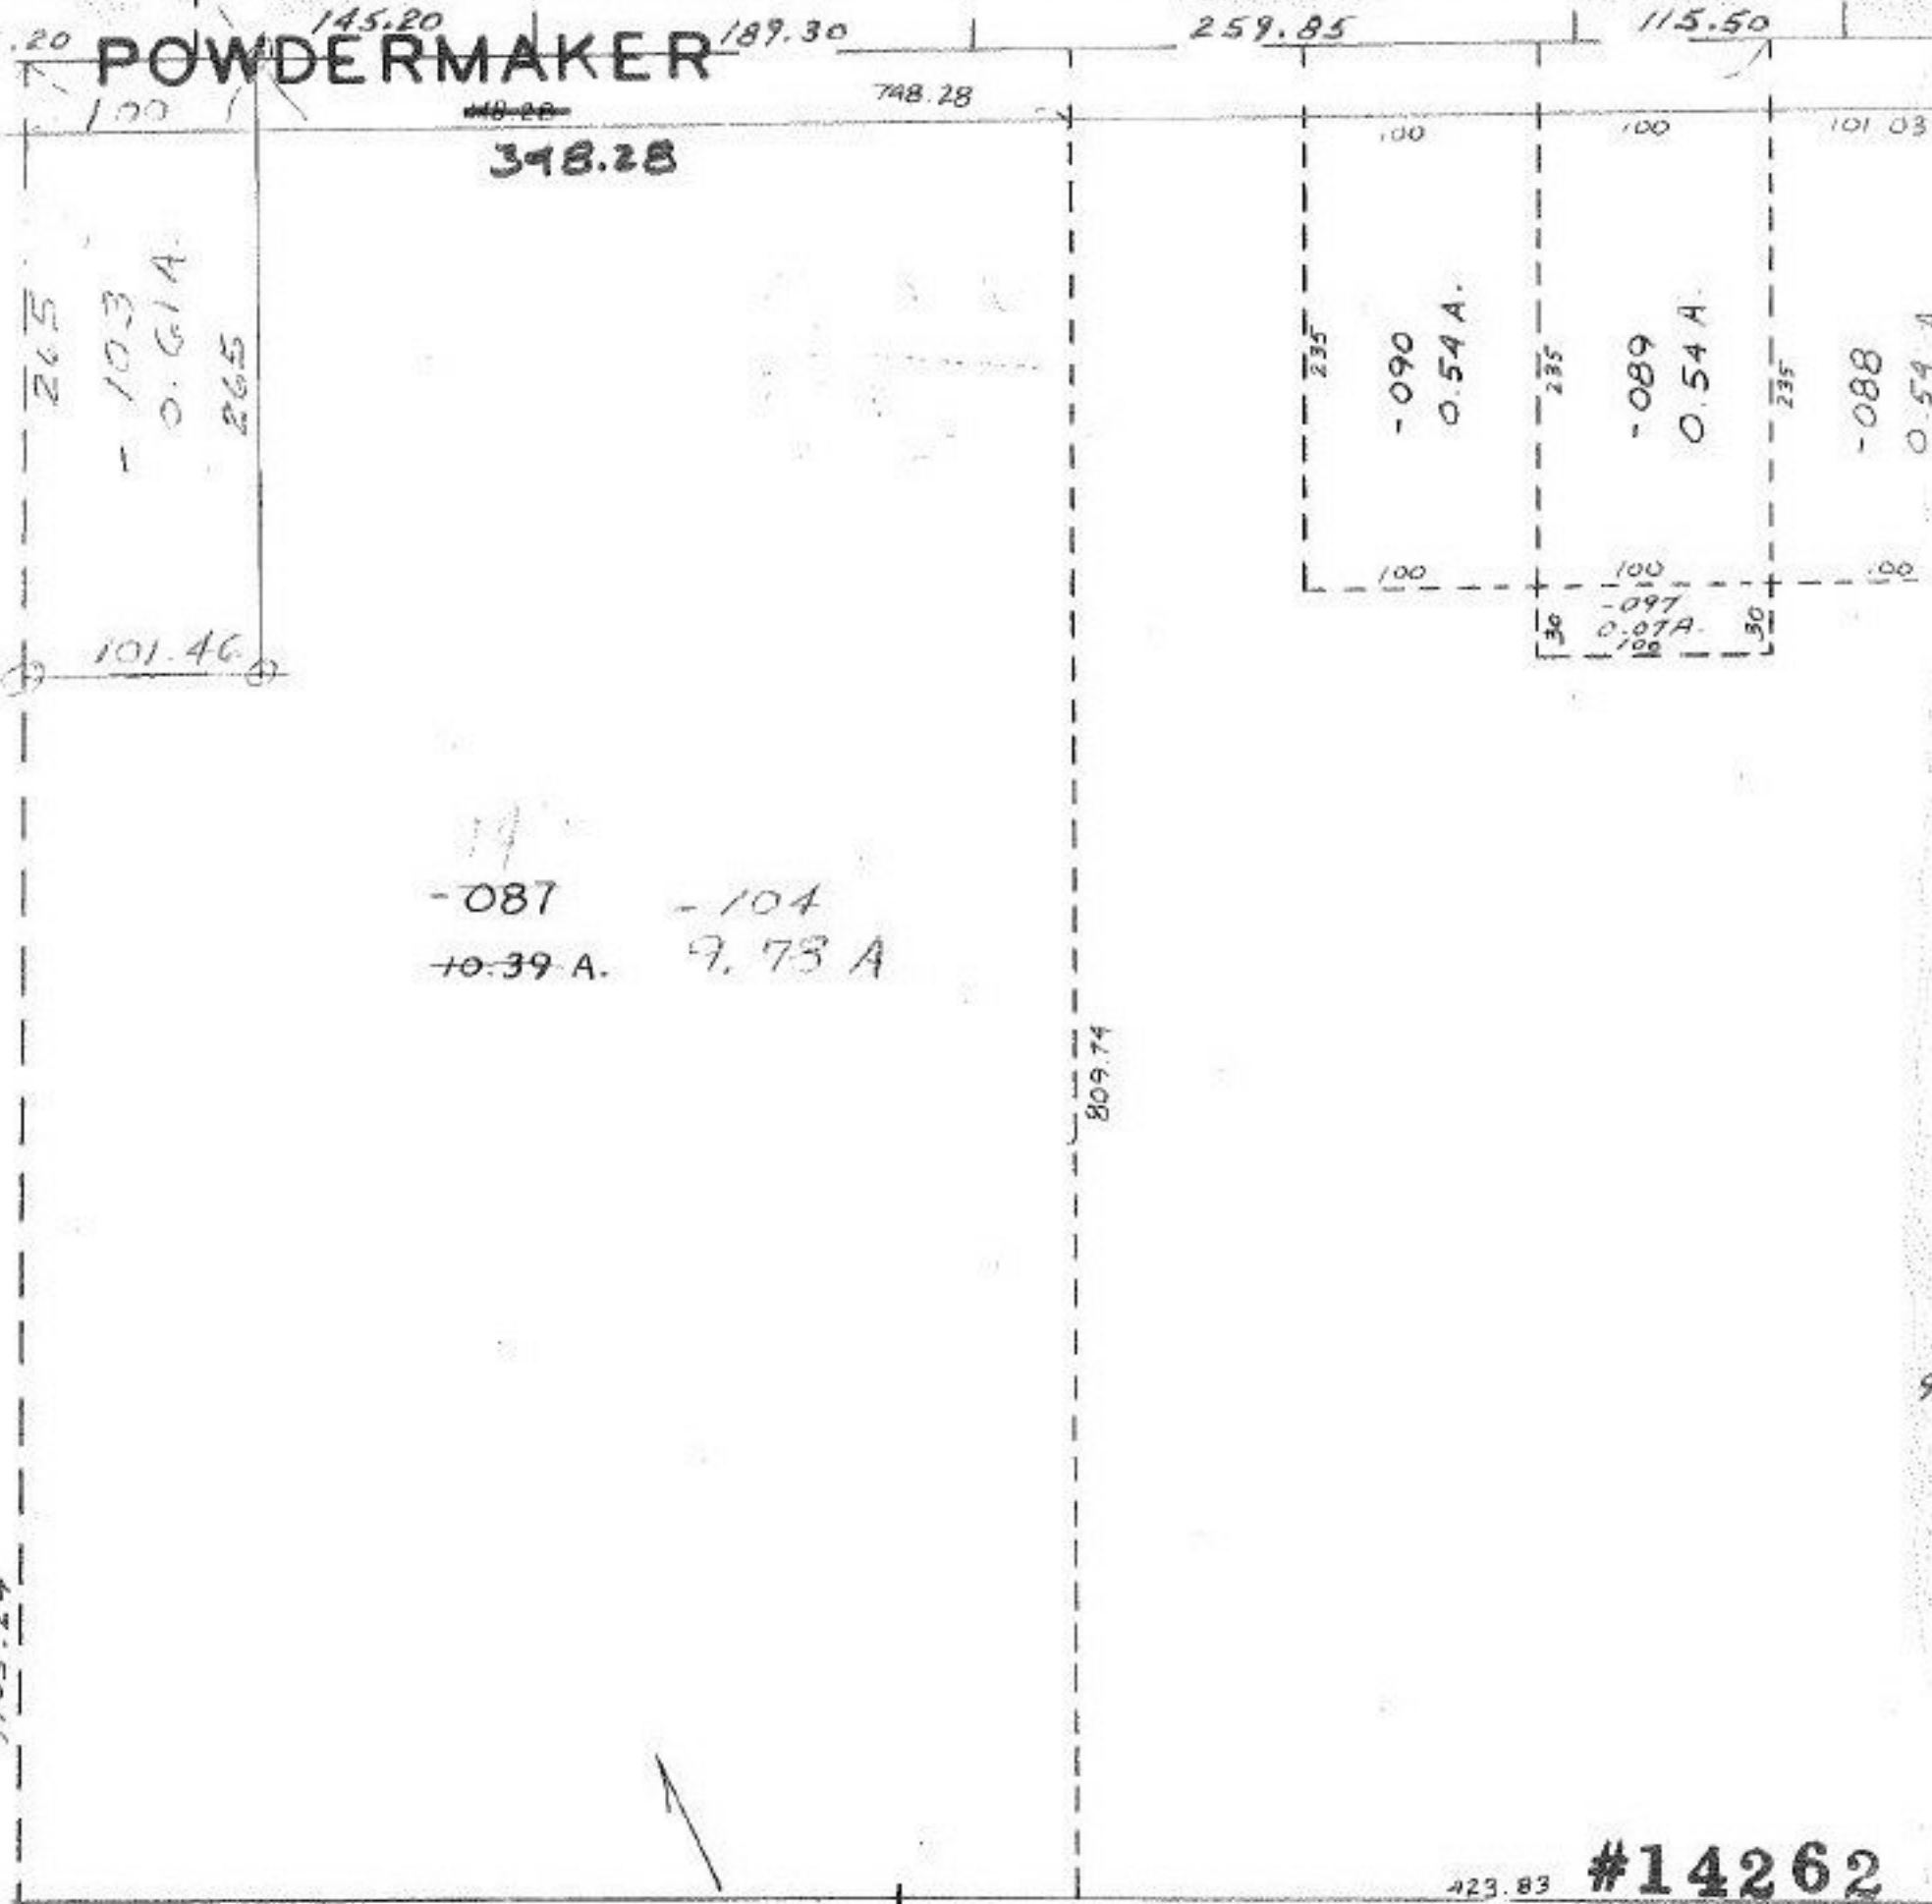

INTERSTATE

#14262

JAN 8 1982

APPROVED LORAIN CO. MAP DEPT.	
DATE	6-22-81
PAGE	4-22-007-11
BY	7.82 A.M.
VOID AFTER	14262