

100
150
200
(OBERLIN NORTH)
241.03
317.28

148.75
104.70
58


100
150
200
82, 164.38

170.78
130.53

241.03
130.53
104.70

100
150
200

100
150
200

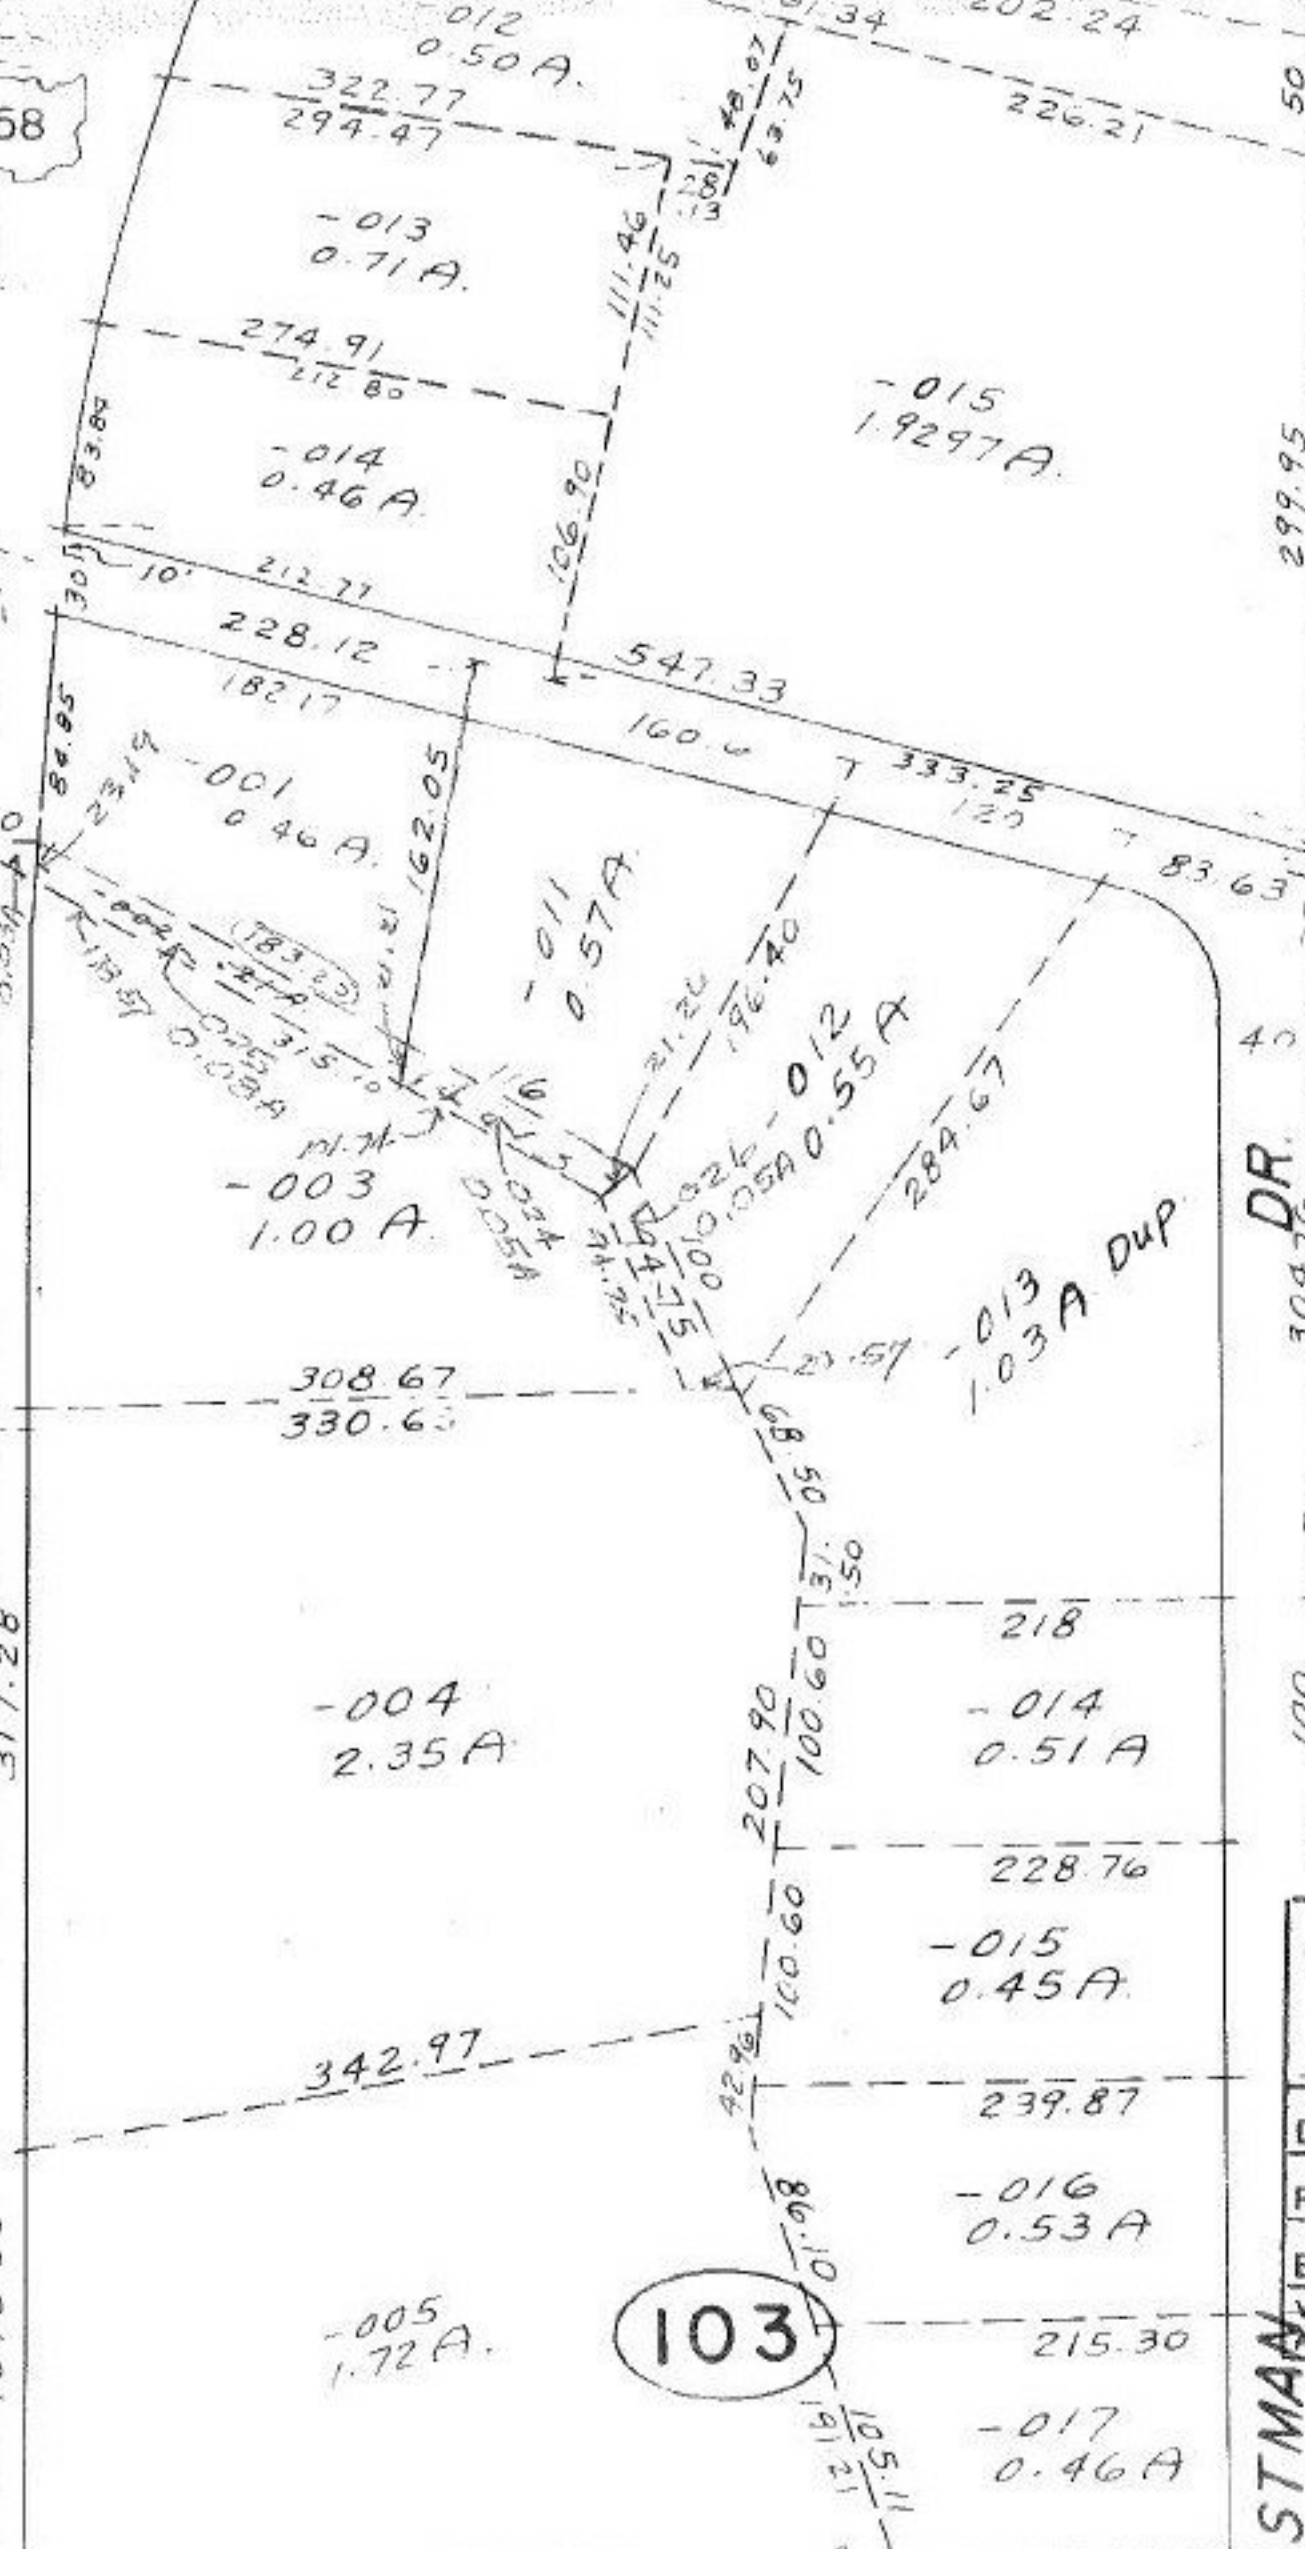

DR.
304.78

ASTMAN
481.13

T.M.
1.5.82

#14273

APPROVED LORAIN CO. MAP DEPT.	
DATE 6-29-81	
PAGE 02-02-003	
BY <i>Catchy</i>	
VOID AFTER	

103

102
27A