


MAP CORR.
ONLY

#14279

APPROVED
LORAIN CO.
MAP DEPT.
DATE 7-1-81
PAGE 1-K
BY *[Signature]*
VOID AFTER

T.M.
12-23-81

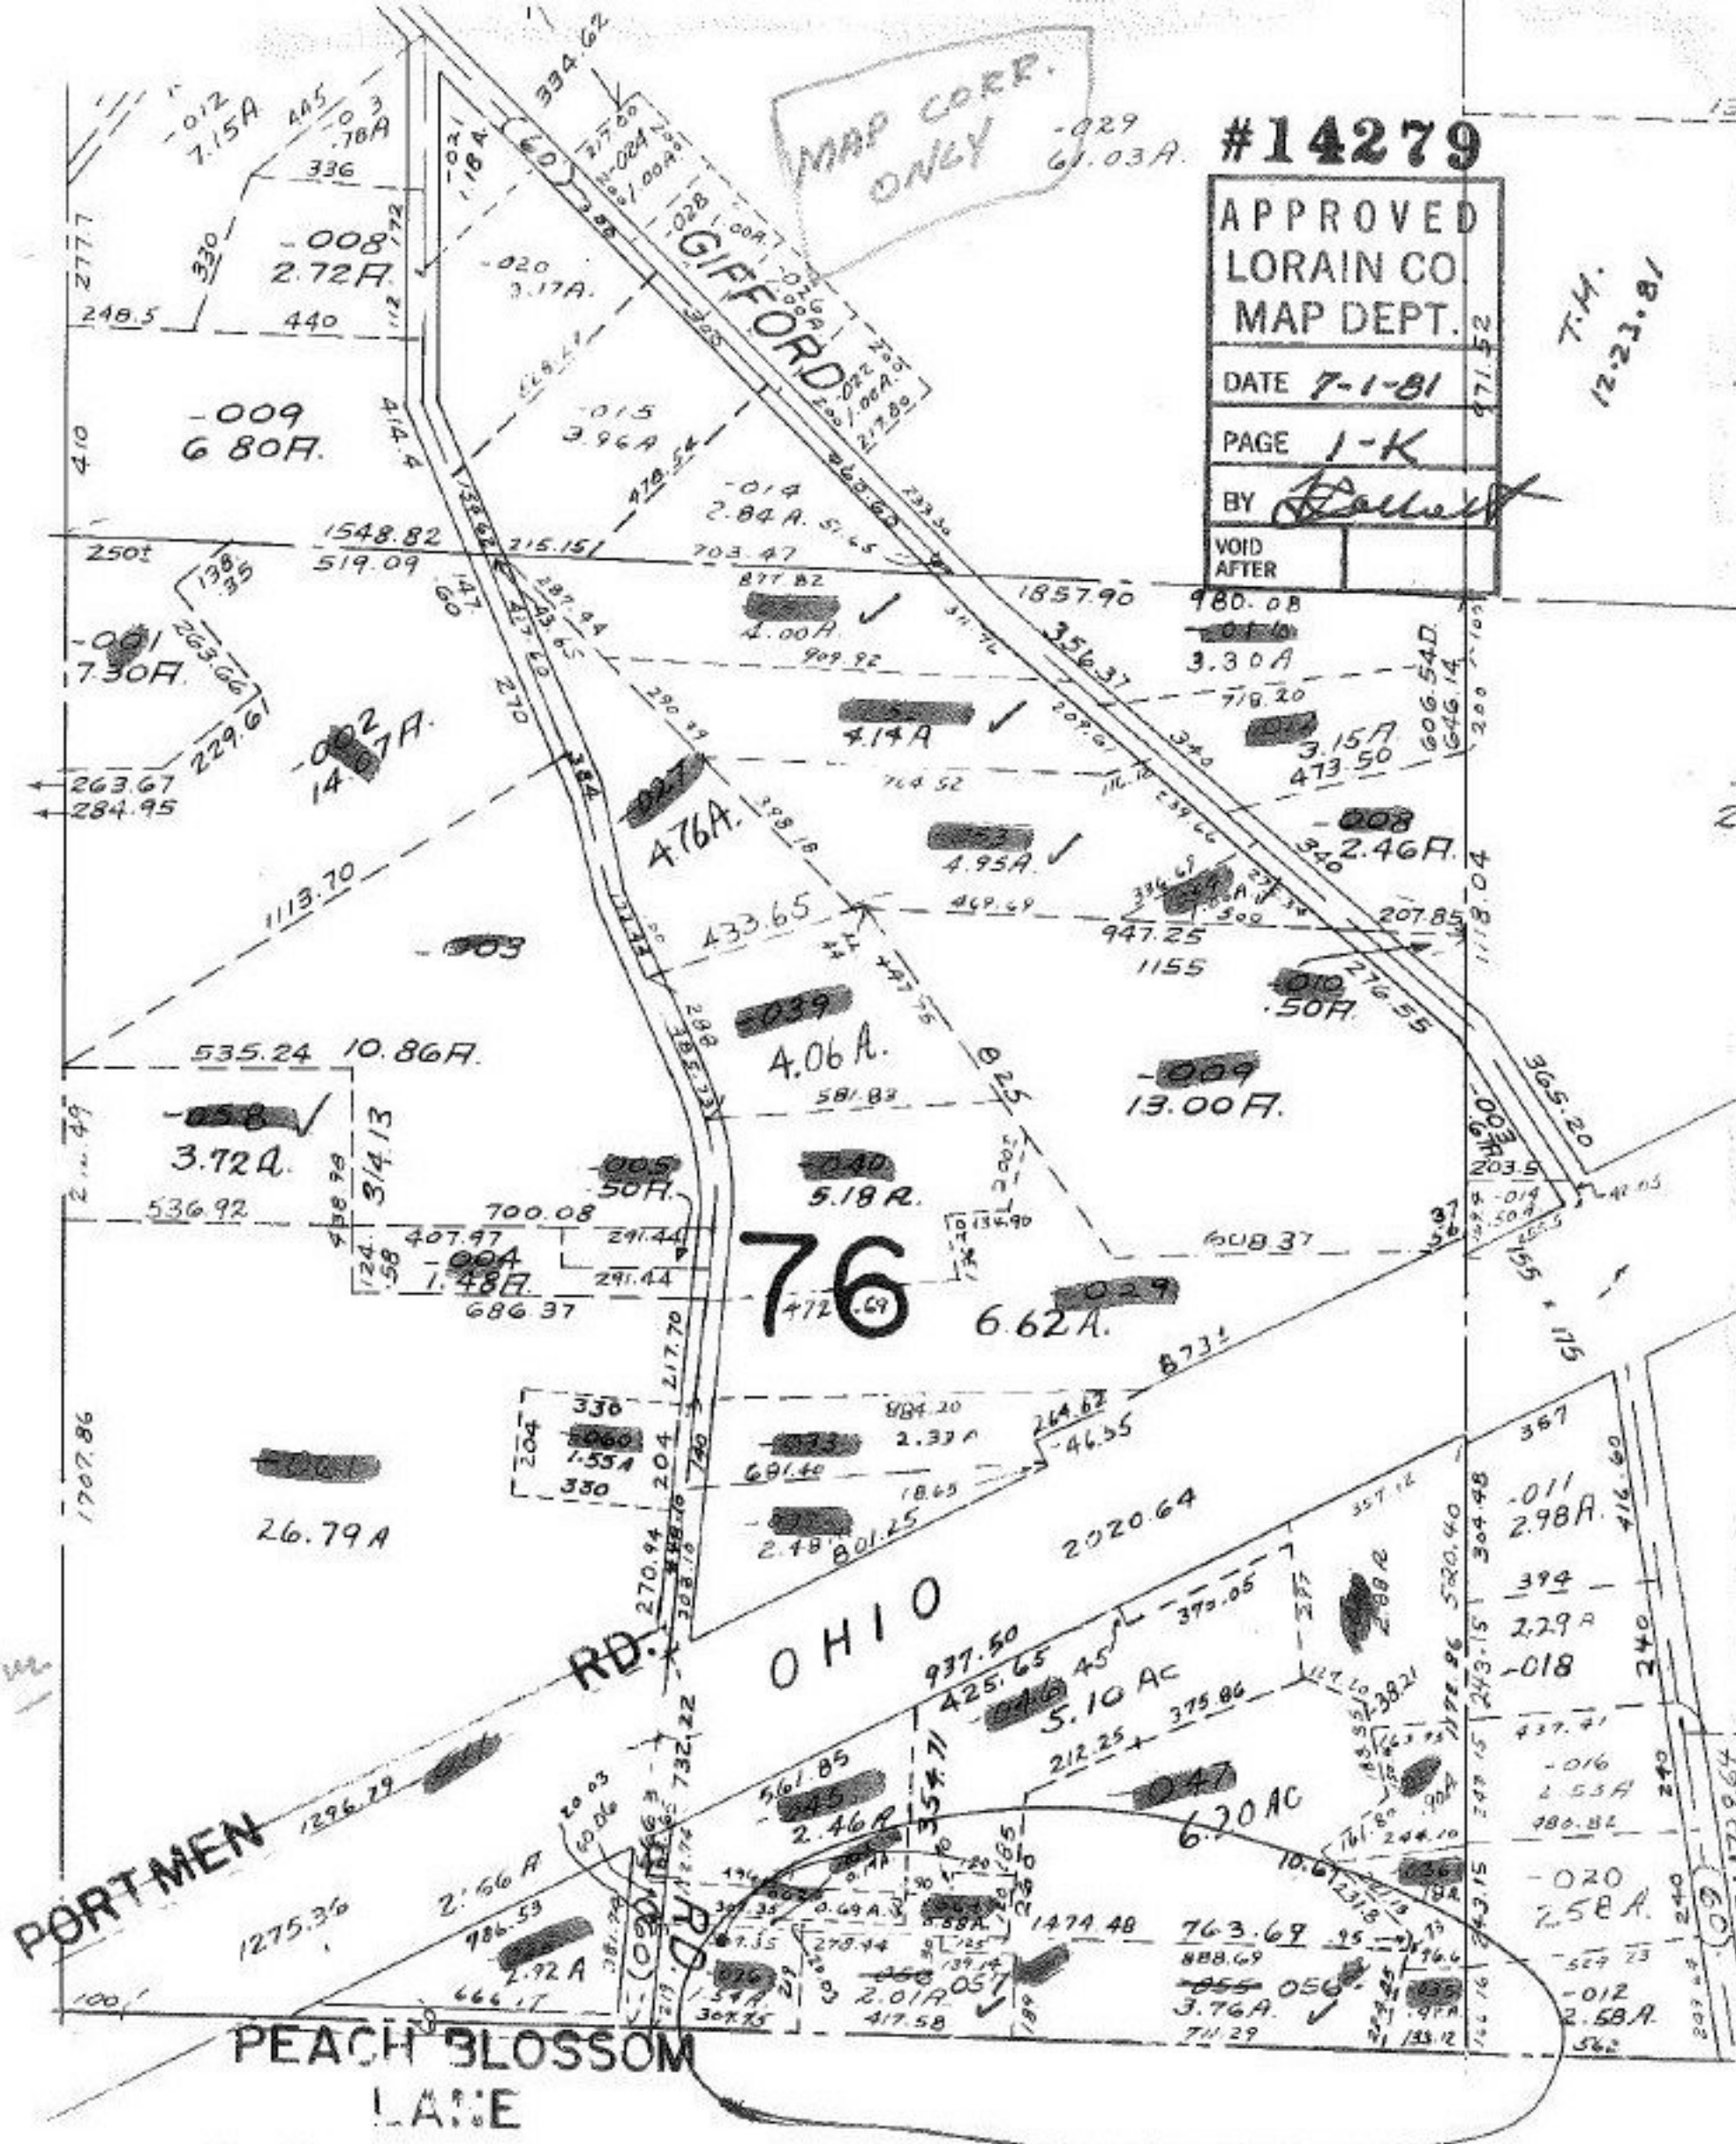

Co. Comm. Res. No 77-118
2-22-1977