


SEE 6-24

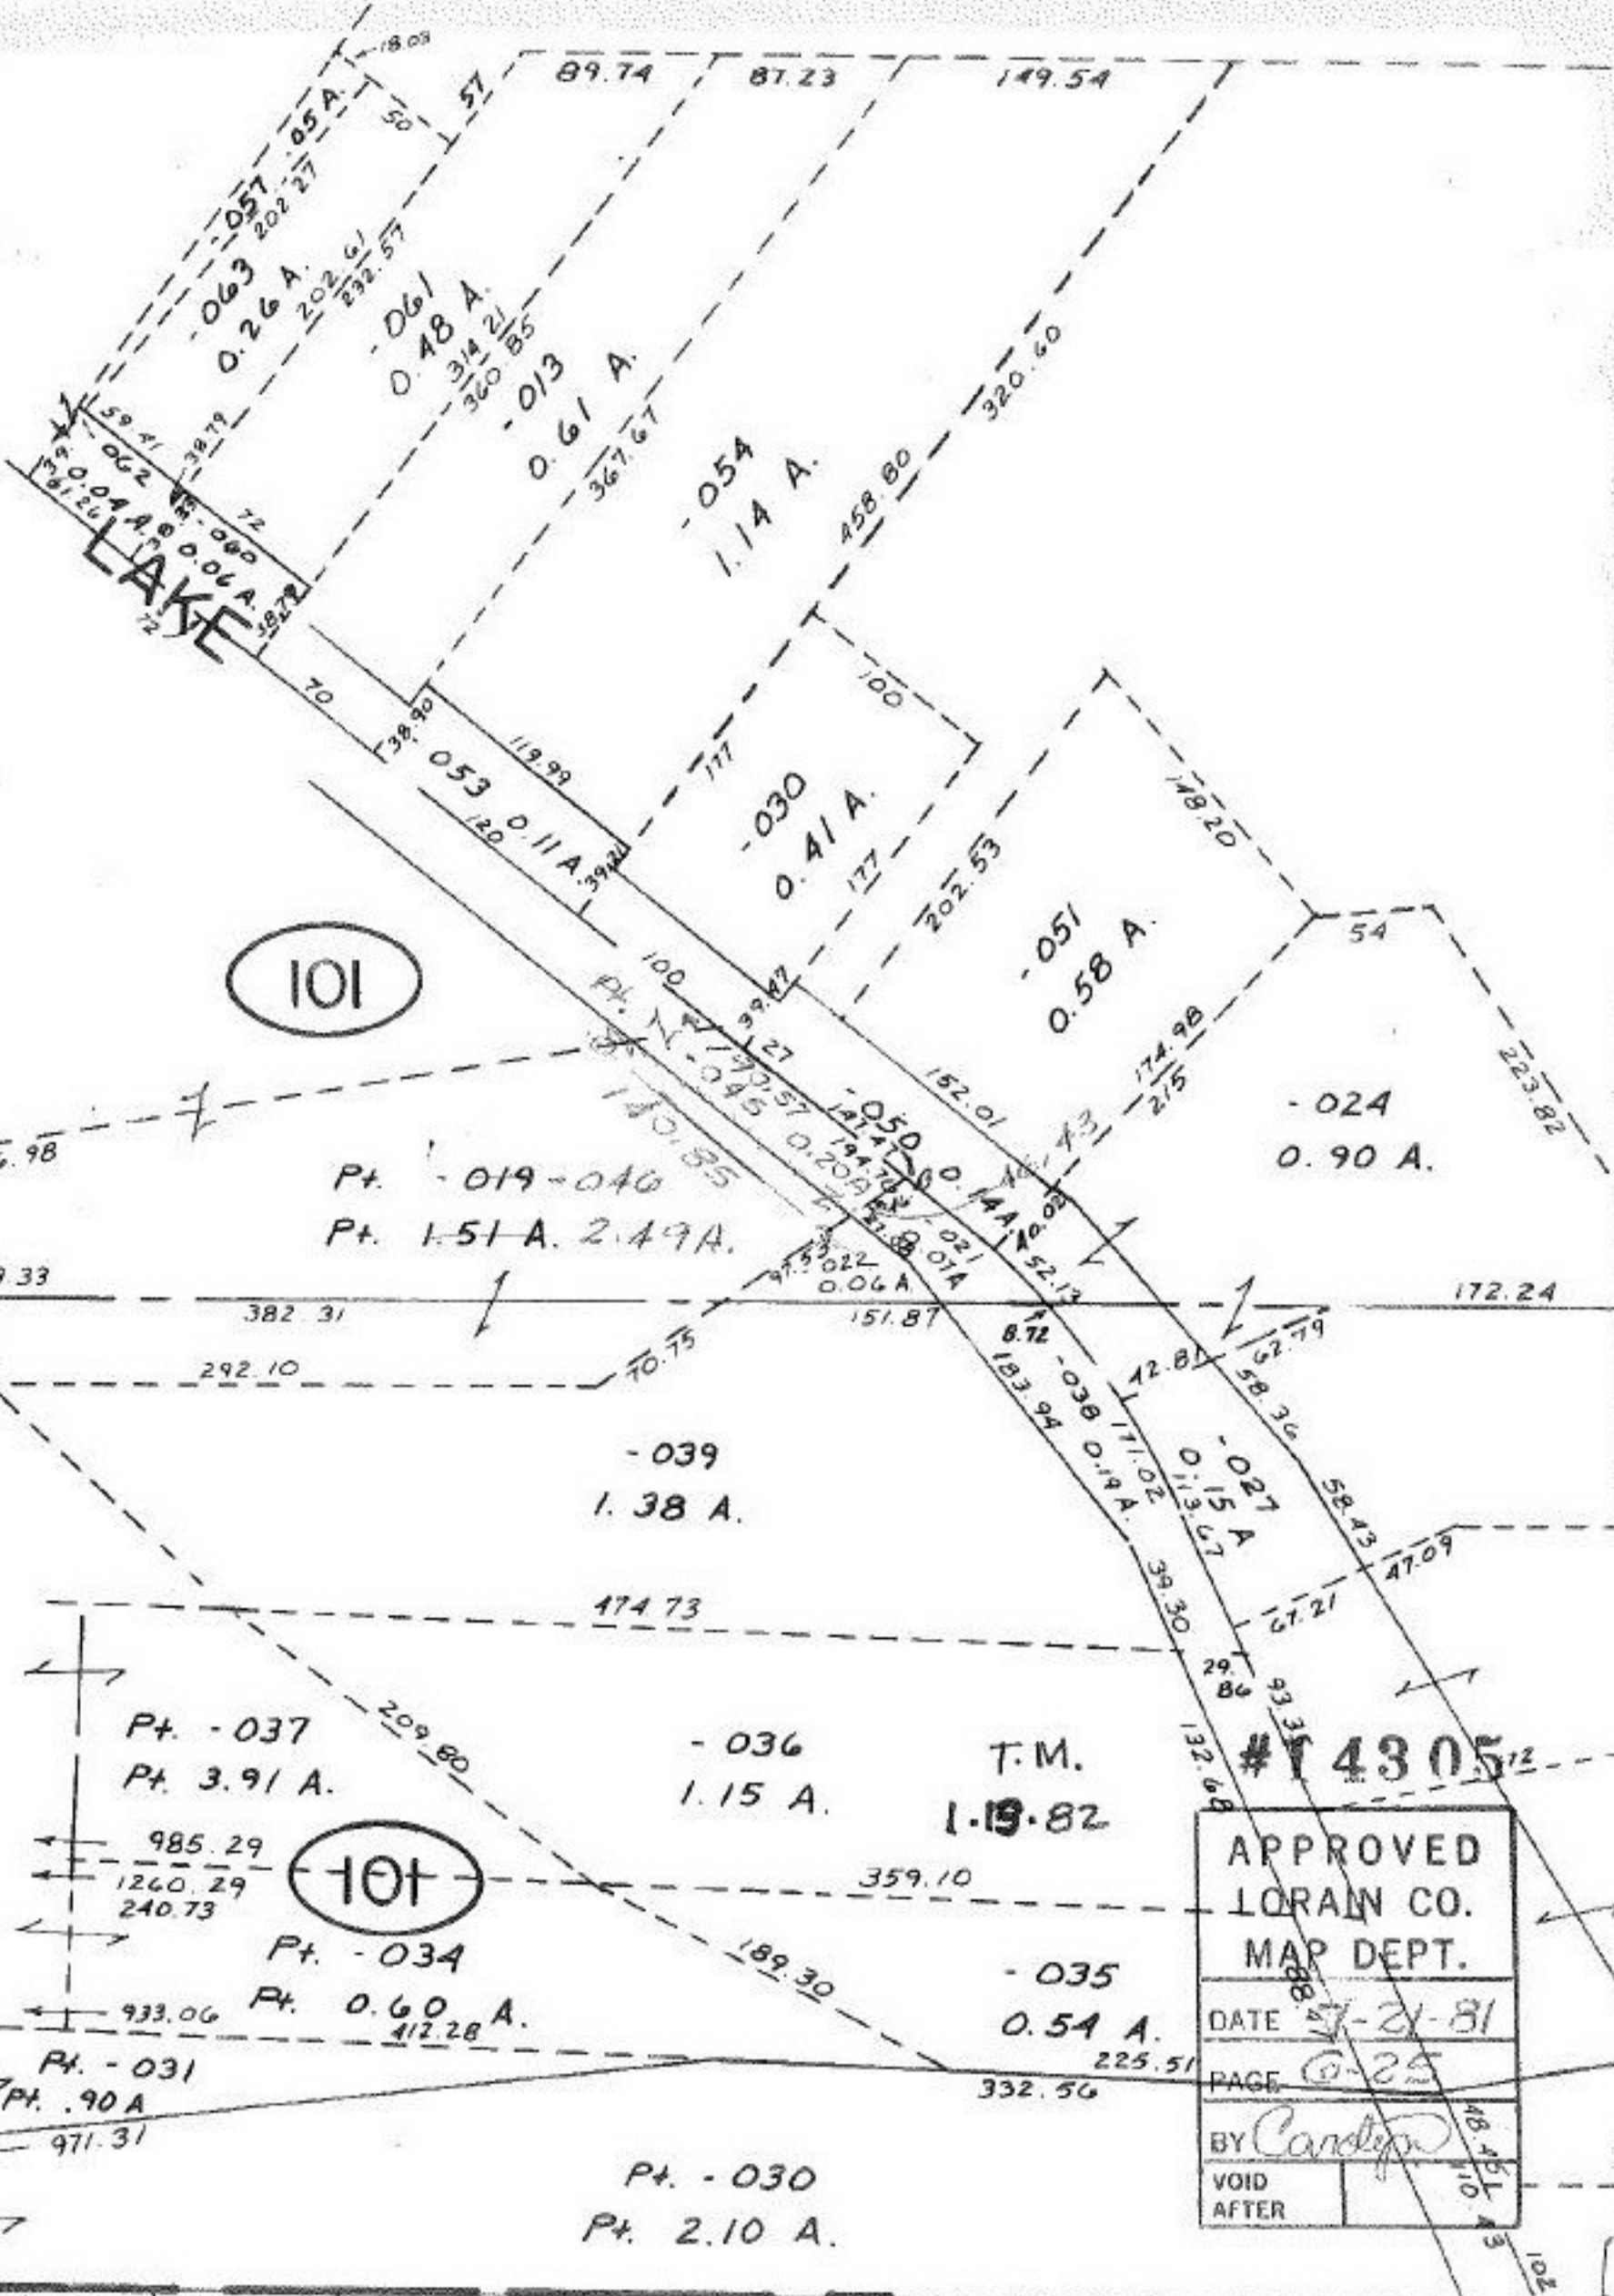

101

101

APPROVED  
 LORAIN CO.  
 MAP DEPT.  
 DATE 5-21-81  
 PAGE 25  
 BY *Cardigan*  
 VOID AFTER

85    "    85    85    85.11    301.79