

11-B

SHEFFIELD TWP

367.25 ELYA CITY CORP. (LINE)

130.49

-153

1.03A

359.78

89°34'

107.56

40'

R.D.

#14318 void  
12-2-81 C.S.

~~Pt. -099~~ -152  
~~Pt. 40.2A~~ 24.76A.

~~Pt. -154~~

~~Pt. -156~~ ~~Pt. 23.68A.~~

~~Pt. 32.36A.~~


~~Pt. -154~~

~~Pt. 23.63A~~

72A


779.11

777.94

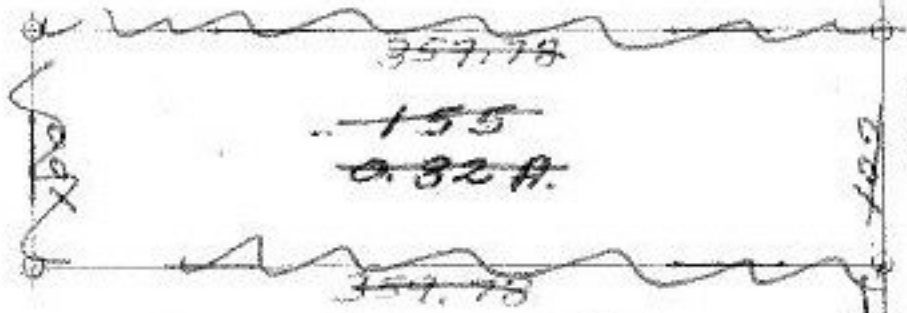

~~#14318~~  
#14317

LOYOLA DRIVE

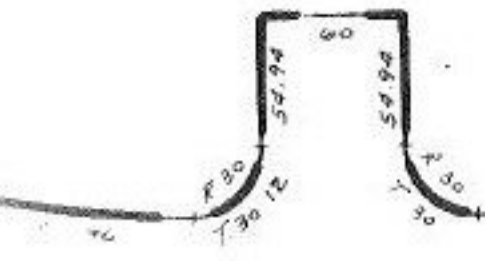

T.M.  
1.12.82

APPROVED	
LORAIN CO.	
MAP DEPT.	
DATE	3-5-81
PAGE	159 78 15 C-16
BY	Corley -096
VOID AFTER	0.82A.

-151  
0.82A.

100

100

330.12

440.12

557.27

329.65

100

70.34

70.34

-014

B30

100

84.11

84.11

81

81

29A

424.38

8716