


4000
3000
2000

SEE 10-00-004-D

MEDIANA SEE 10-00-004-E

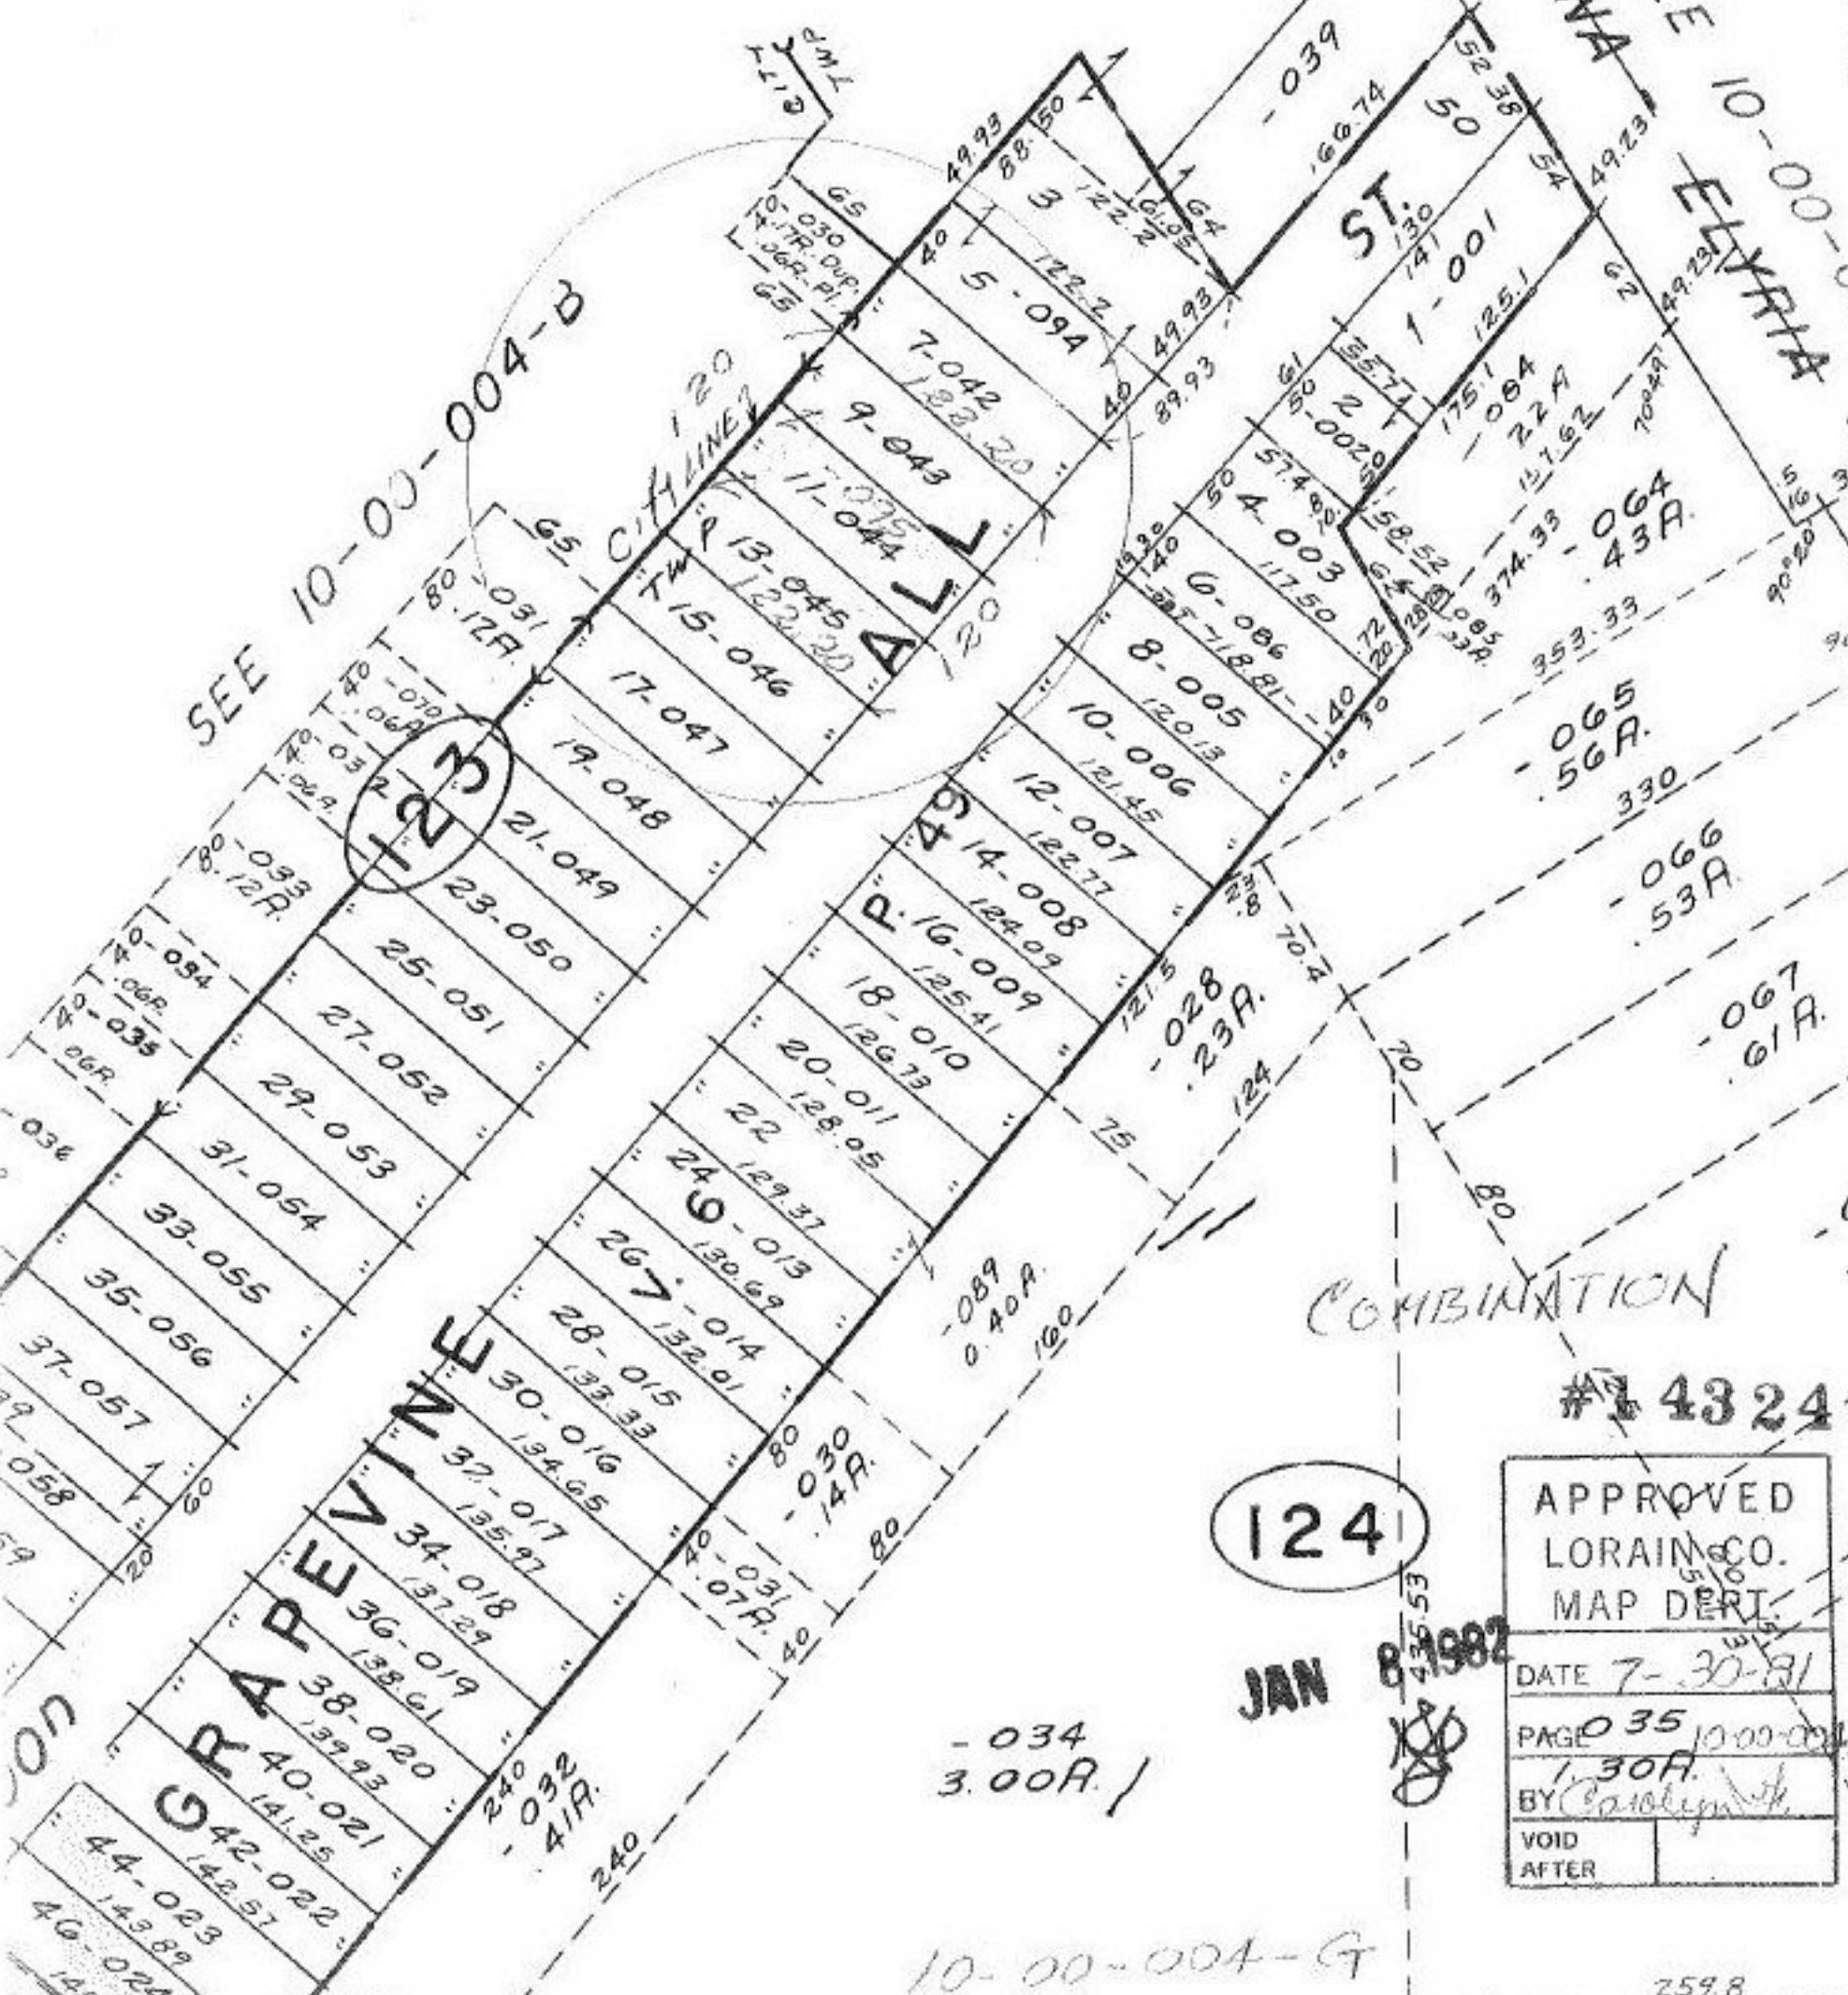

124

124

JAN 8 1982

- 034
3.00A. /

10-00-004-G

#14324

APPROVED LORAIN CO. MAP DEPT.	
DATE	7-30-81
PAGE	035
BY	Carolyn [Signature]
VOID AFTER	