


~~- 202~~
~~16.76~~ A.

- 208
16.08A.

- 210
15.61A.

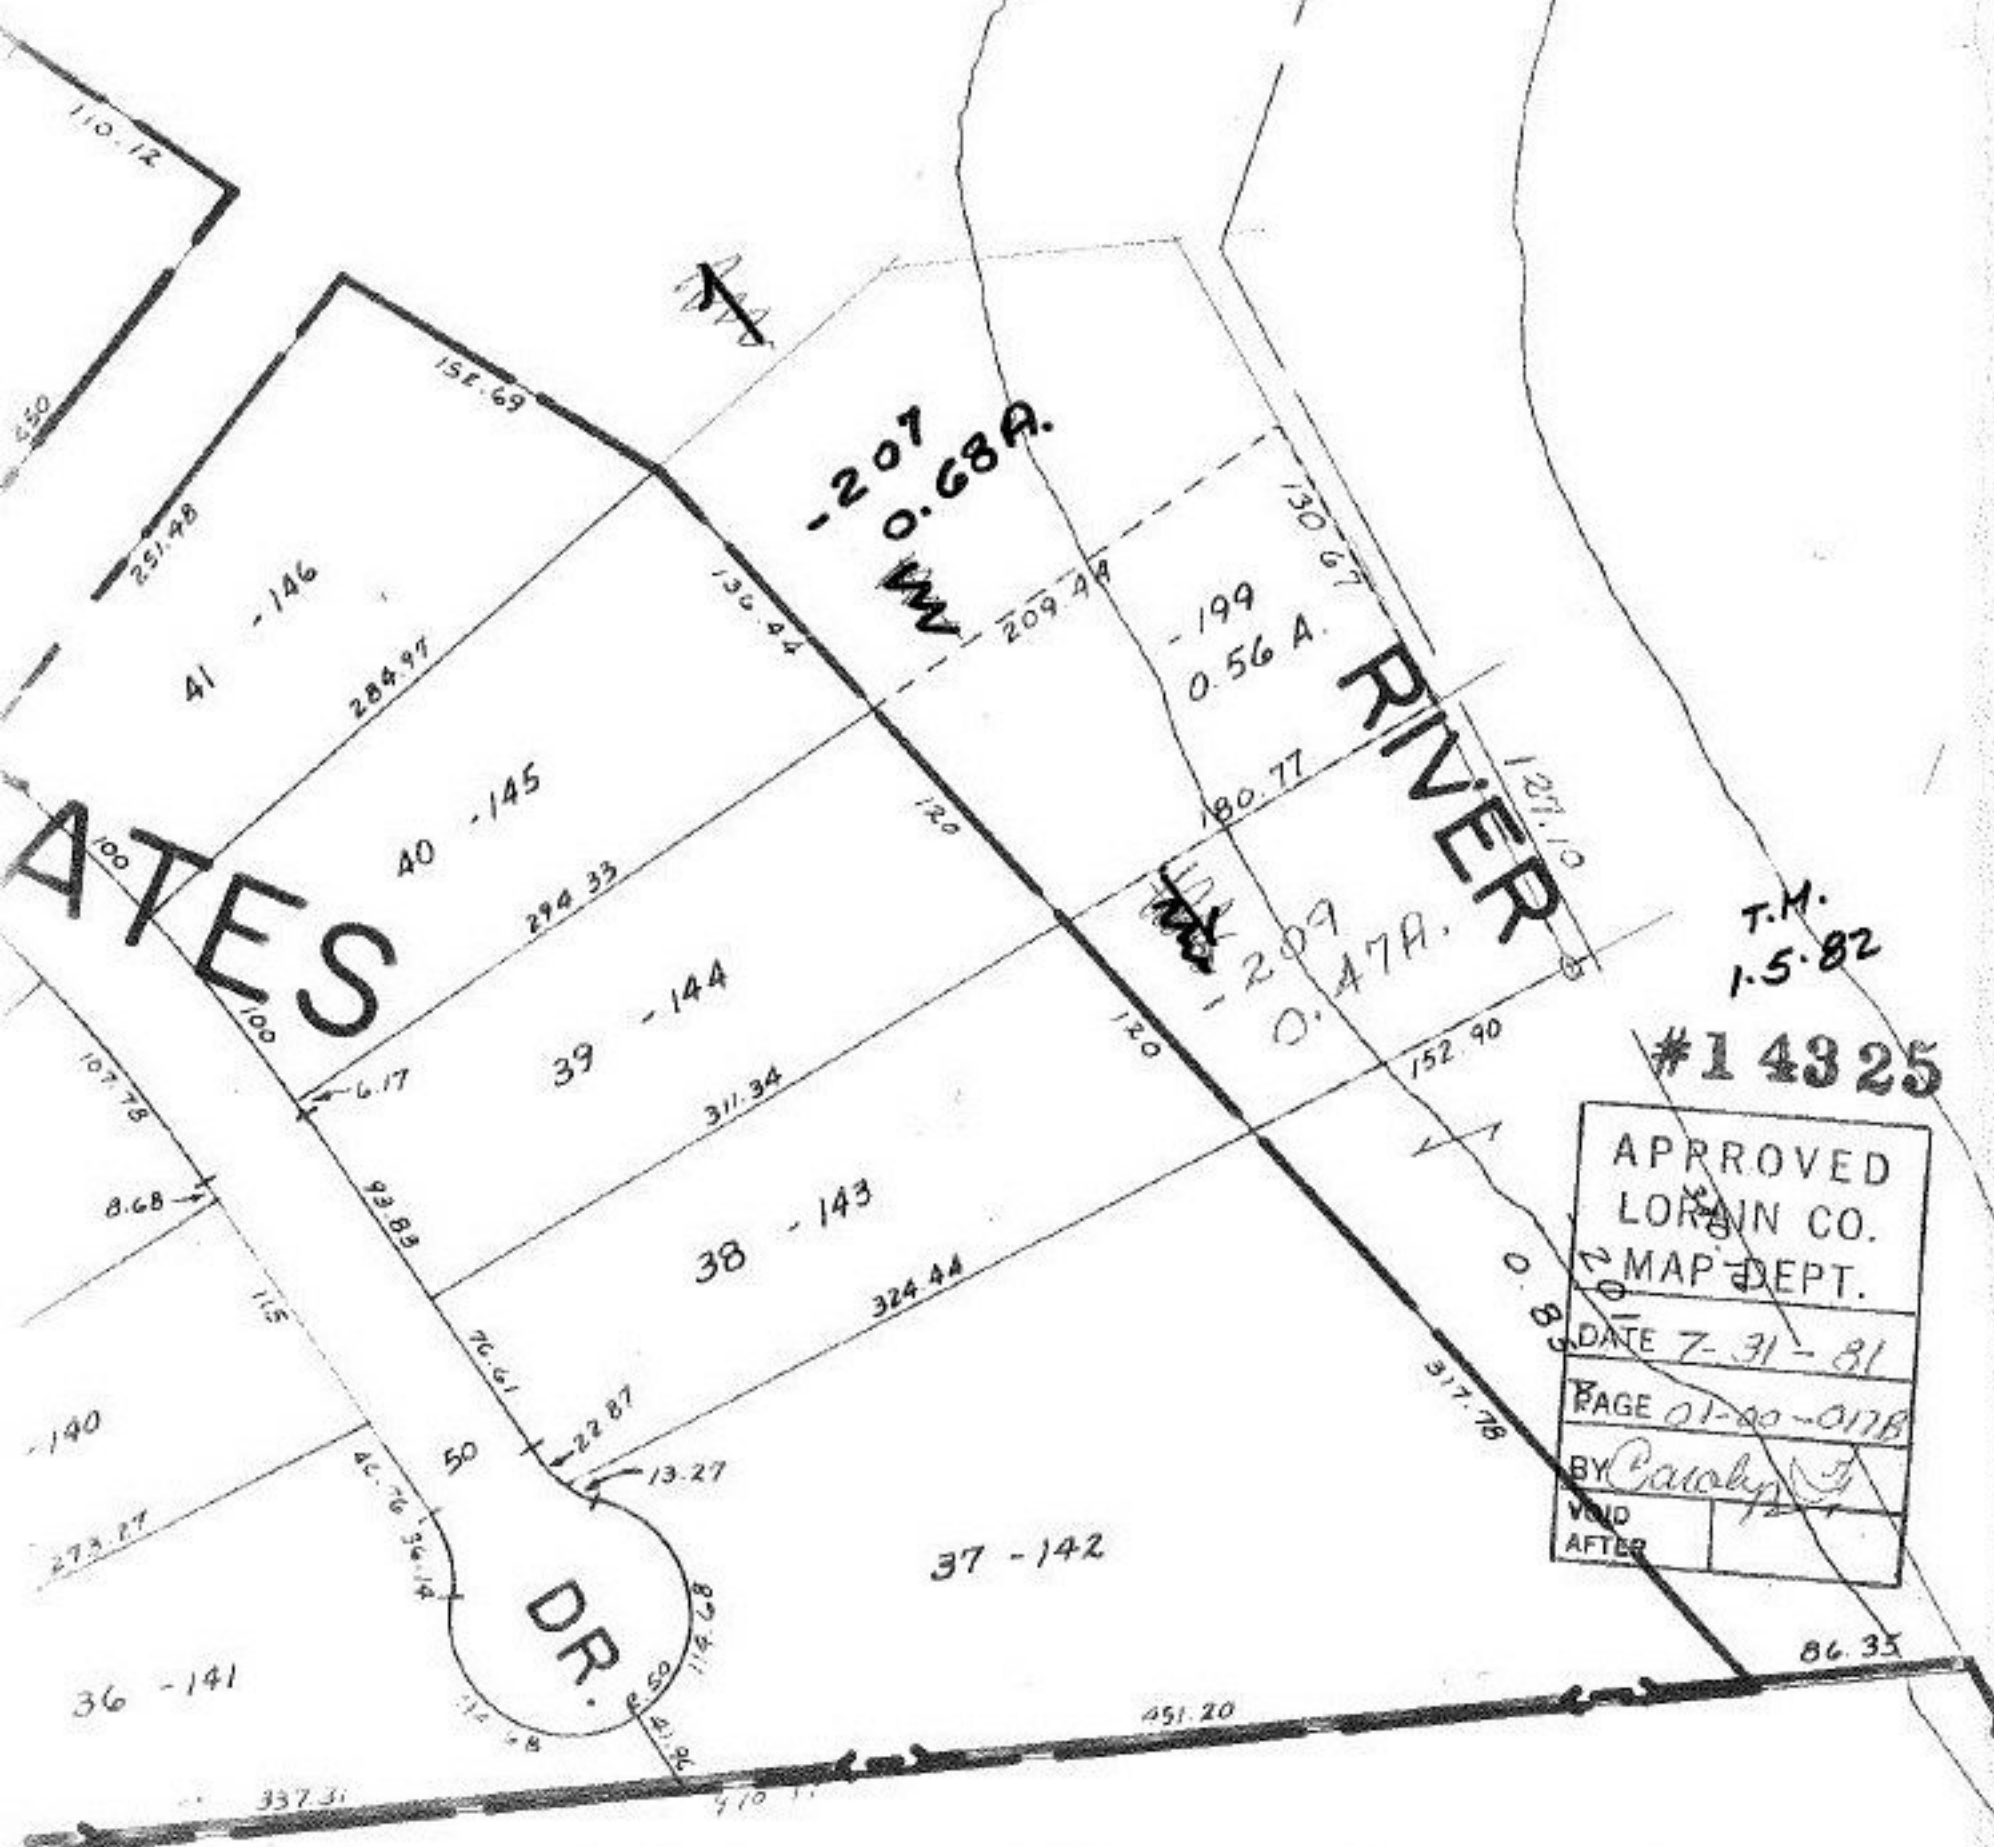

- 207
0.68A.

- 199
0.56 A.

- 209
0.47A.

T.M.
1.5.82

#14325

APPROVED	
LORAIN CO.	
MAP DEPT.	
DATE 7-31-81	
PAGE 01-00-0178	
BY Carolyn J.	
VOID	AFTER

DR.

RIVER

110.12

251.98

284.97

294.33

311.34

324.44

337.31

374.11

410.11

451.20

151.69

130.44

120

120

130.67

209.98

180.77

152.90

121.10

0.83

317.78

86.35

