


11-C

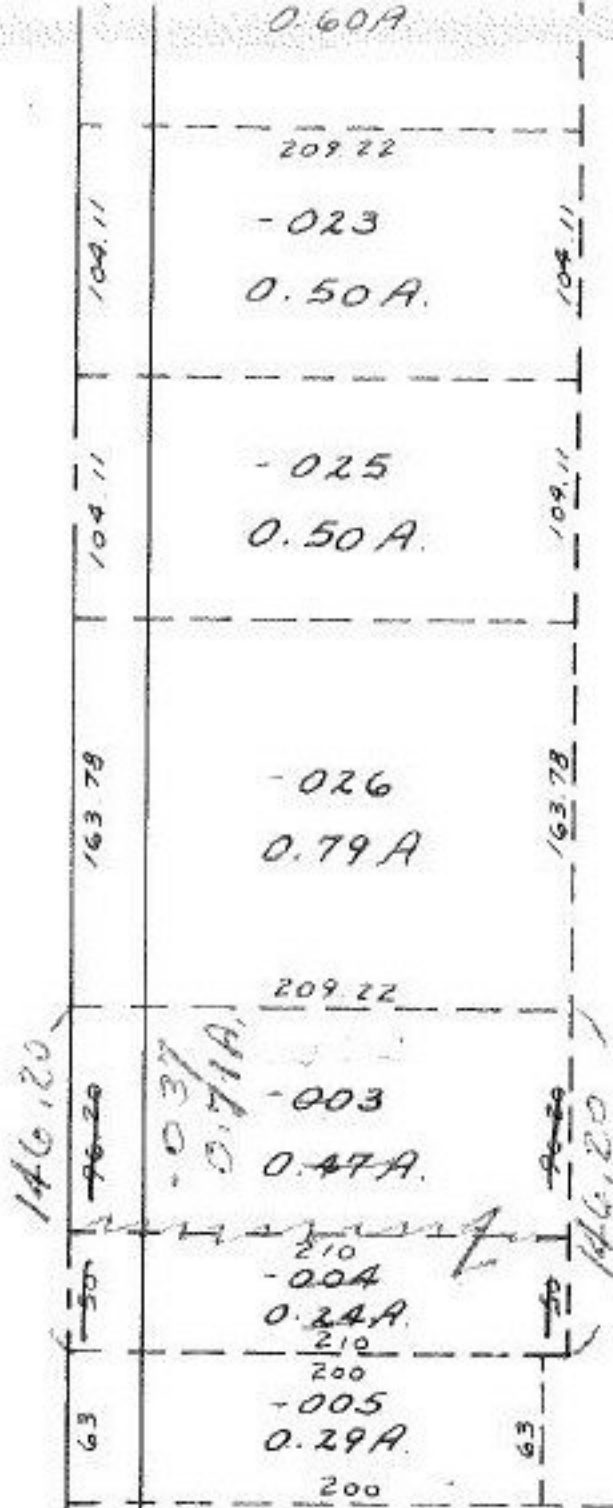

"Combination"

#14341

JAN 8 1982

JE

APPROVED
LORAIN CO.
MAP DEPT.
DATE 8-6-81
PAGE 11-00-030-A
BY Carolyn J.
VOID AFTER