


0-103

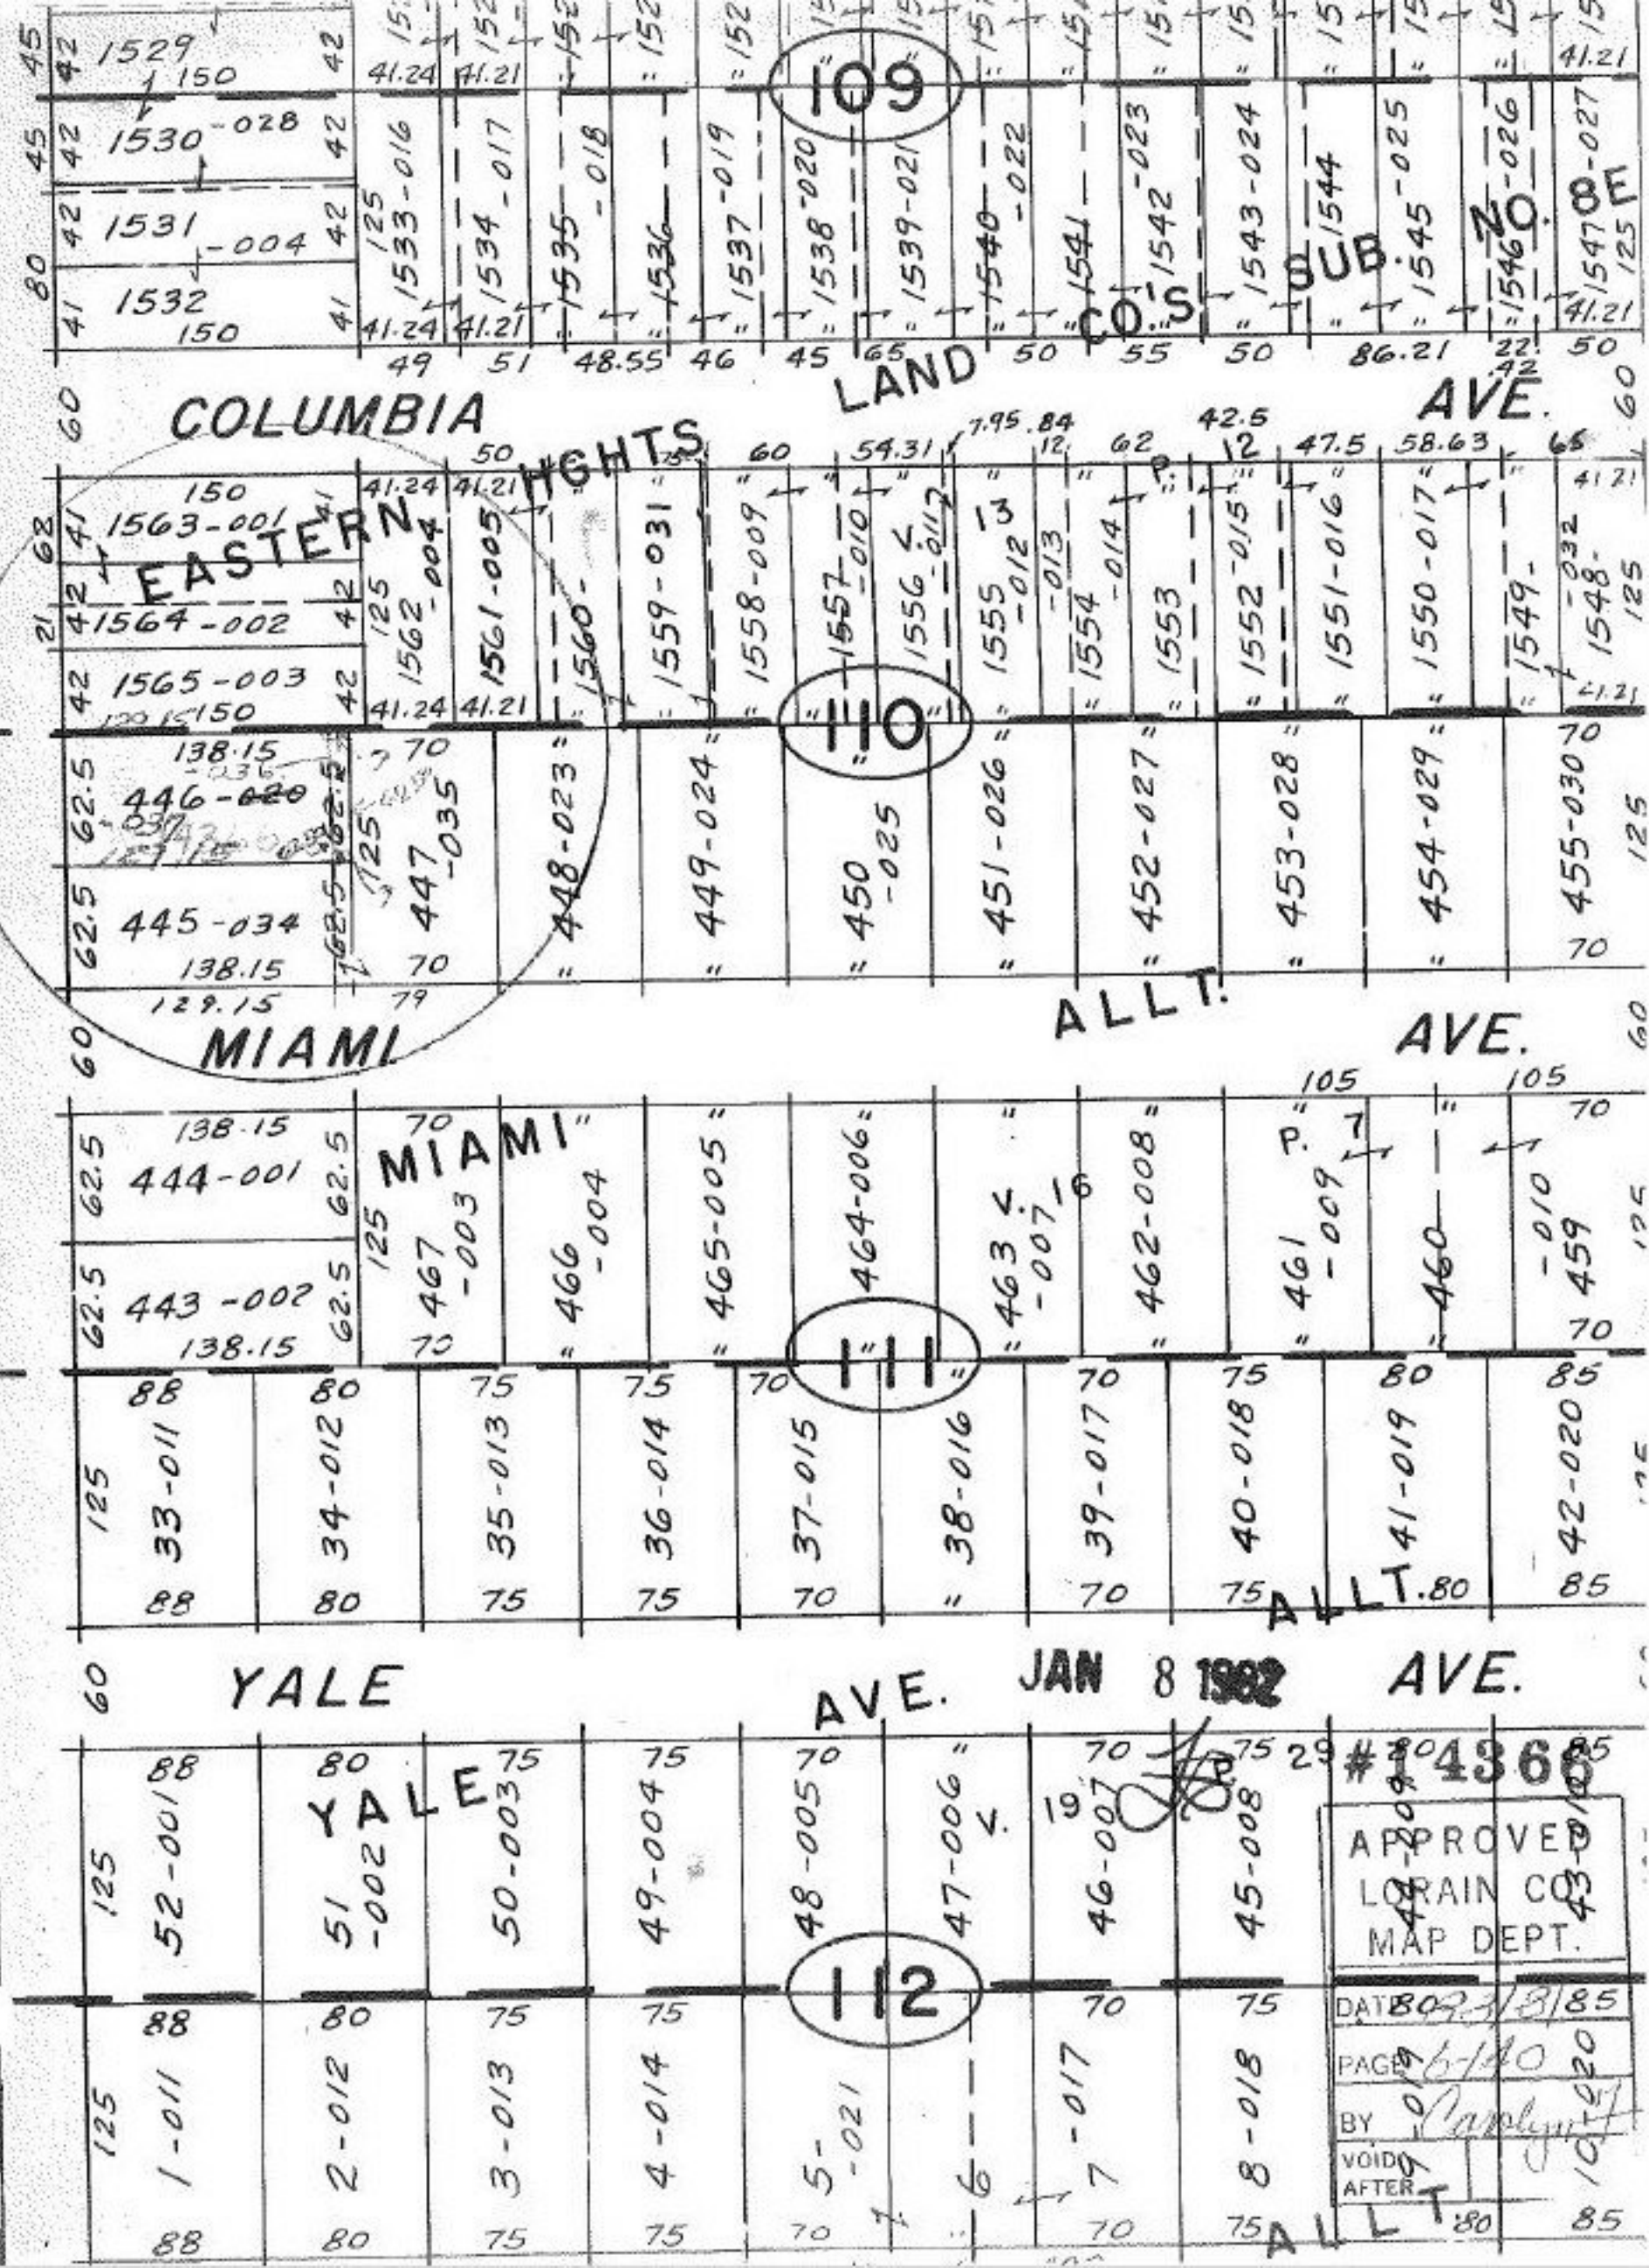

COLUMBIA AVE.

LAND

AVE.

EASTERN HEIGHTS

MIAMI

ALLT.

AVE.

YALE AVE.

AVE.

JAN 8 1982

AVE.

#14366

APPROVED
LORAIN CO.
MAP DEPT.

DATE 8/13/85

PAGE 6/40

BY [Signature]

VOID AFTER 10/20/85