


ELYRIA - TWINSBURG

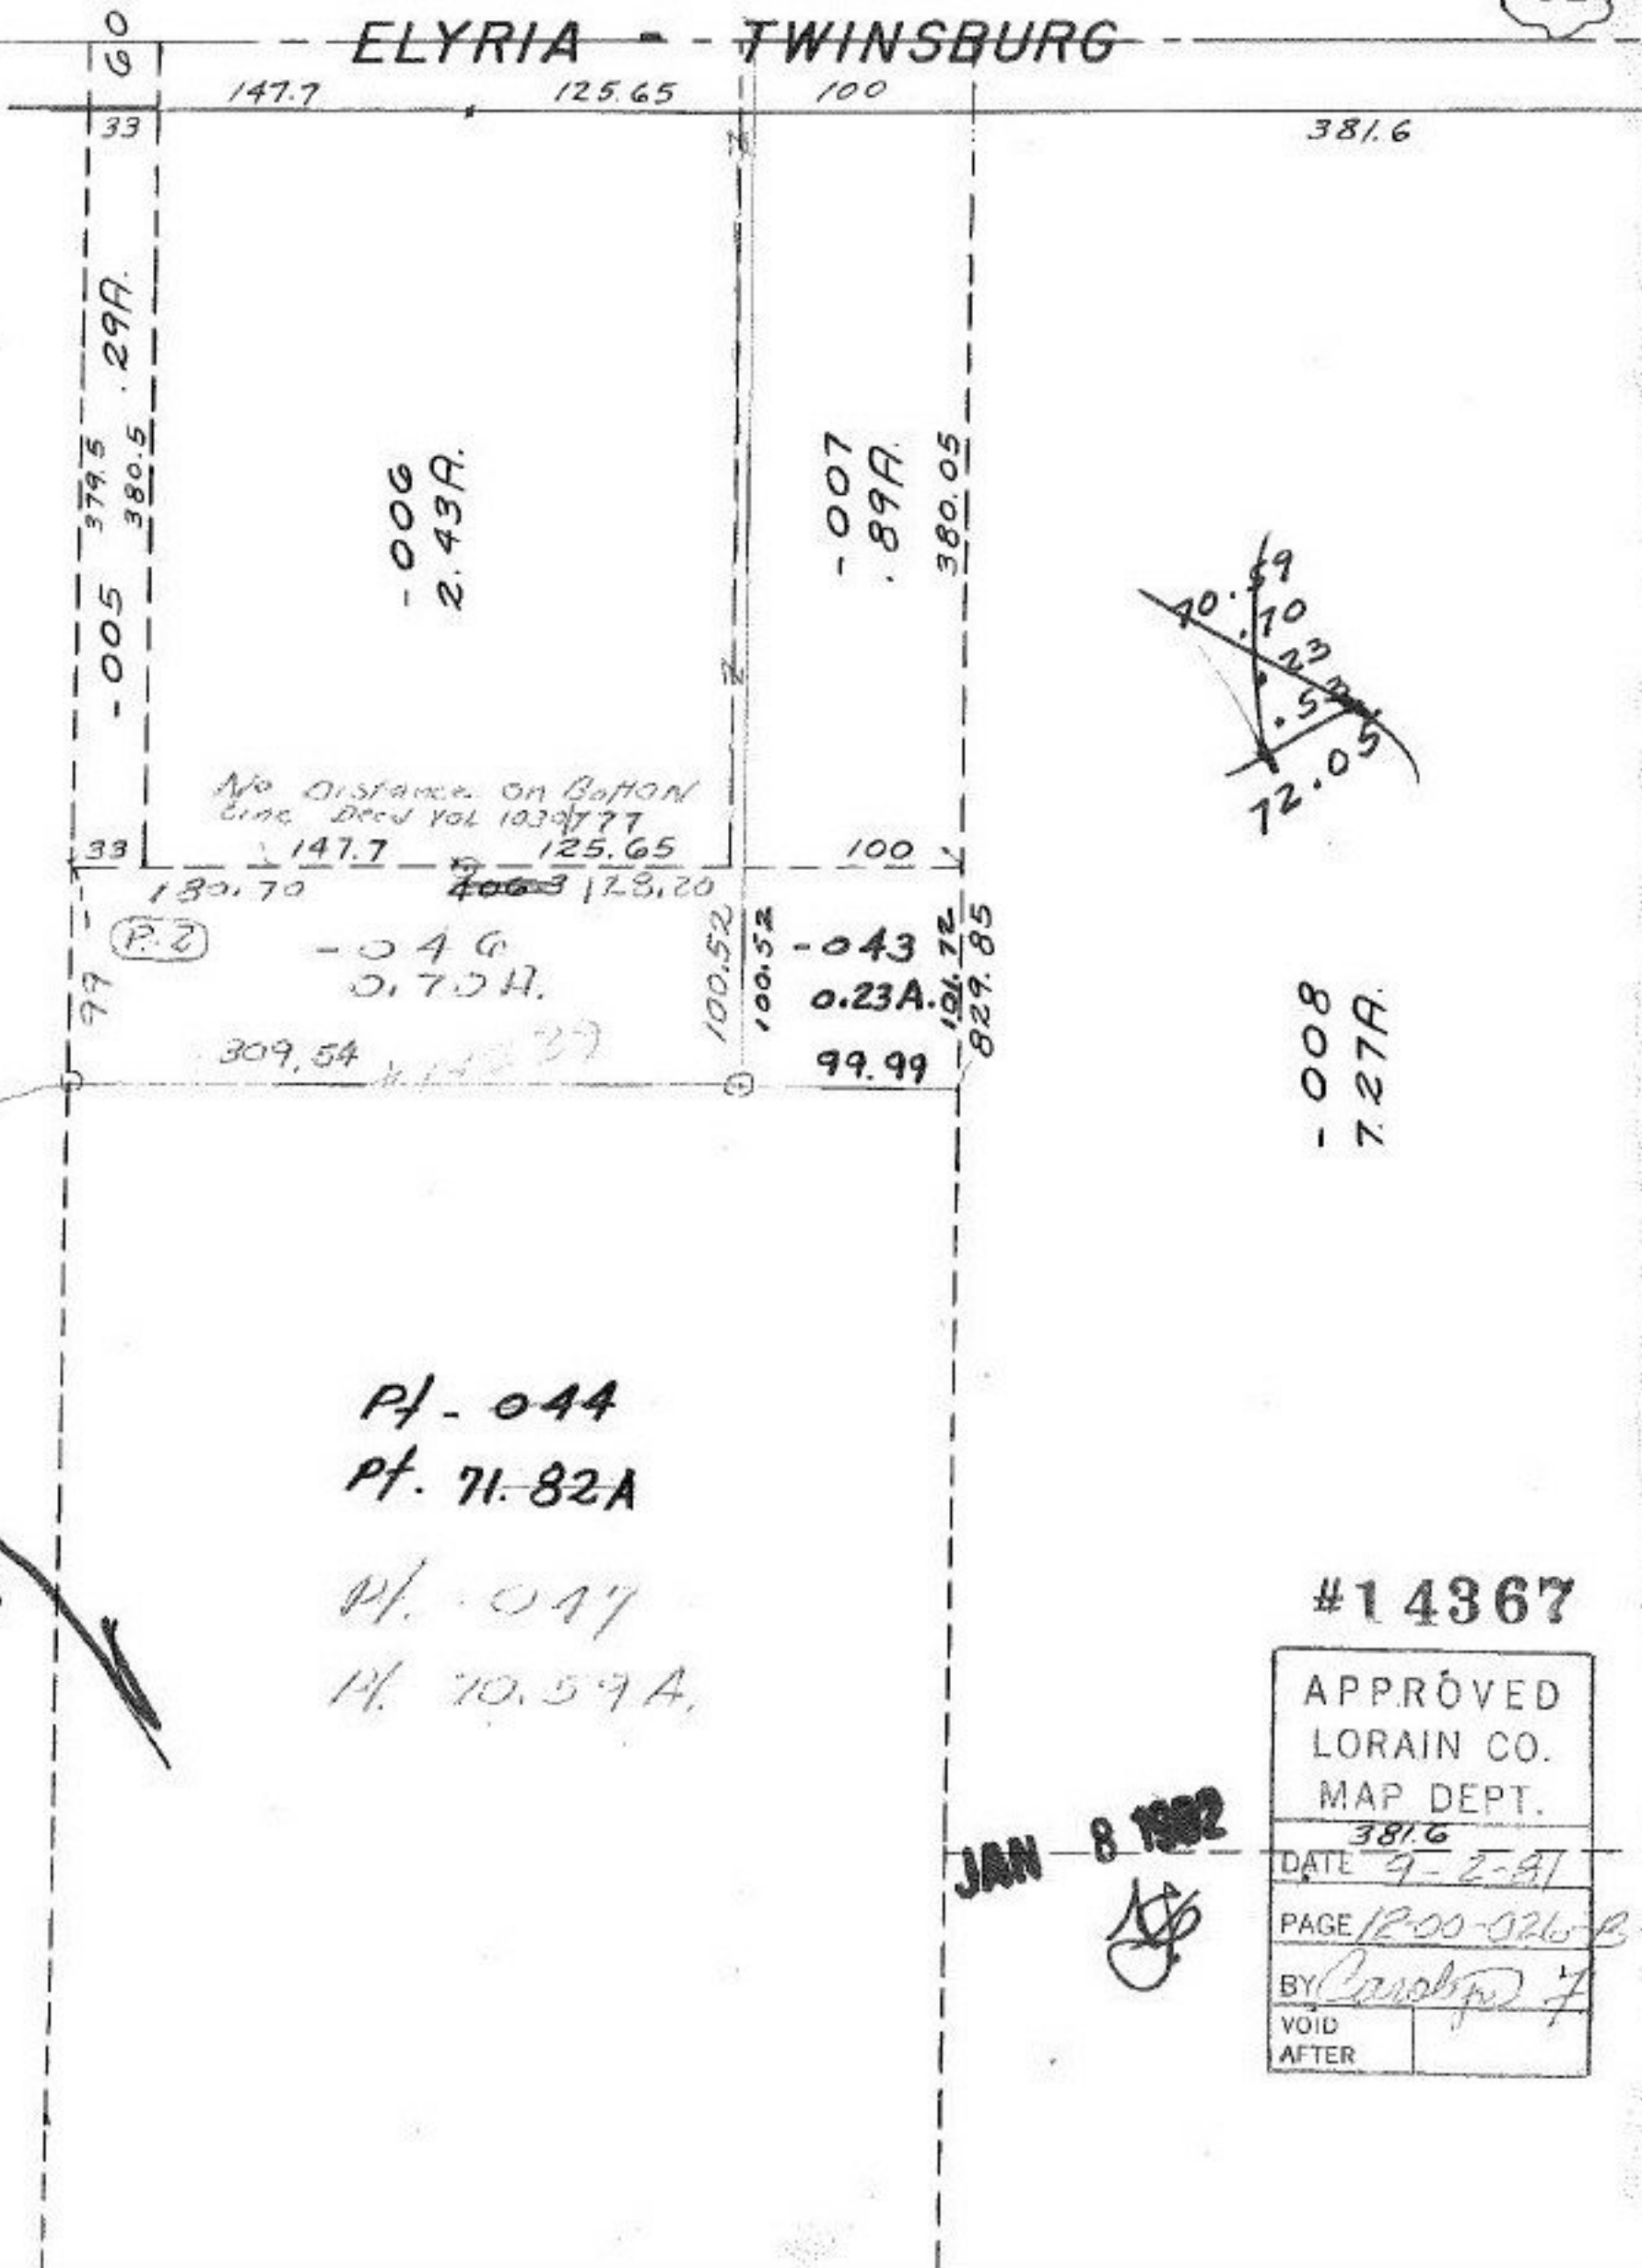

APPROVED LORAIN CO. MAP DEPT.	
DATE 9-2-81	
PAGE 12-00-026-B	
BY <i>Caroline</i>	
VOID AFTER	