


82

RD. 60

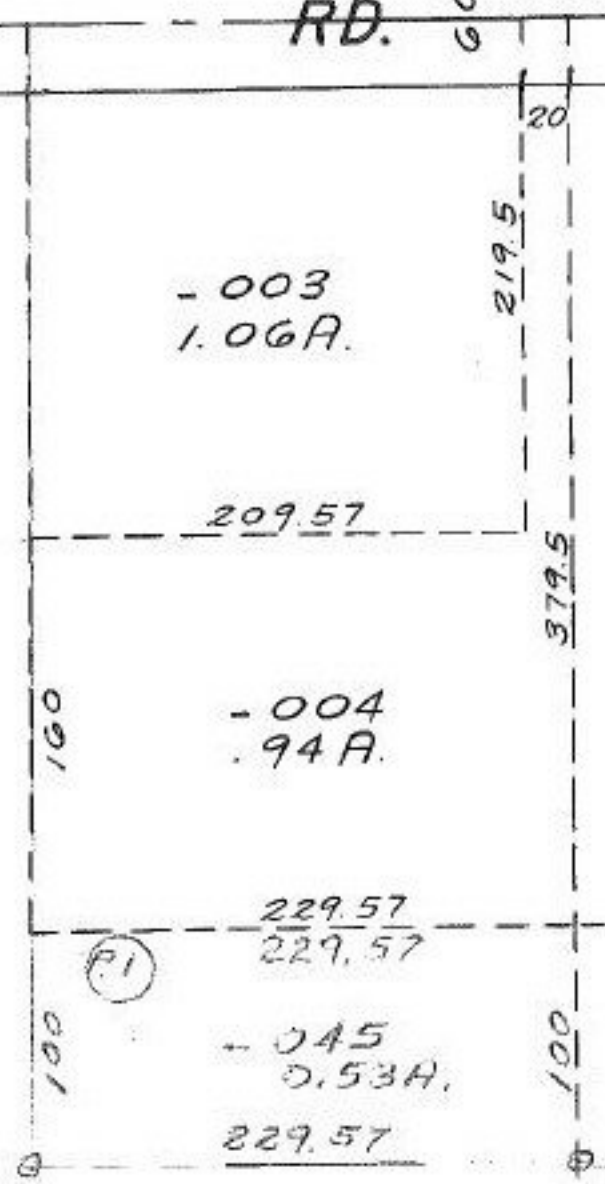

$$\begin{array}{r} 70.59 \\ 52 \\ \hline 71.12 \\ 70 \\ \hline 71.82 \end{array}$$

CHANGE TO PAGE BREAK LINE

~~Pt. - 044~~ ~~Pt. - 047~~
~~Pt. 71.82 A.~~ ~~Pt. 70.59 A.~~

#14367

APPROVED LORAIN CO. MAP DEPT.	
DATE 9-2-81	
PAGE 12-22-021A	
BY Carolyn F	
VOID AFTER	

JAN 8 1982

