


MIKE

Acreages Correction Only

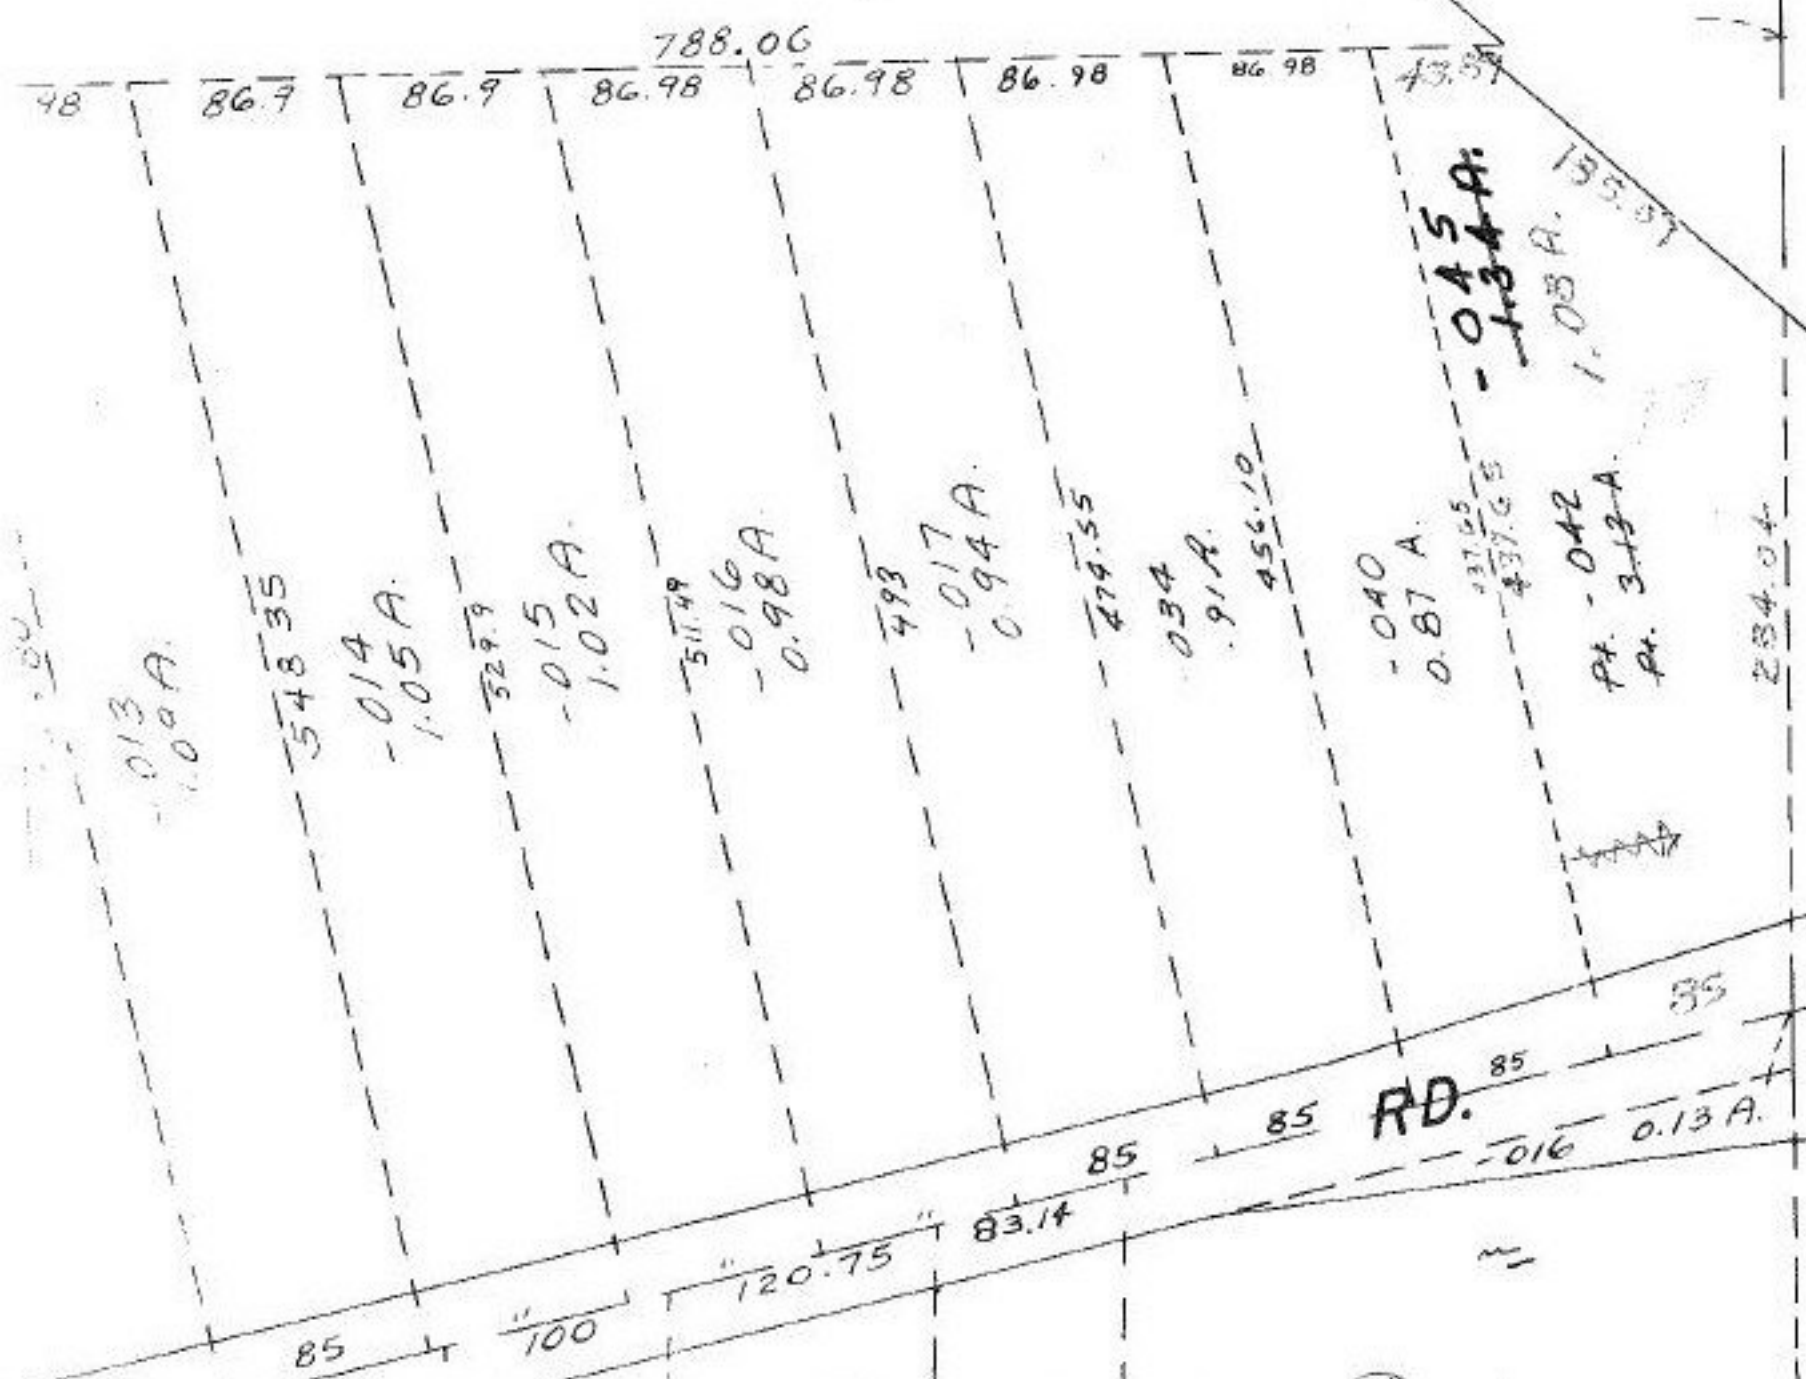

SEE 7-00-002-B

Acreages Correction Per Deed: #14377
And Calc. of Map Dept.

JAN 8 1982

APPROVED LORAIN CO. MAP DEPT.	
DATE	9-9-81
PAGE	7-00-002-A
BY	Casalini J
VOID AFTER	14377