


" COMBINATION ONLY "

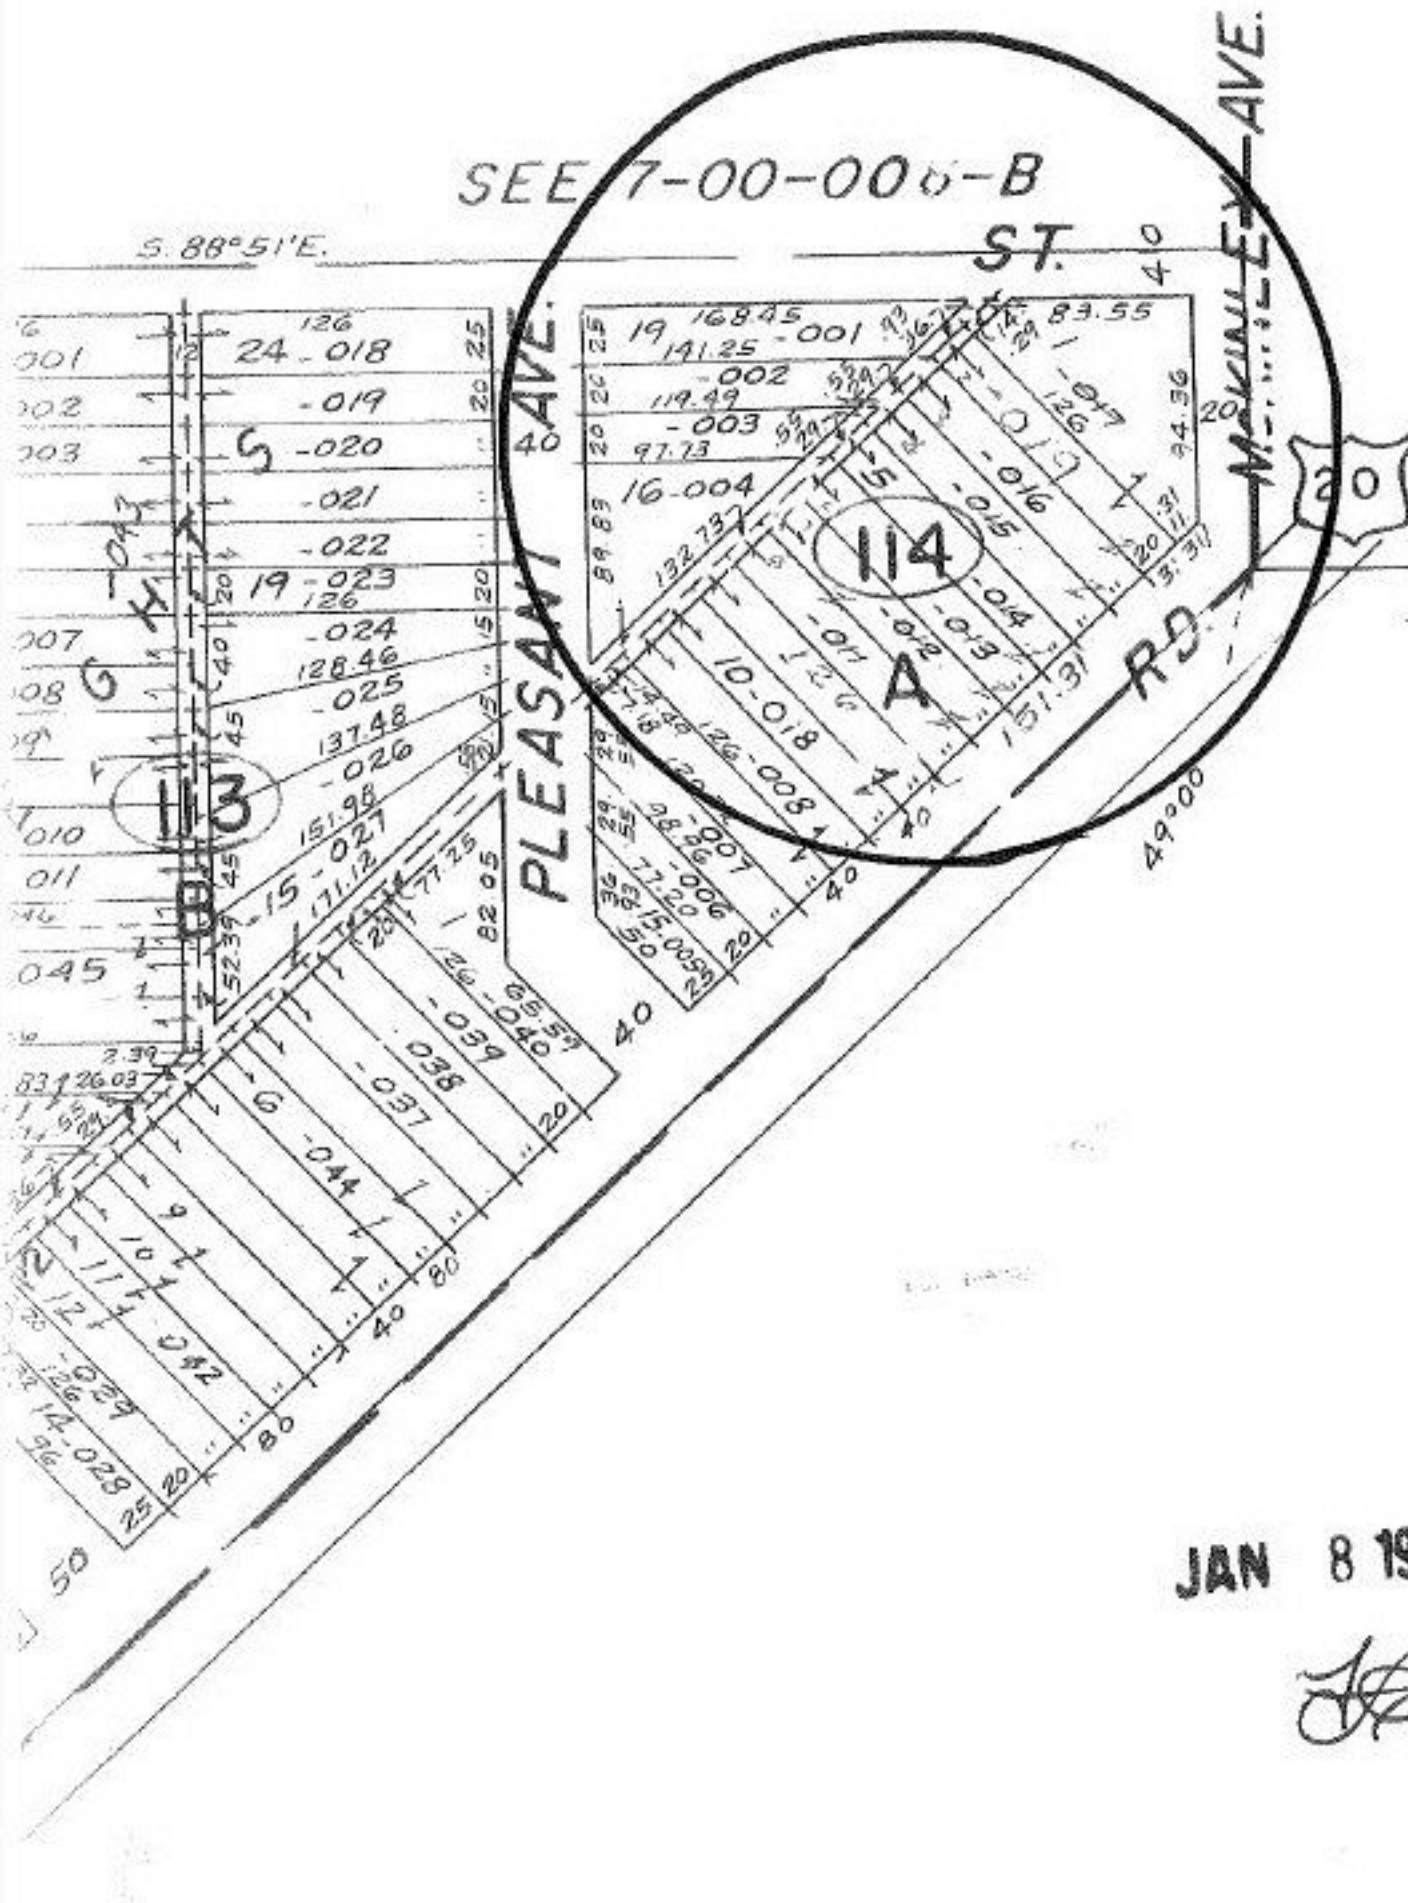

14404

JAN 8 1962

JS

APPROVED LORAIN CO. MAP DEPT.	
DATE 9-28-81	
PAGE 7-00-008-D	
BY Carolyn S.	
VOID AFTER	