


SEE 1-00-043

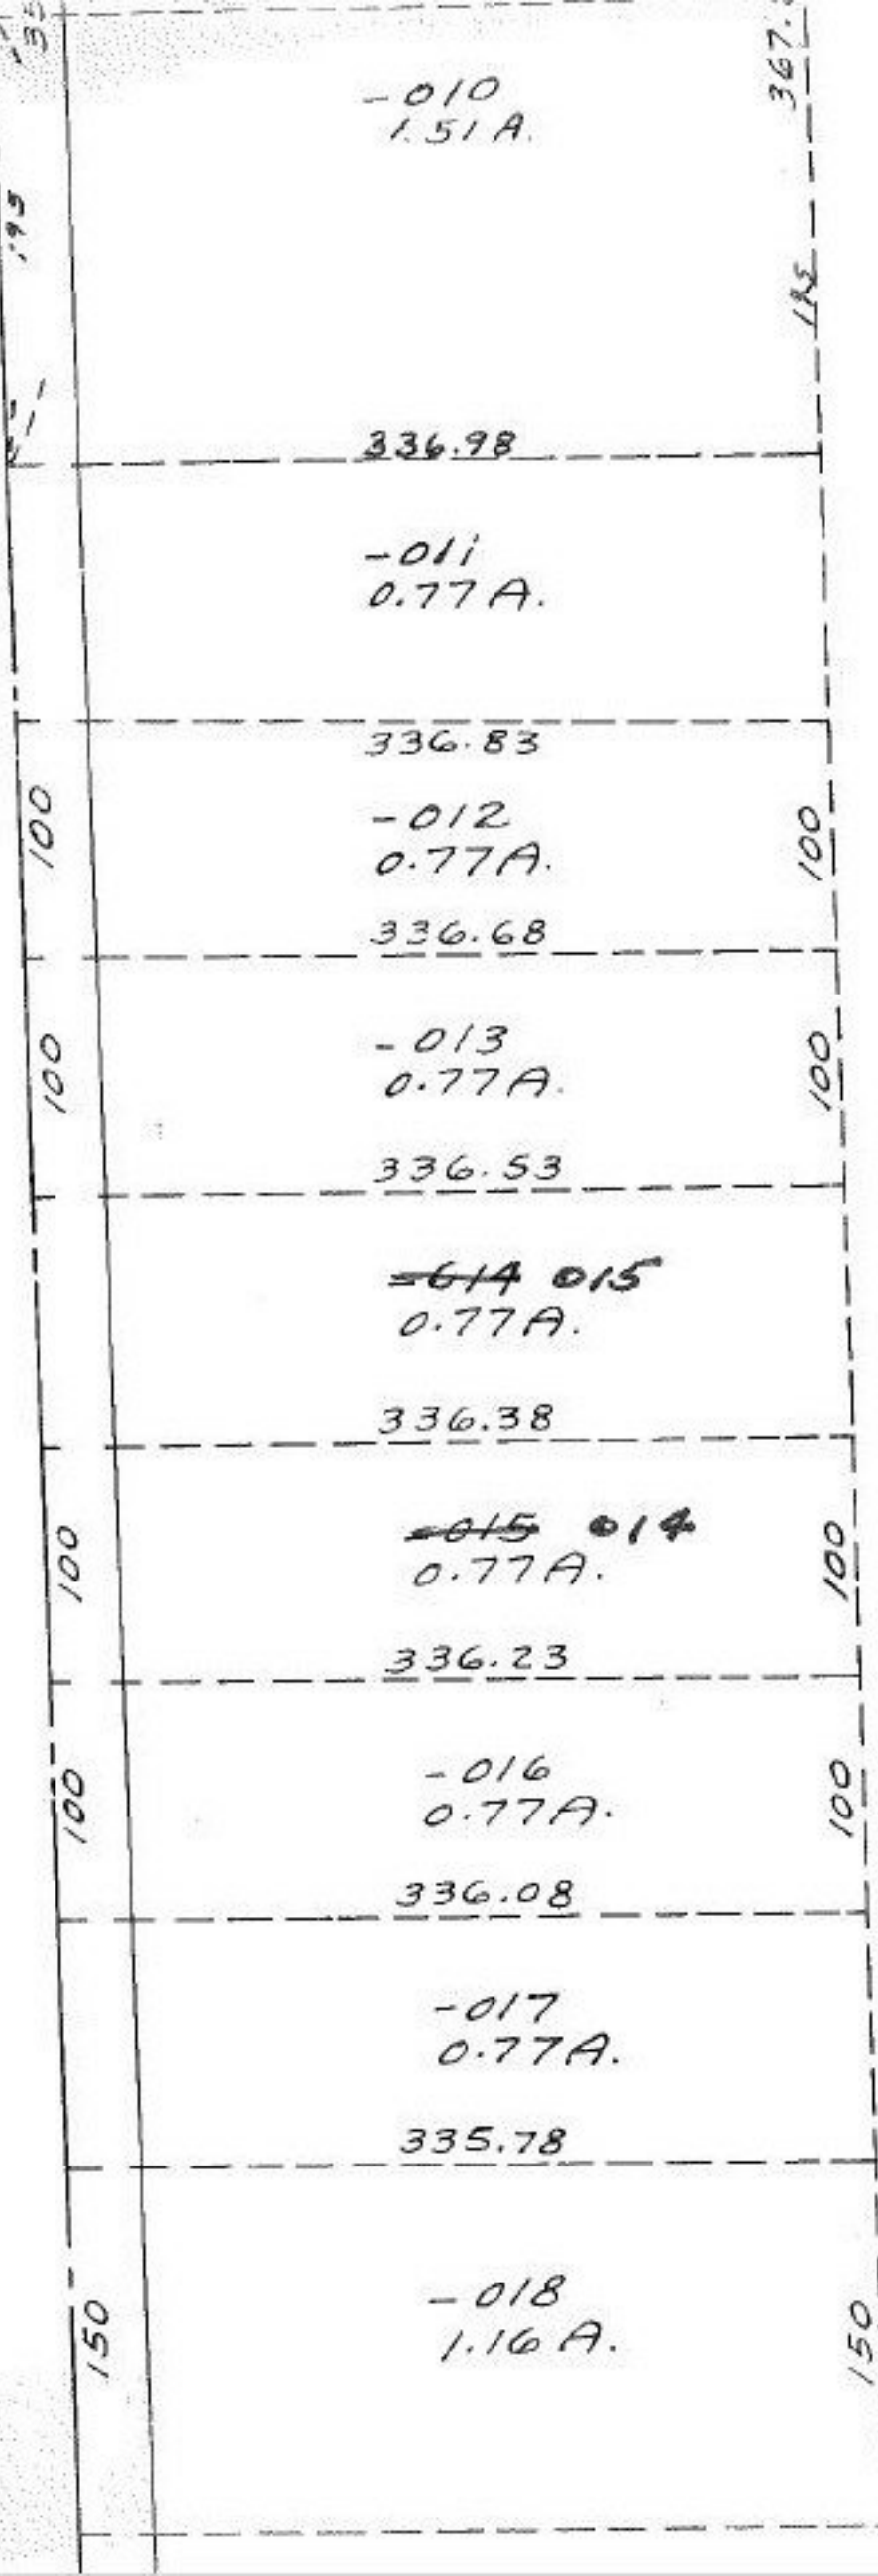

-056
24.20 A.

MAP CORR ONLY

#14406

APPROVED	
LORAIN CO.	
MAP DEPT.	
DATE 9-29-81	
PAGE 1-00-042A	
BY <i>[Signature]</i>	
VOID	
AFTER	

1.5.82