


1320

1105.25

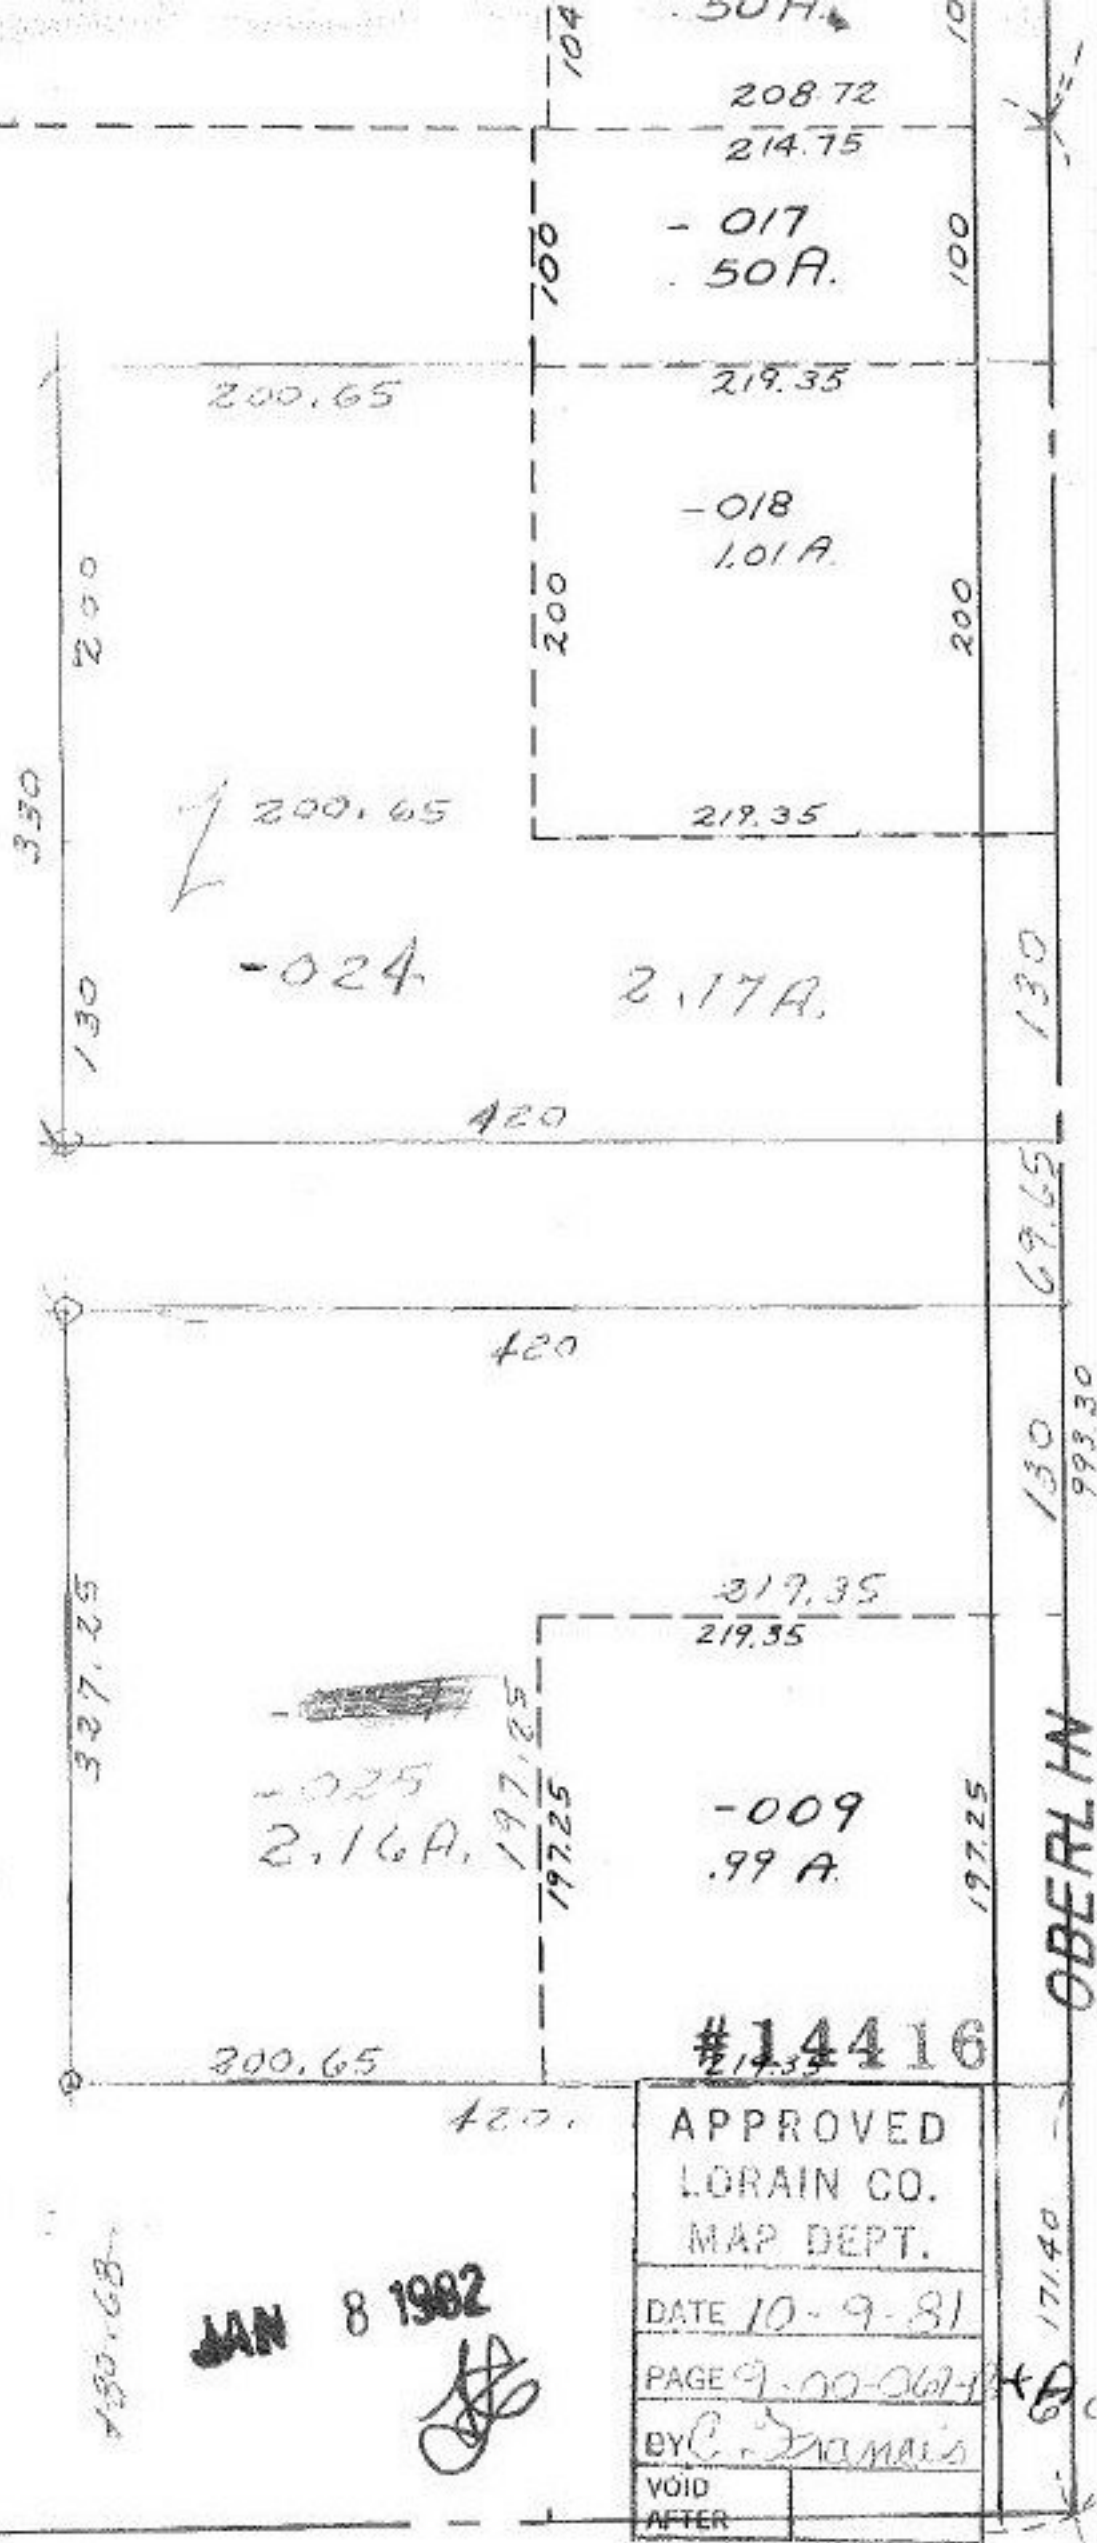

Pt. -021
 F' 65.72A. -026
 60.79A

65.12
 2.17

 62.95
 2.16

 60.79

APPROVED LORAIN CO. MAP DEPT.	
DATE 10-9-81	
PAGE 9-00-067-1	
BY C. J. MAHIS	
VOID AFTER	

JAN 8 1982
[Signature]

#14416

OBERLIN