


# COOPER FOSTER

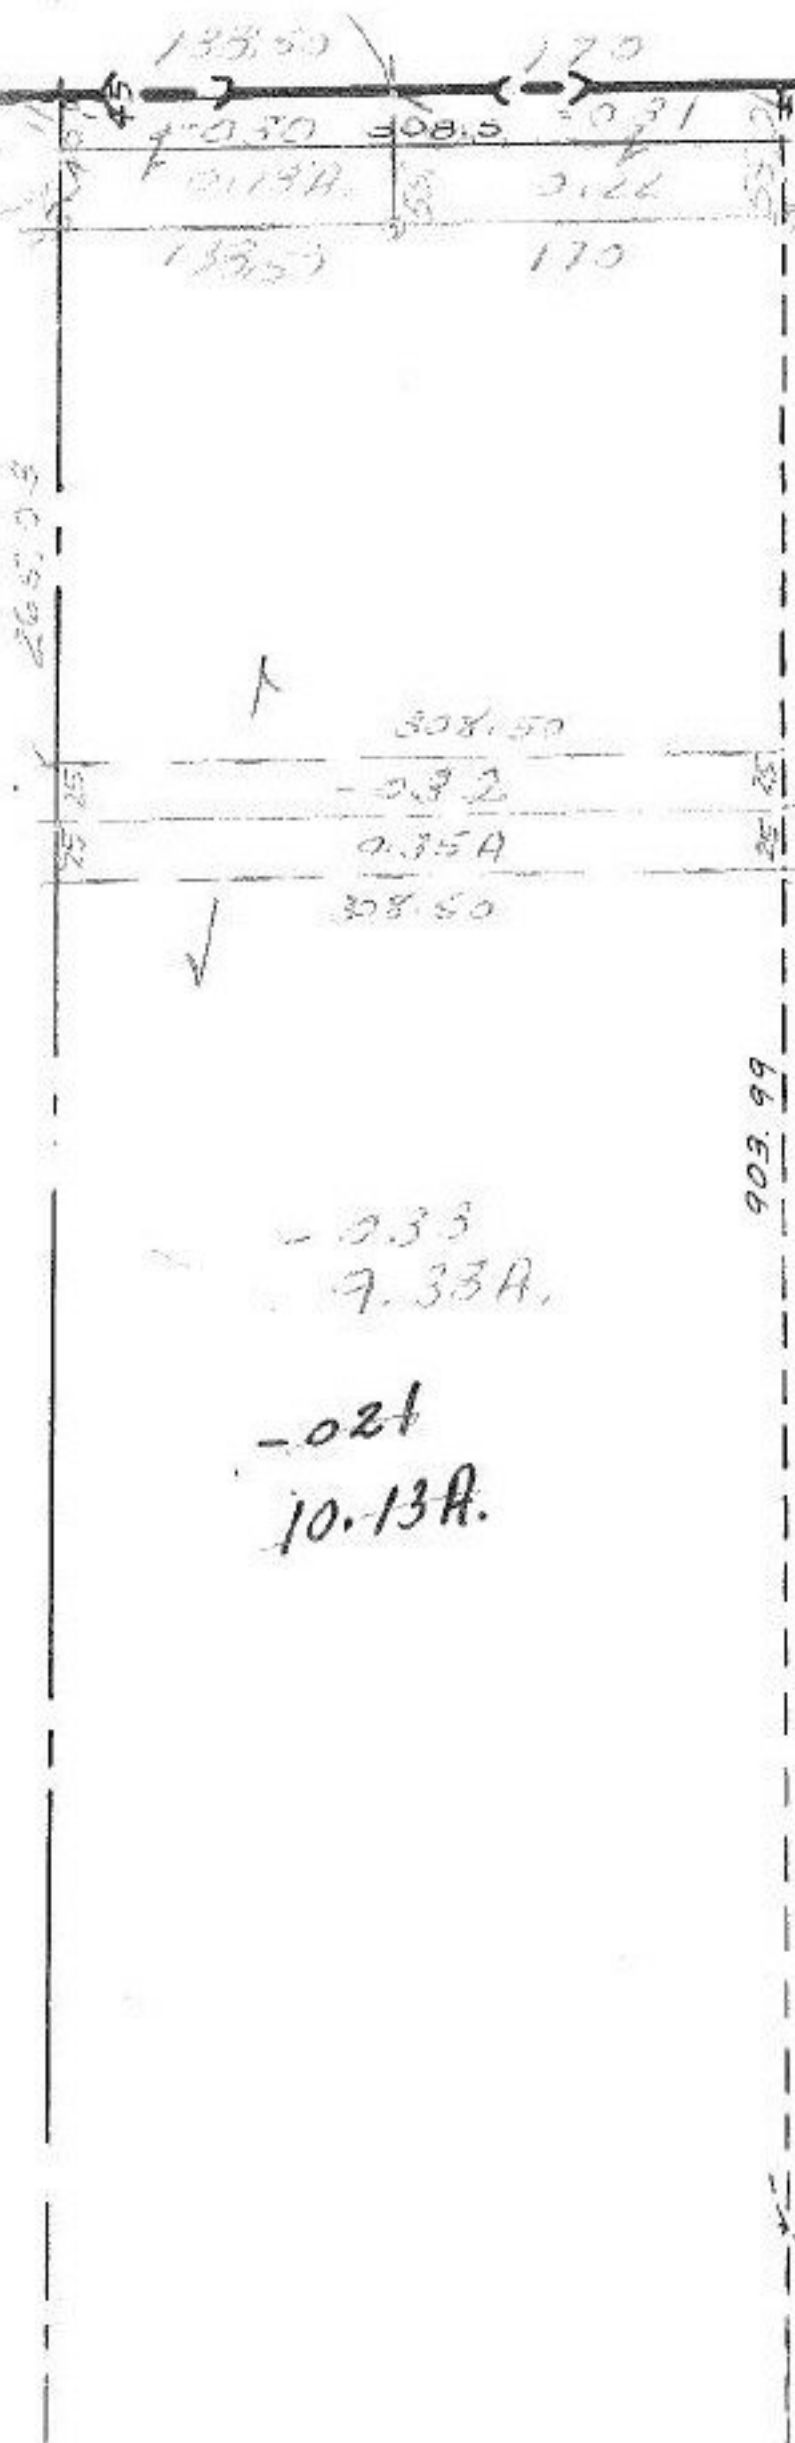

4.  
26  
30

16  
22  
25  
138  
1013

#14422

APPROVED LORAIN CO. MAP DEPT.	
DATE 11-9-81	
PAGE 5-23-360 A	
BY G. Thorne	
VOID AFTER	

T.M.  
1-7-82