

11-A


A. of P# 11-00-090-000-001

KRECIC, Edward Jr.

JANIK, ANTHONY  
MARY

# 14433

APPROVED	
LORAIN CO.	
MAP DEPT.	
DATE	11-2-81
DATE	11-11-81
BY	<i>[Signature]</i>
VOID AFTER	

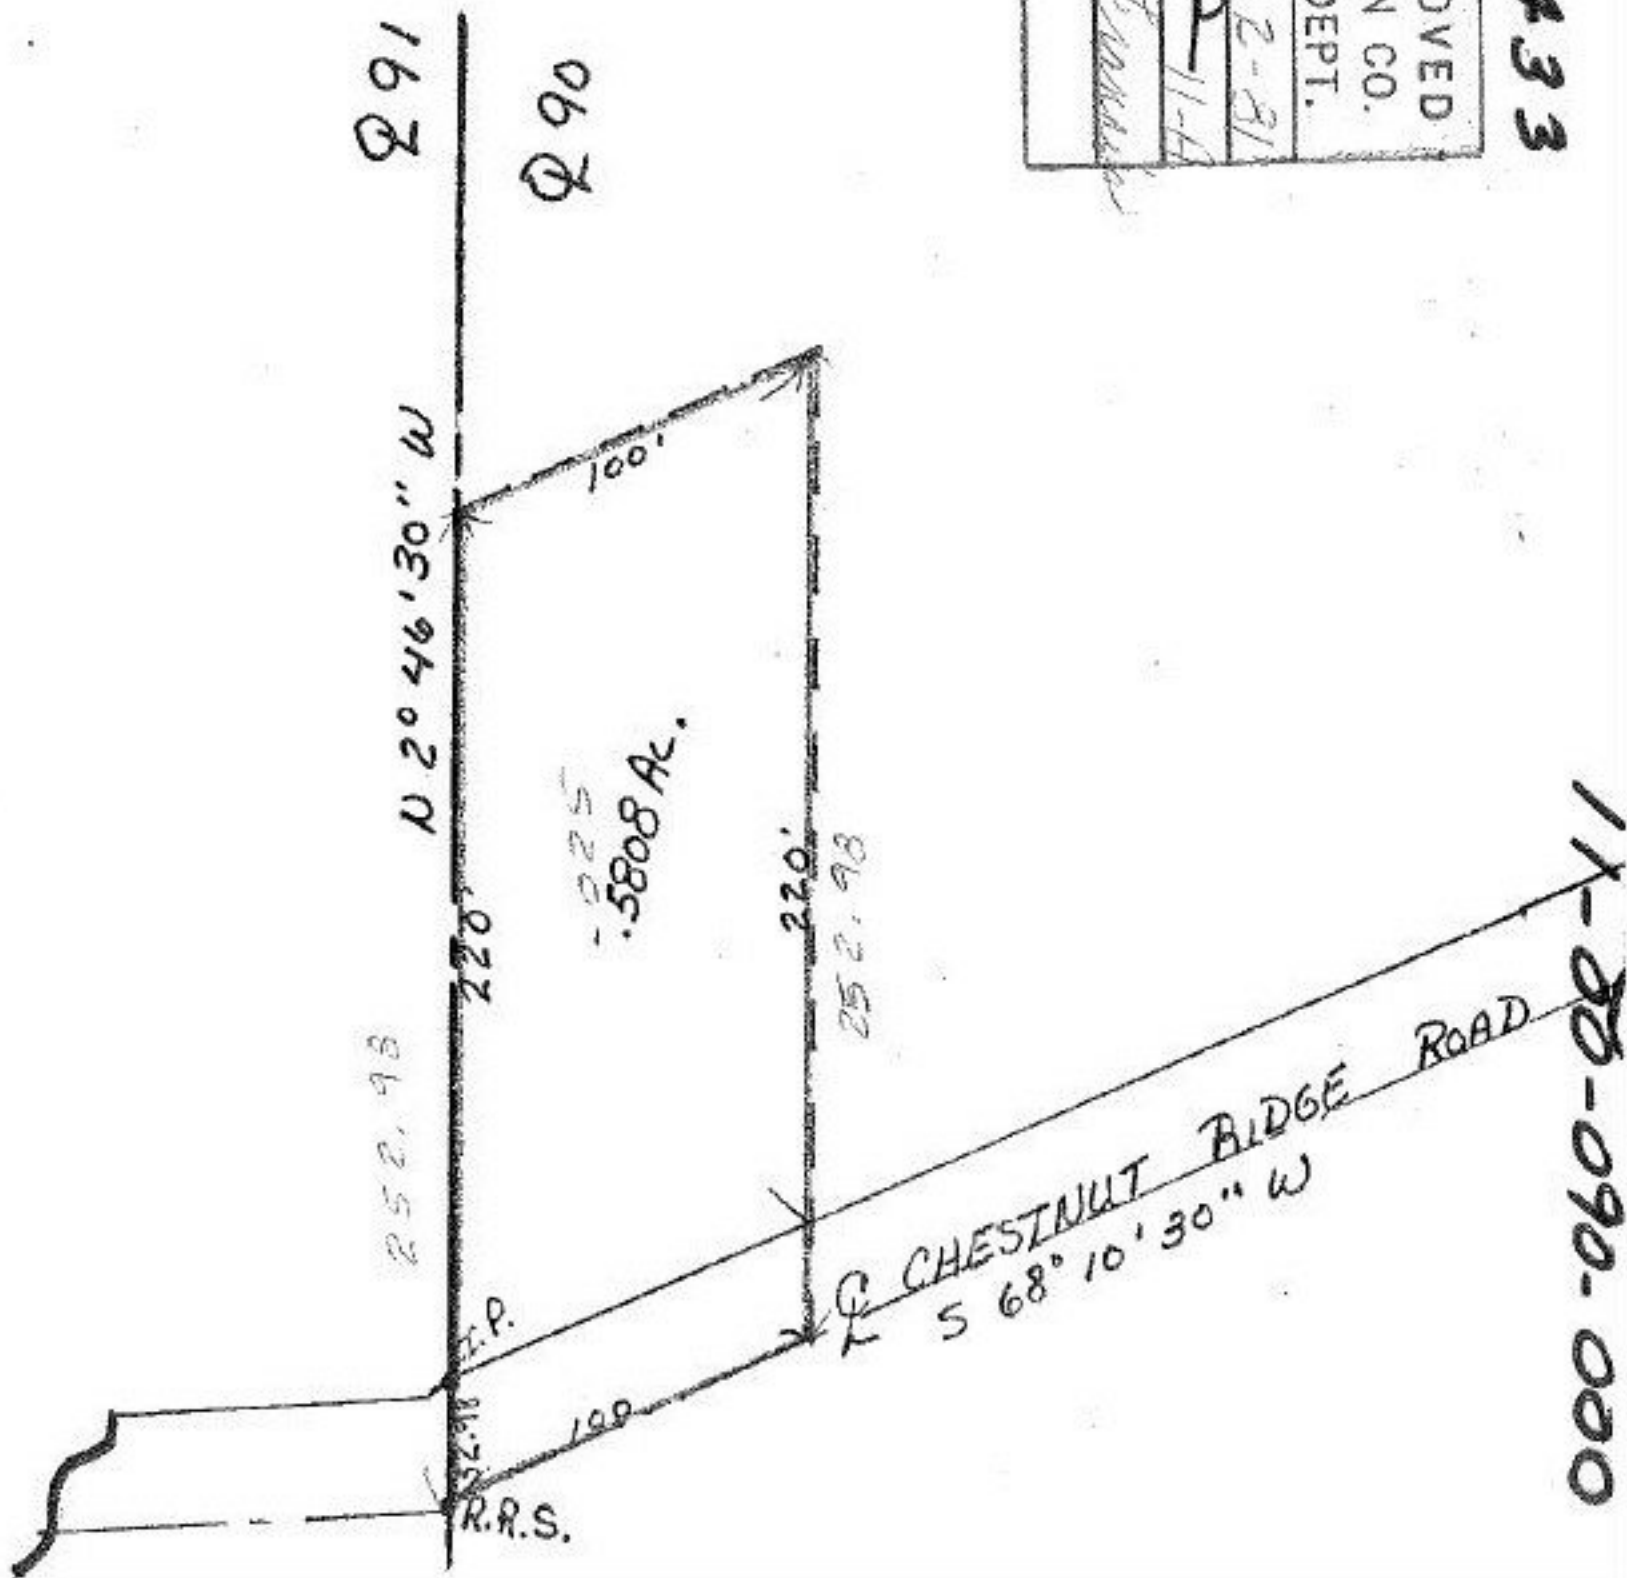

11-00-090-000