

VERMILION

SEE 1-00-017-A

#14440

APPROVED LORAIN CO. MAP DEPT.
DATE 11-9-81
PAGE 1-00-017-B
BY T.M. Hain
MADE BY
CHECKED BY


-216
10.17 A
~~10.17 A~~

-165
70-72 A

T.M.
1-5-82

10.72
+ 4.54
15.26
- 0.67
14.59
- 4.92
10.17

10.72
+ 4.64
15.36
- 0.67
14.69
- 4.42
10.27

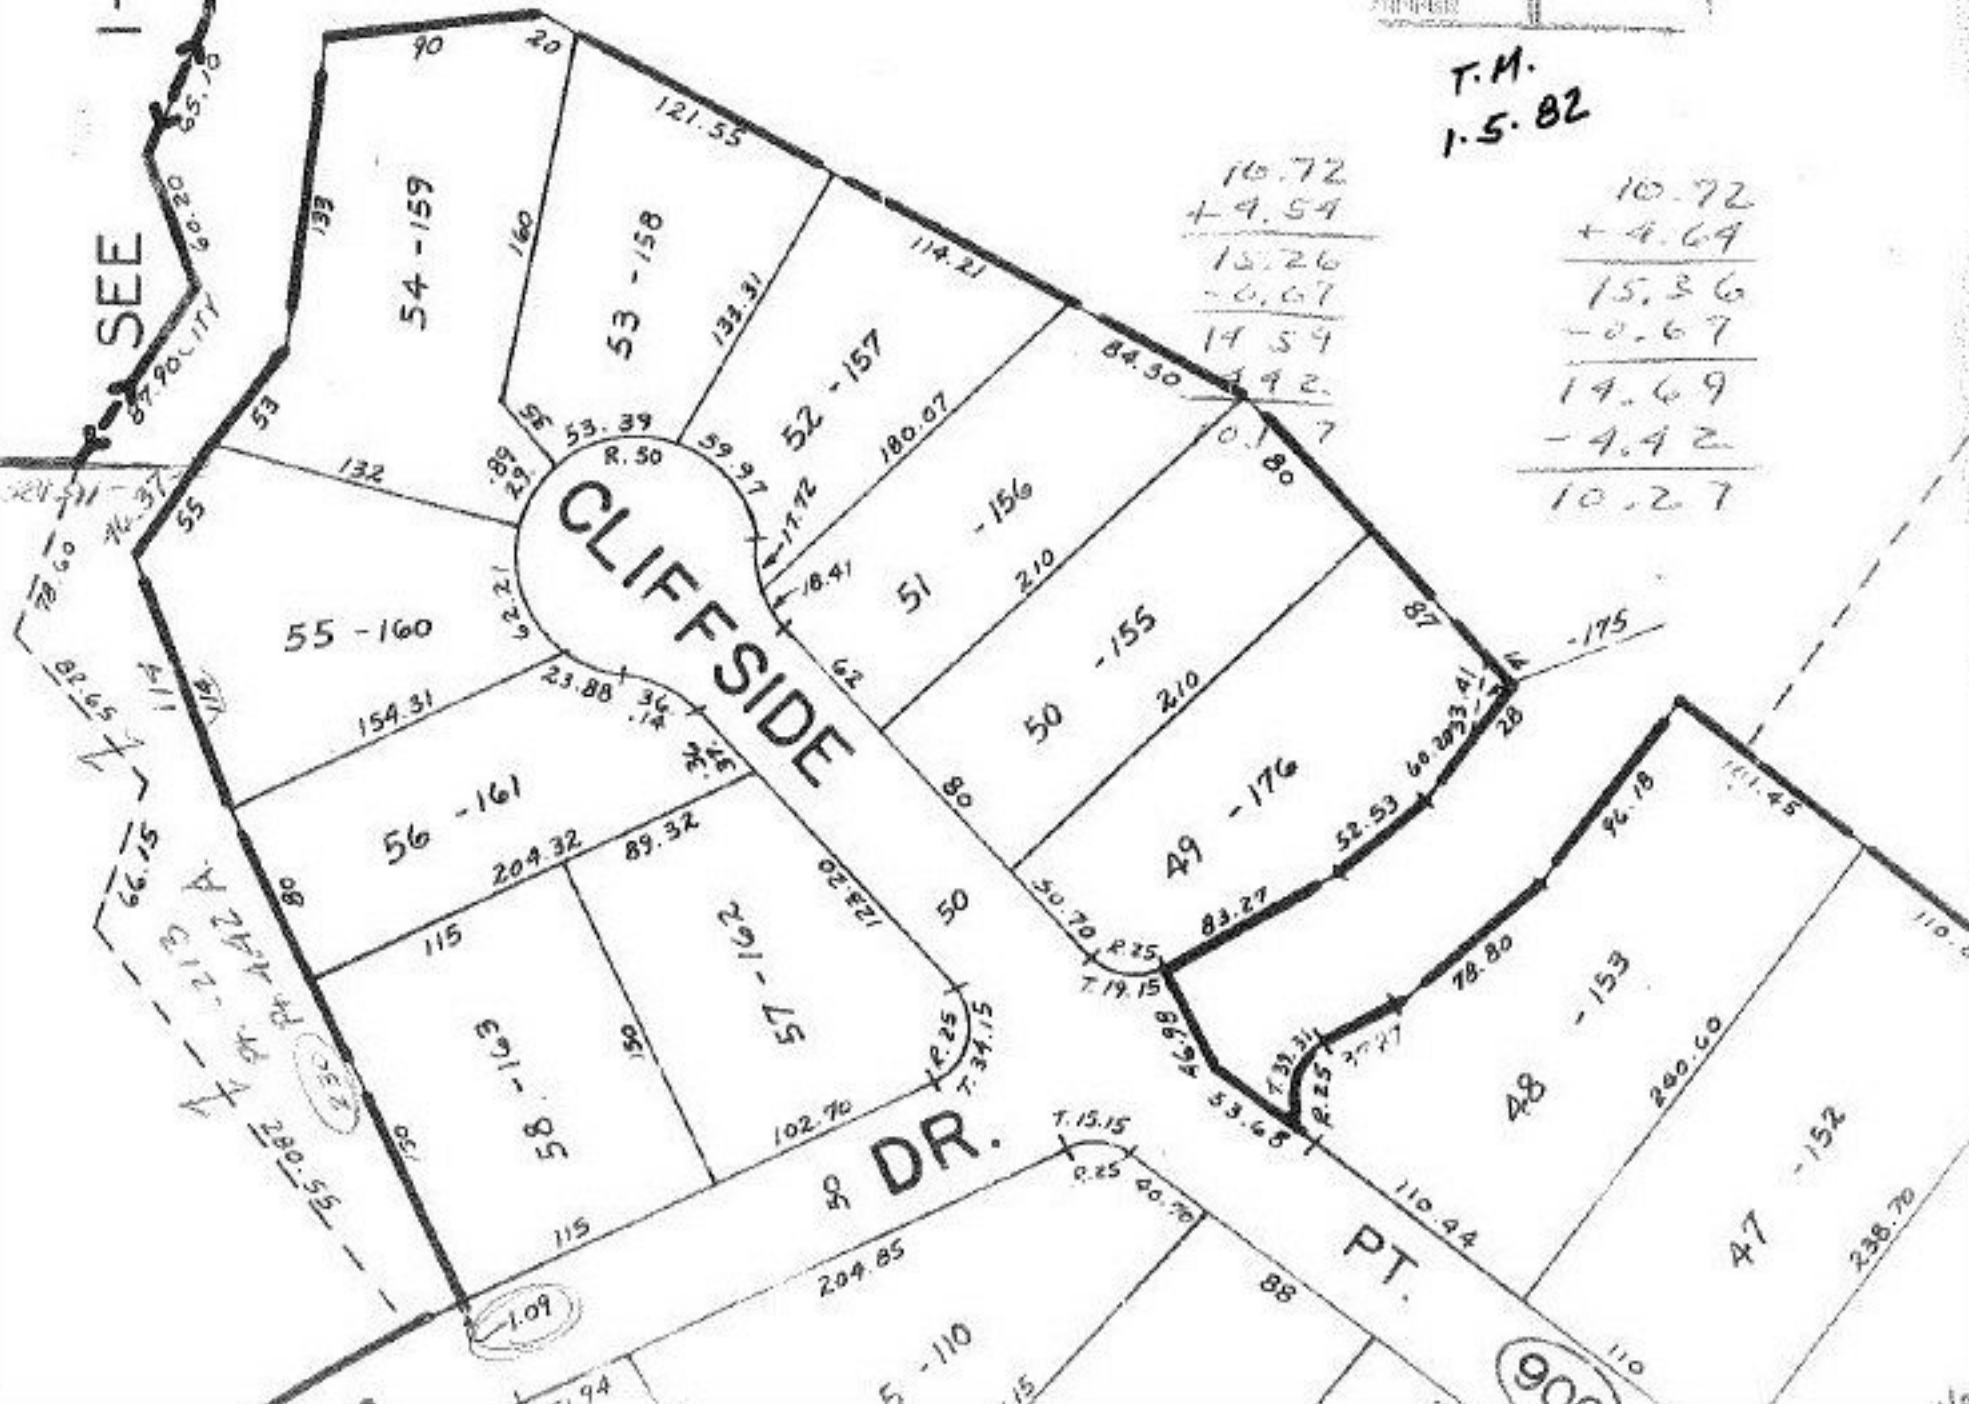

CLIFFSIDE

DR. PT.

PT.

900