

JAYCOX

APPROVED  
LORAIN CO.

MAP DEPT.

DATE 12-18-81

PAGE 4-00-023-04 D

BY [Signature]

VOID AFTER

# 14476

793A.

345

34738

-026

.80 A.

348.57

-025

.80 A.

-024

.80 A.

-023

.81 A.


350.95

-022  
.81 A.

352.14

.81 A.

-021

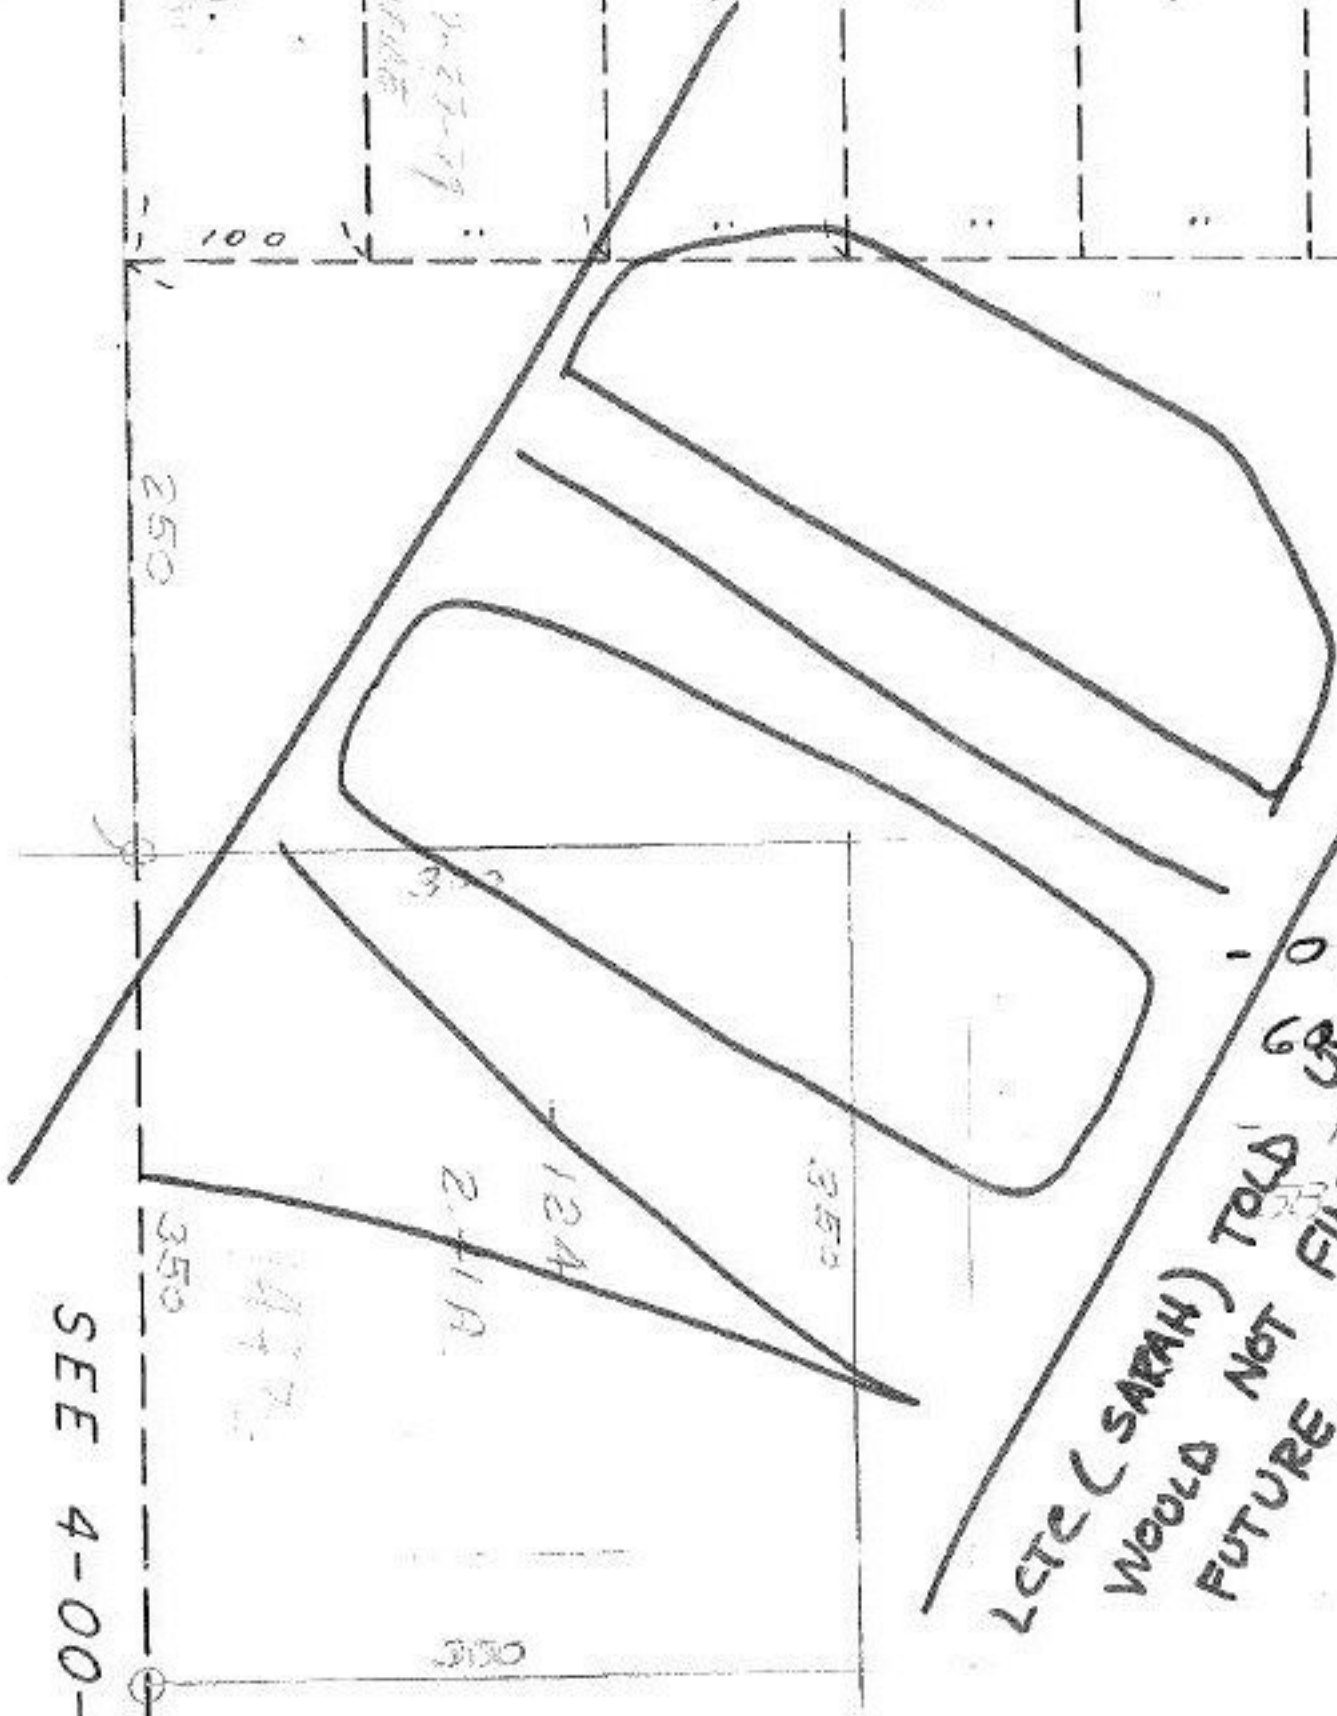

LETA (SARAH) TOLD US THIS SPLIT  
 WOULD NOT FILE IN THE NEAR  
 FUTURE. T.M. 3.19.82

SEE 4-00-023-6