


SEE 2-01-003-L

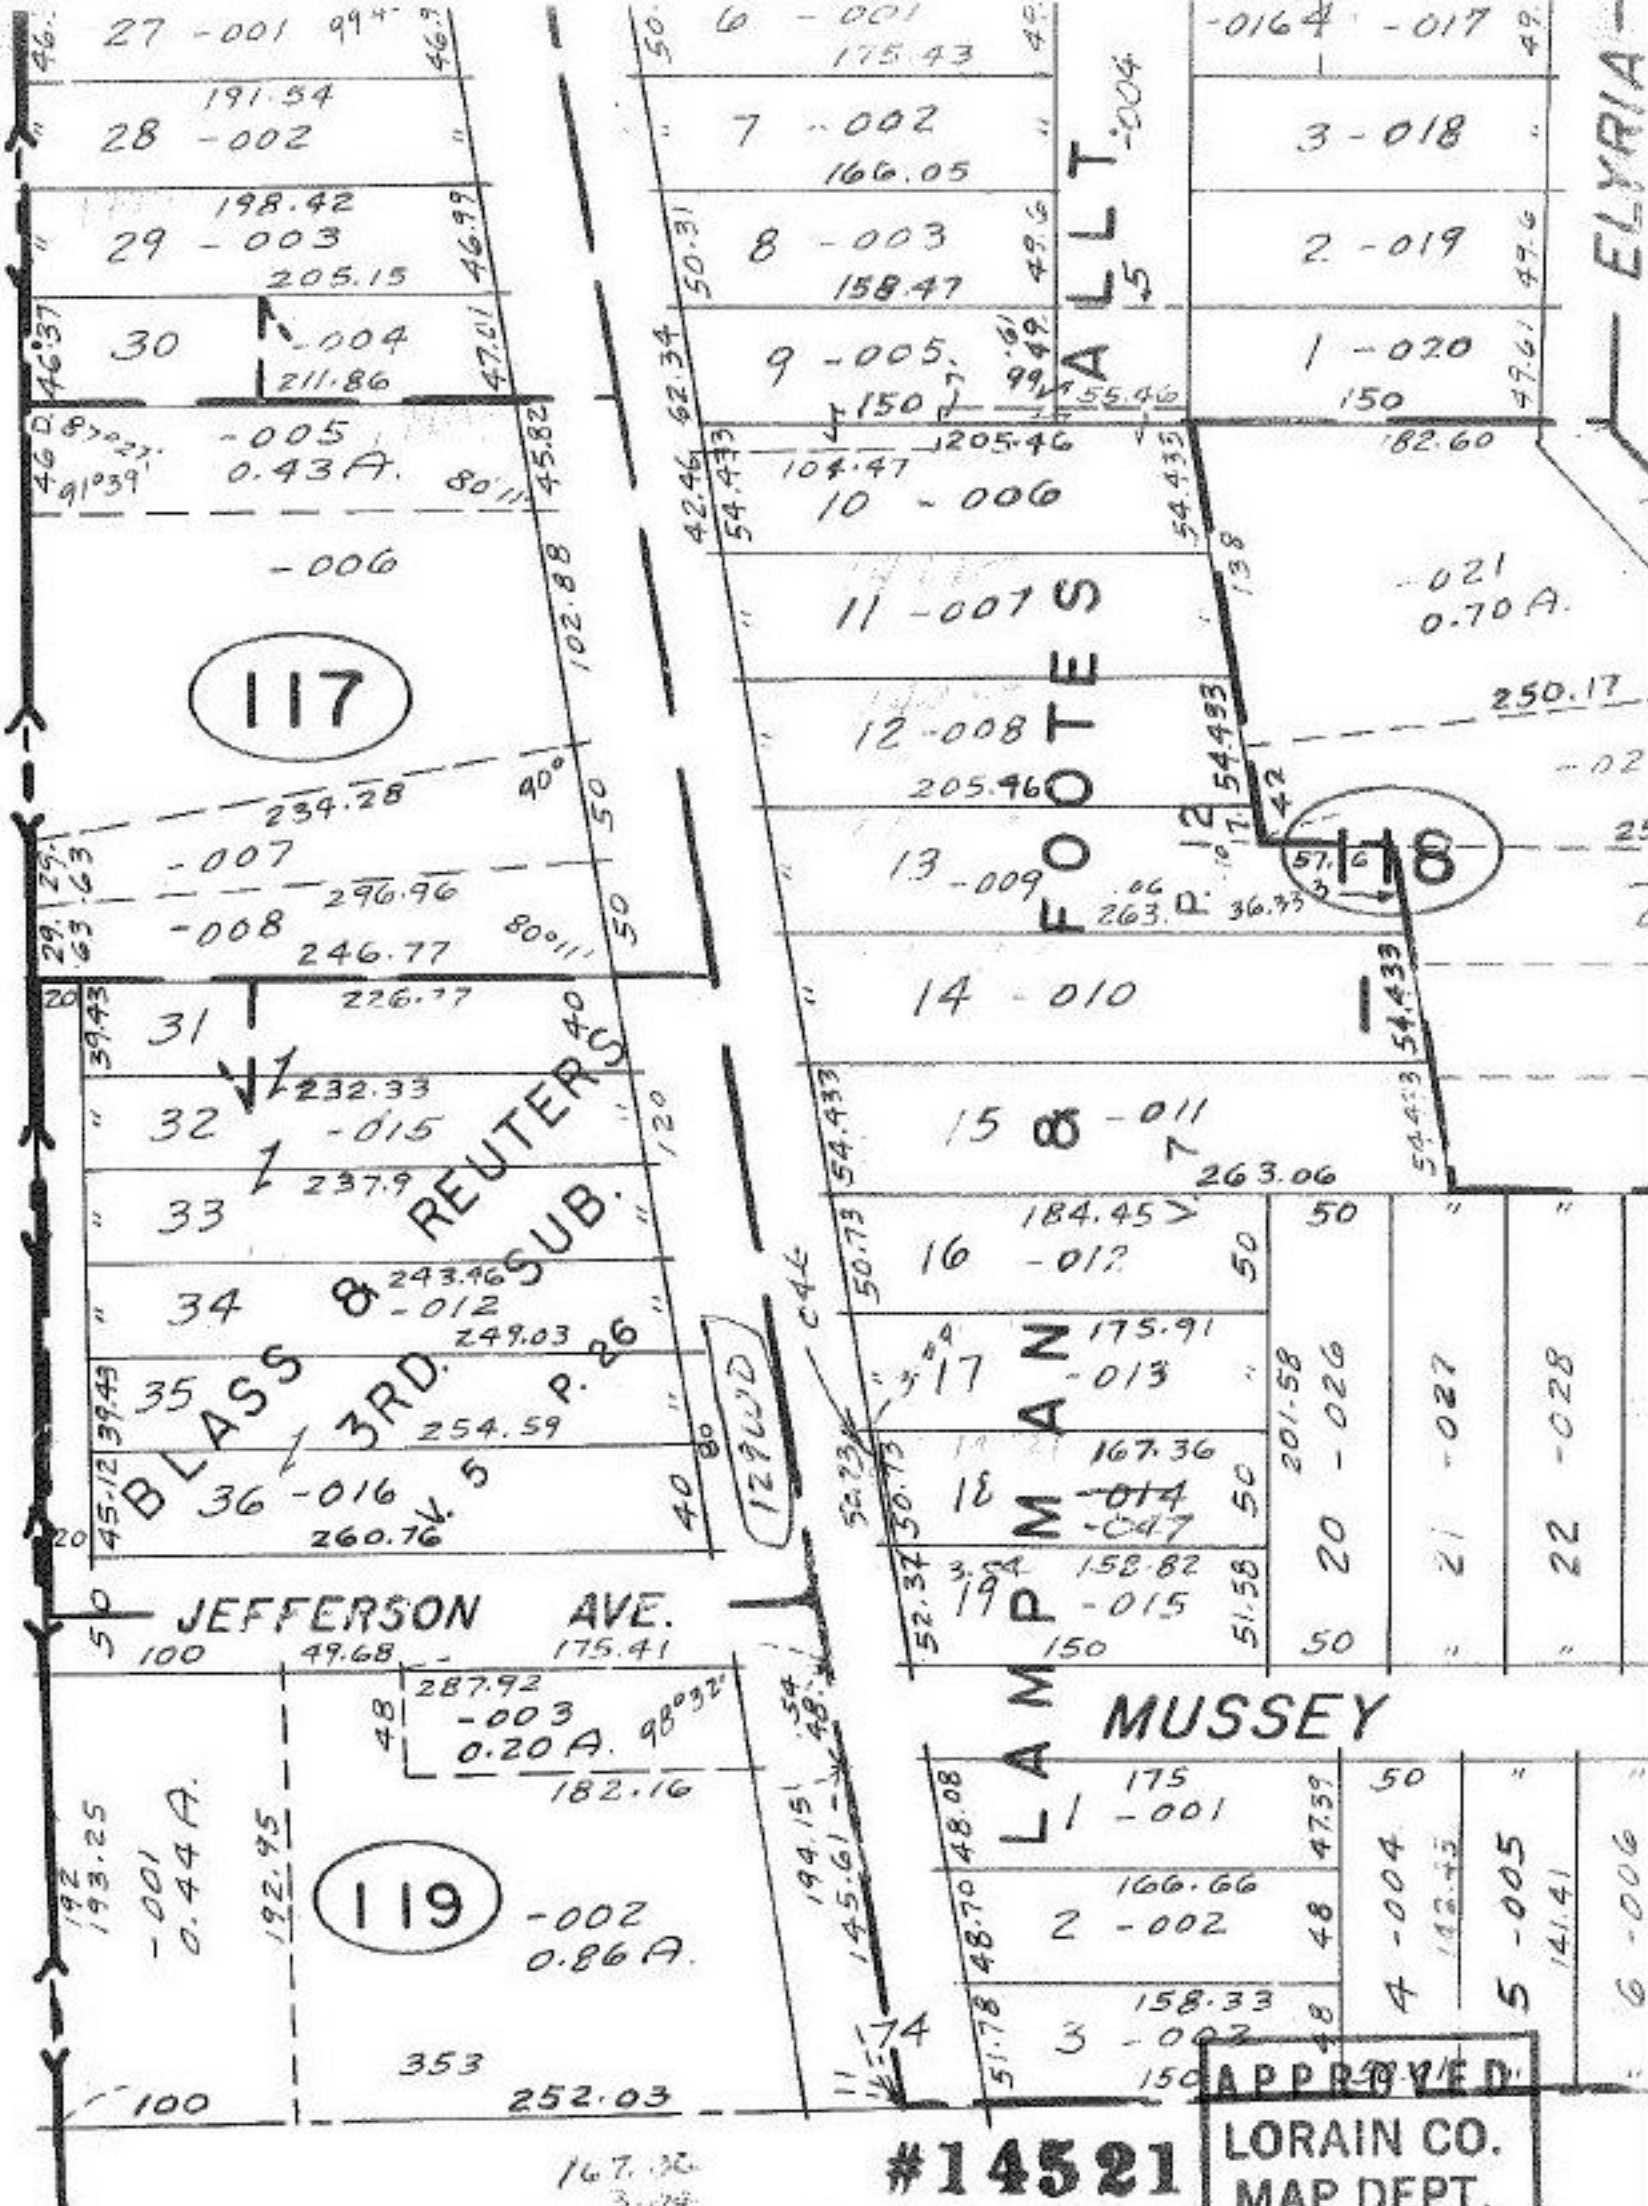

167.32
 3.04
 164.32

#14521
 5-14-82
[Signature]

APPROVED	
LORAIN CO. MAP DEPT.	
DATE 2-9-82	
PAGE 3-0-103-A	
BY <i>[Signature]</i>	
VOID	AFTER

ELYRIA