


MC 37-20 W 191.00

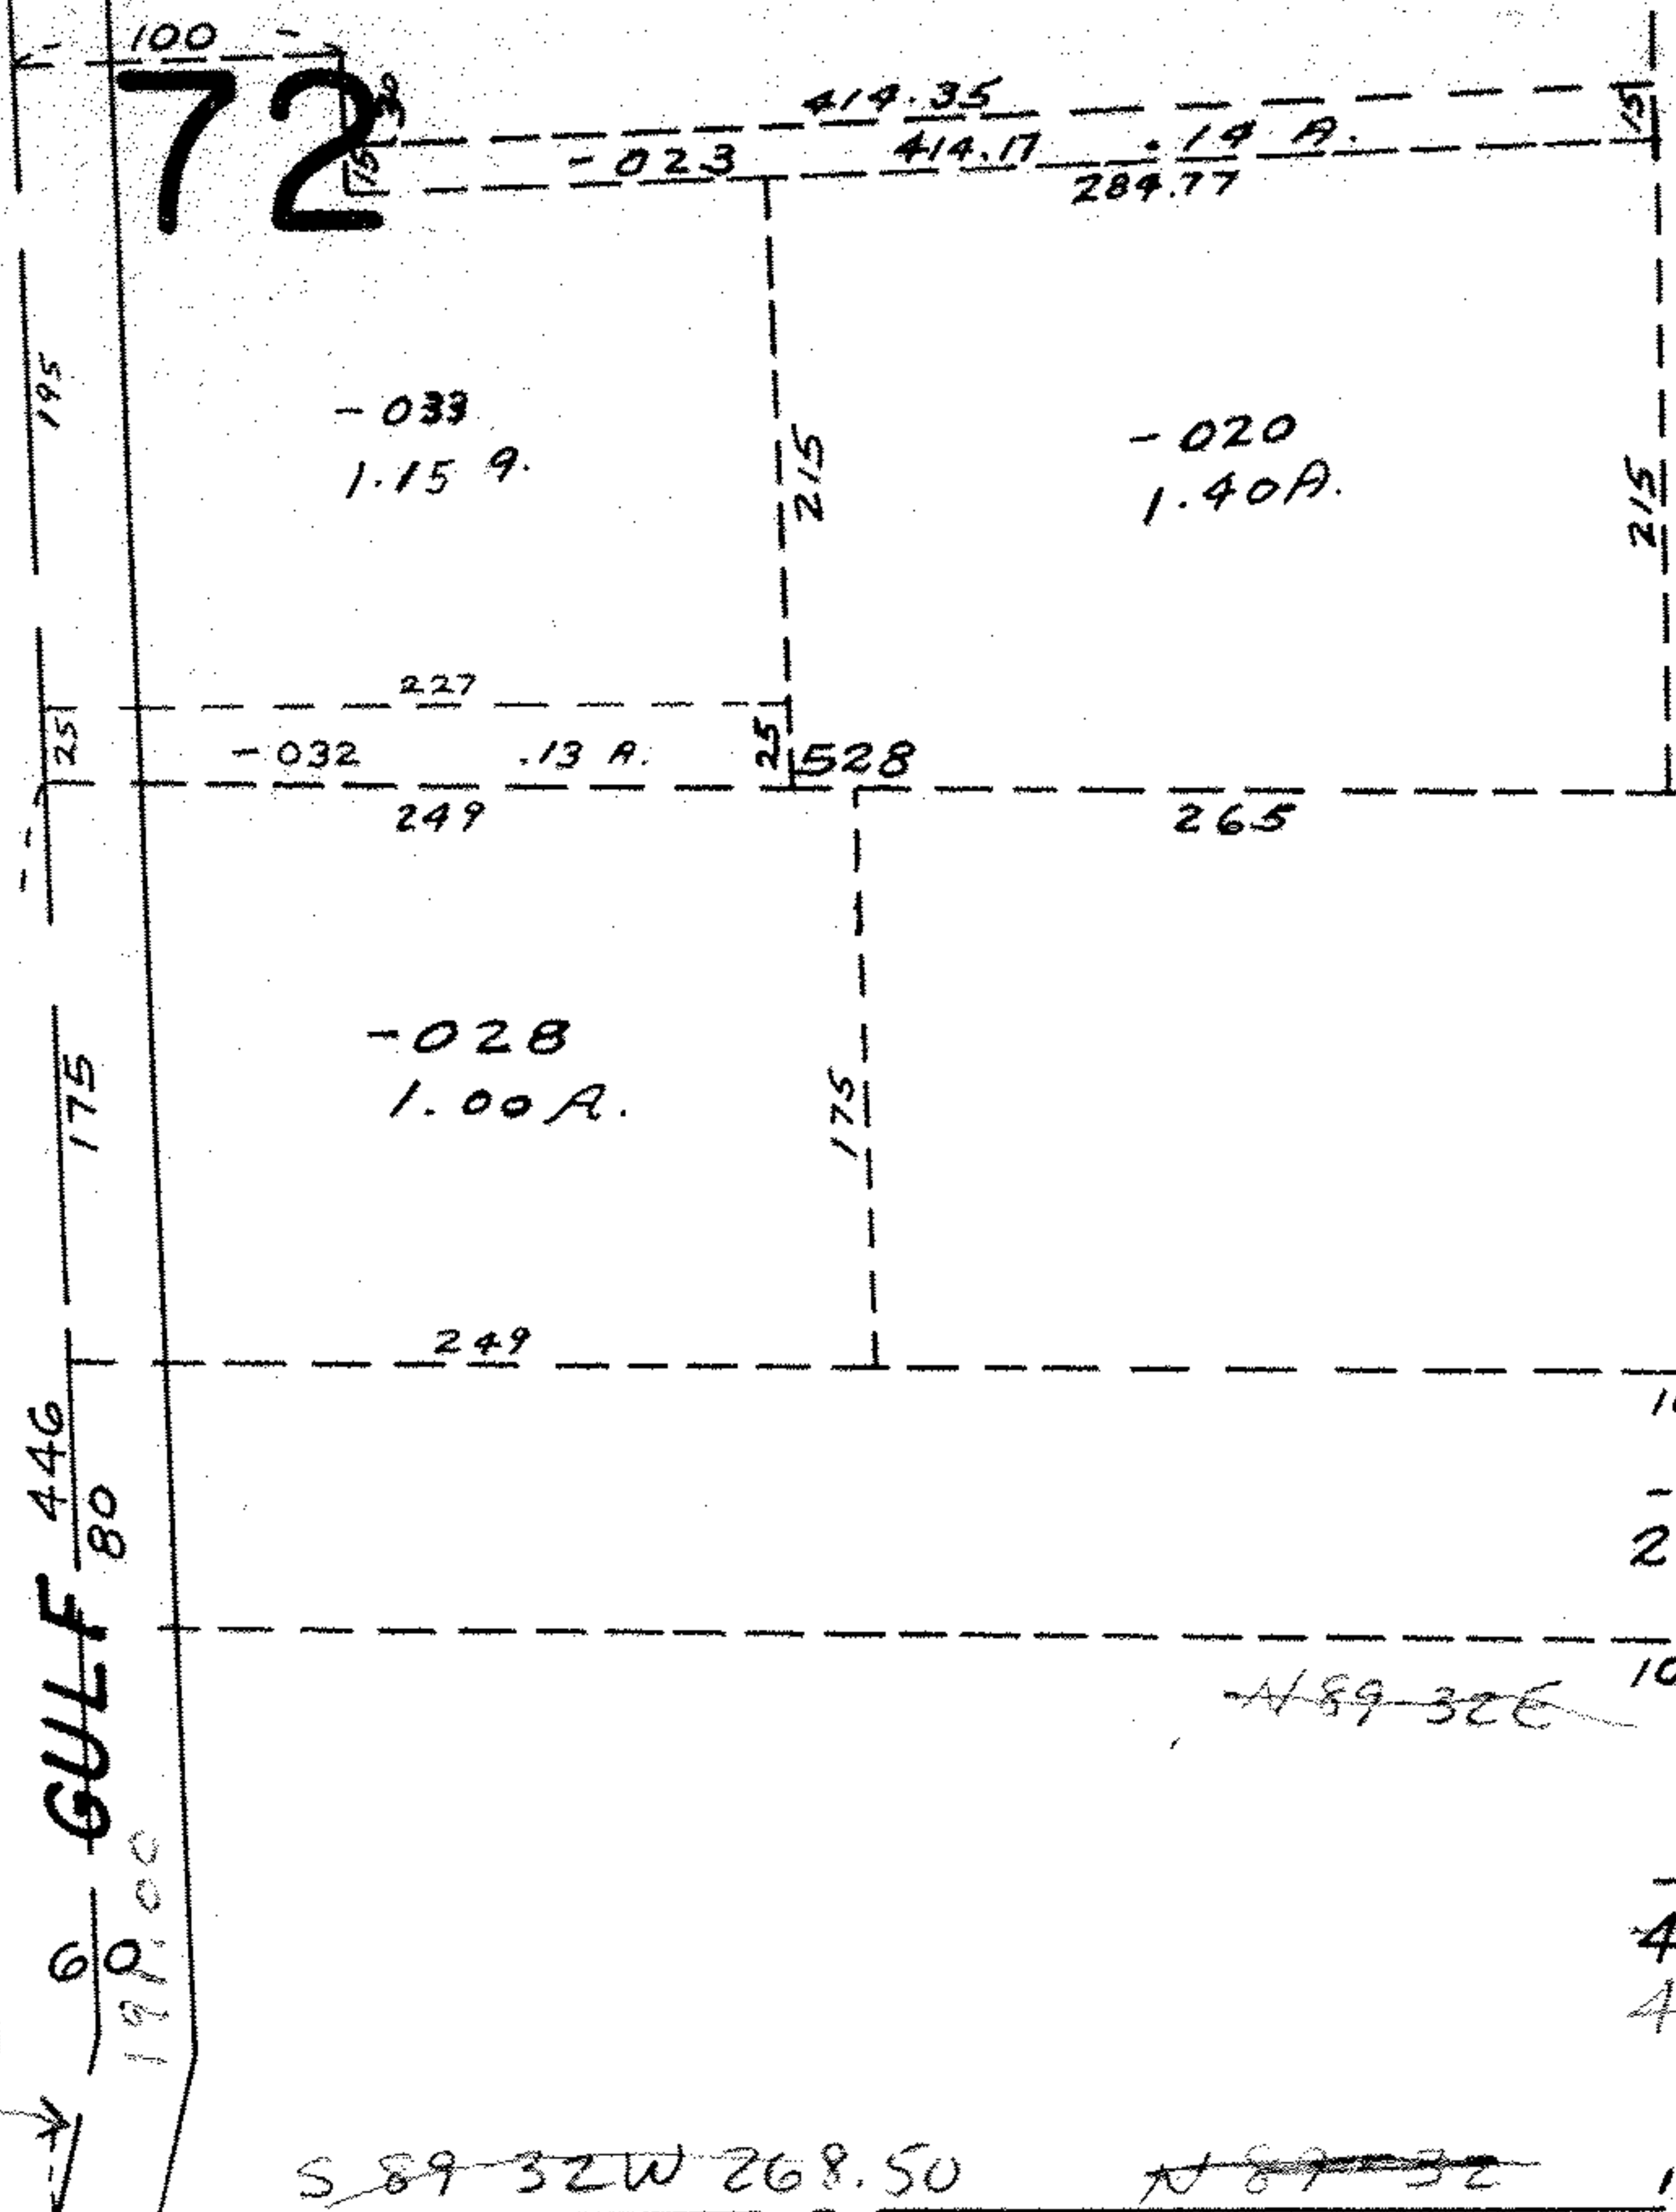

#14523

APPROVED
LORAIN CO.
MAP DEPT.
DATE 2-9-82
PAGE 3 00-071A
BY <i>[Signature]</i>
VOID AFTER

1-14-83  
*[Signature]*

3-00-073-A

3-00-071-A

191.00  
50-37-20-6

38.40