


MAP CORRECTION ONLY  
(PER SURVEY T.W. LAUNDON)

#14538  
APPROVED  
LORAIN CO.  
MAP DEPT.  
DATE 2-18-82  
PAGE 9-00-099-B  
BY T. McMan  
VOID  
AFTER

JAN 14 1983

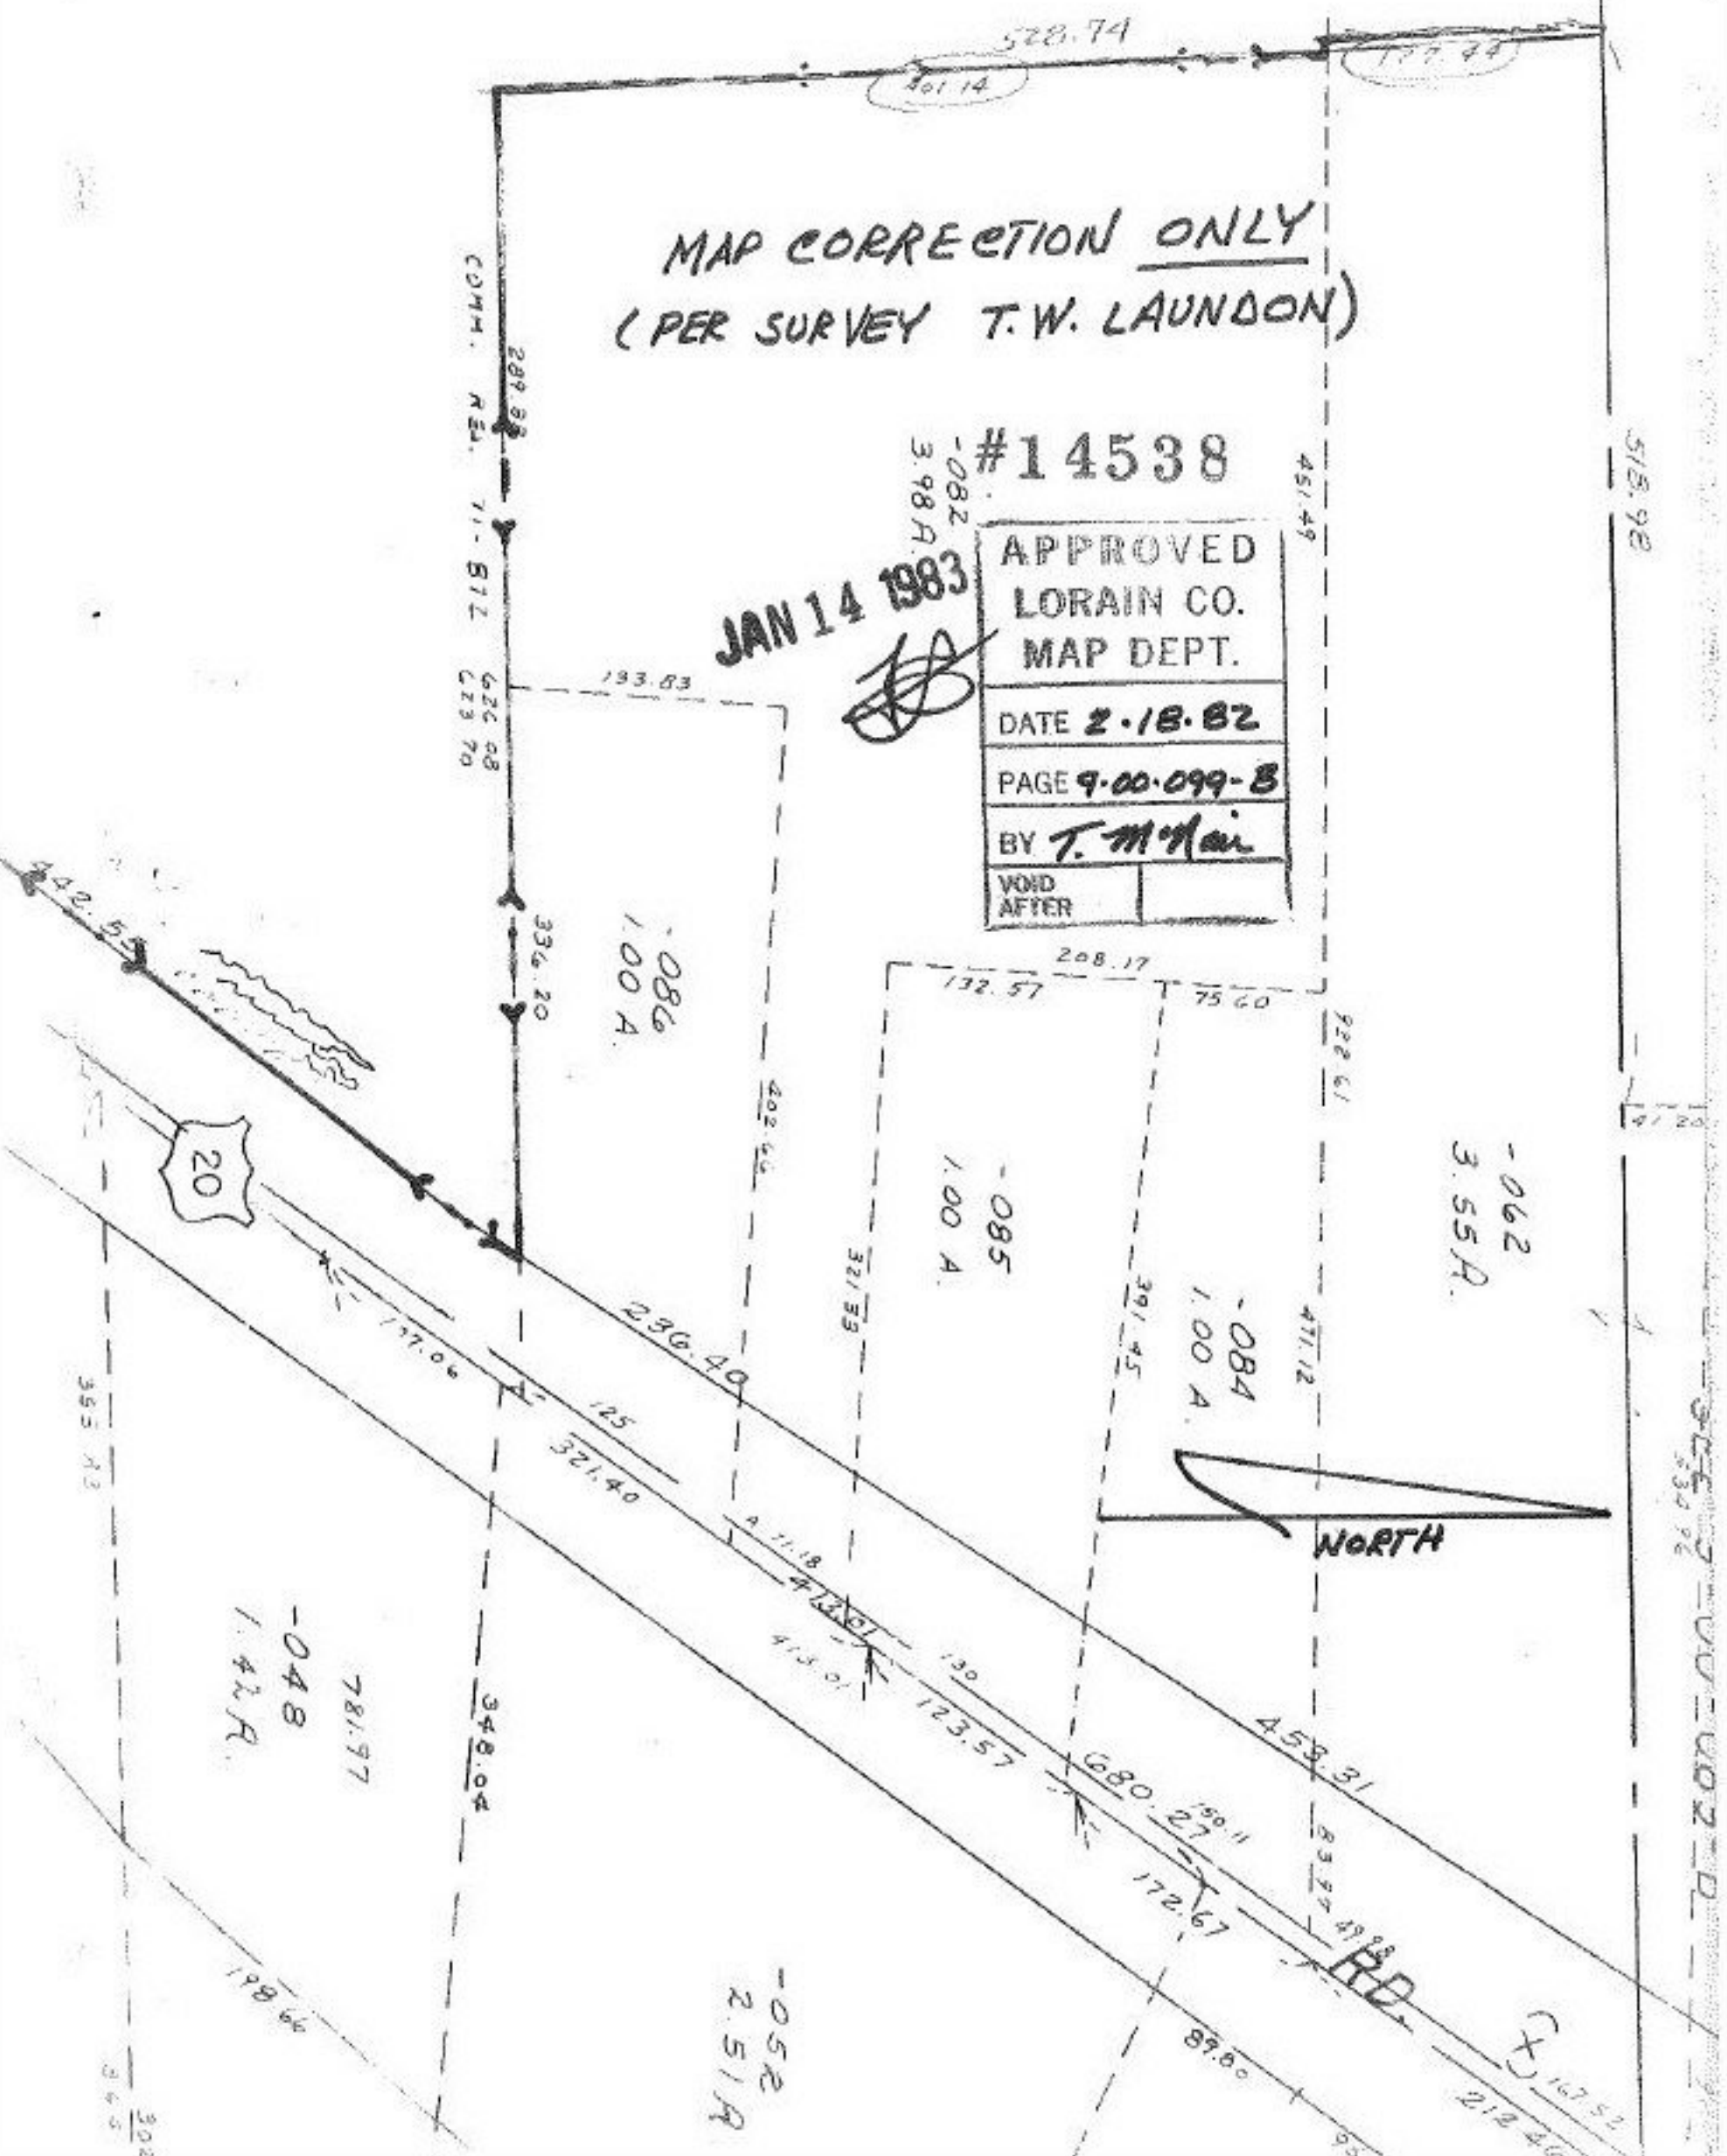

SEE 9-00-099-B