


SEE 2-01-003-L

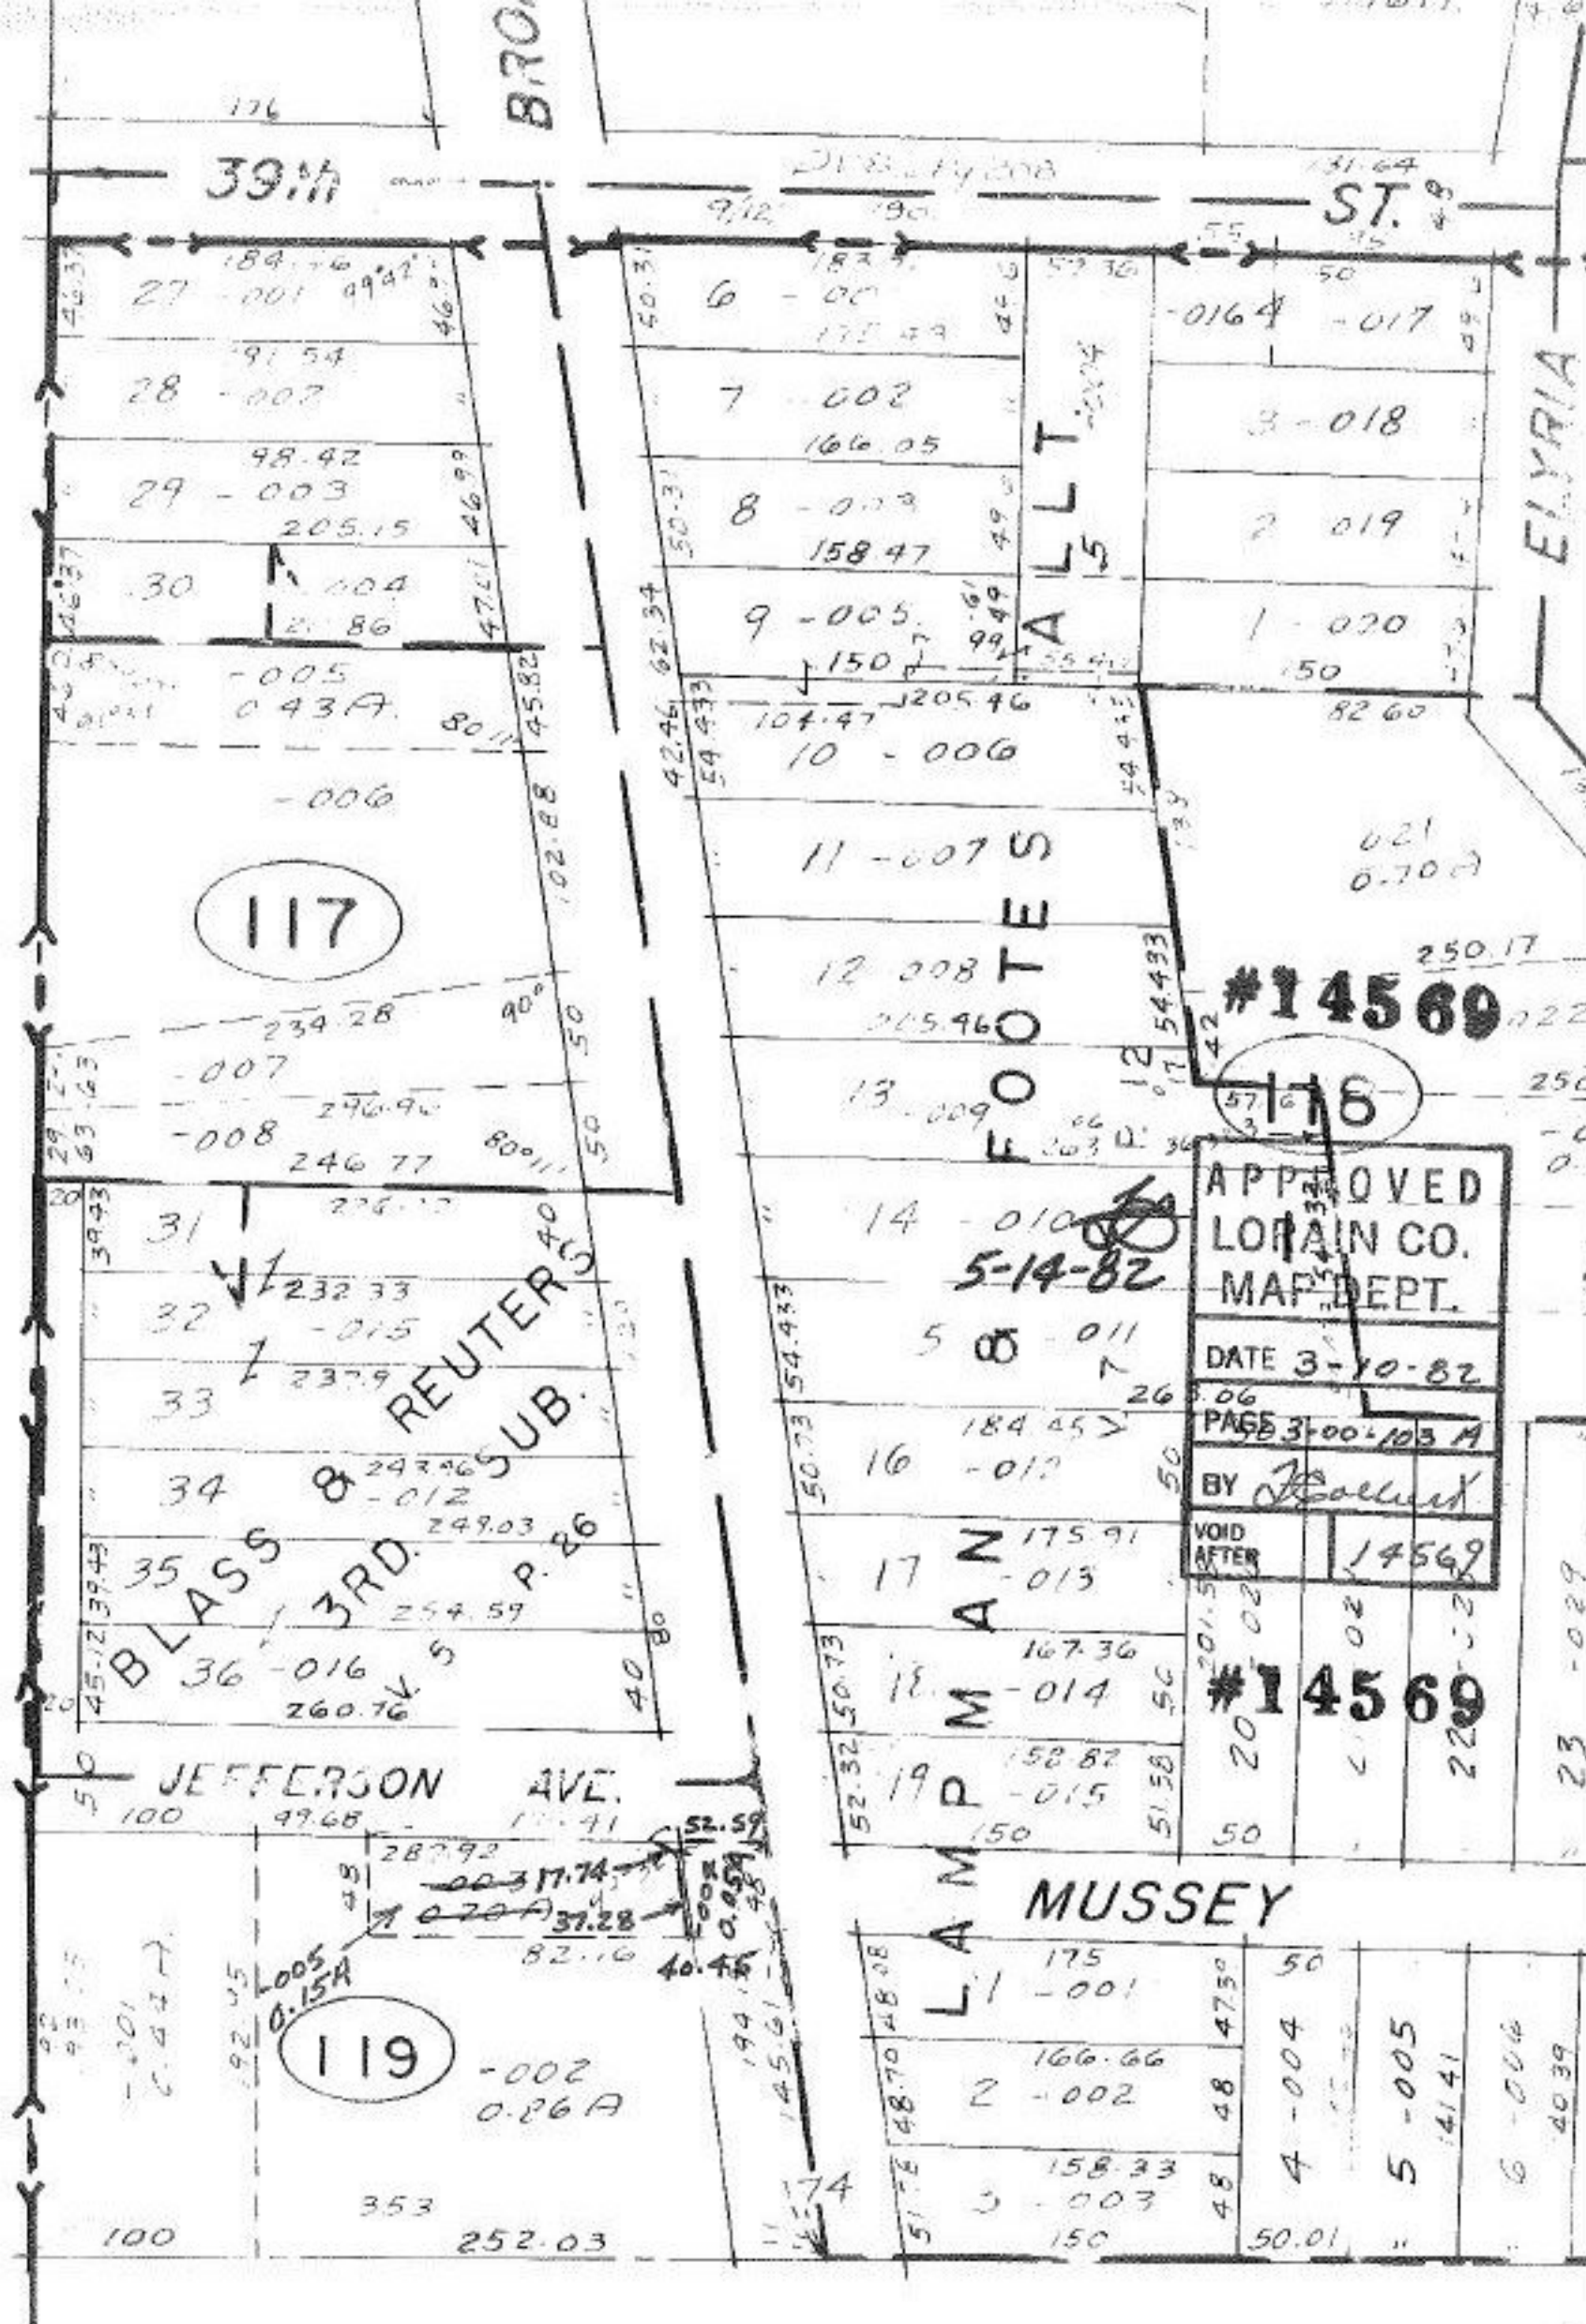

117

#14569

118

APPROVED
 LORAIN CO.
 MAP DEPT.
 DATE 3-10-82
 PAGE 3-00-103 A
 BY *[Signature]*
 VOID AFTER 14569

#14569

119

MUSSEY

LAMP

5-005

5-003

5-004

6-006

6-003

6-004

S